

N. Y. K.	
AKI — MARU	
STERN CASTING	
(FINISHED PLAN)	
DIMENSION 1400 · 190 · 105	
SCALE 1/60	CLASS 主尺
HULL DESIGNING SECTION	
SHIP DESIGNING NABASAKI	DEPARTMENT WORKS
CHIEF OF DEPT. 	
CHIEF	
HEAD <i>T. Matsuzaki</i>	
CHECKED <i>T. Kamekura</i>	
DRAWN	
DATE	REG NO.
MITSUBISHI ZOSEN TOKYO	KABUSHIKI KAISHA YOKOHAMA
SHIP NO.	1438
DSN NO.	H-114




NS-606  
FEB. 2. 1954


"Aki Maru"



RECORDS DEPT.,  
LONDON.

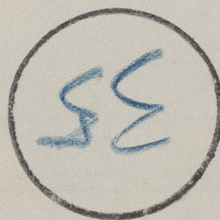

Stern casting  
(Finished plan)

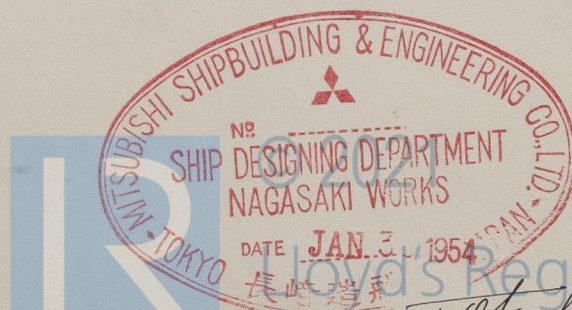

*I. Okabe*

014794-014805-0060