

# SECTION THRO HOLD

AS FITTED

SCALE:- 1" = 1 FOOT

## EQUIPMENT

1 - STOCKLESS ANCHOR - 7 CWT

1 - KEDGE ANCHOR - 4 CWT - EXSTOCK

60 - FTHS.  $\frac{7}{8}$ " DIA. STUD LINK CABLE.


## "MOONLIGHT"

HATCH COAMING  $2'6" \times \frac{3}{4}"$  AT SIDE &  $3'-0"$  AT CENTRE

" " STIFFERS  $6" \times \frac{3}{8}"$  B.P.

" " DECK ANGLE  $3" \times 2\frac{1}{2}" \times \frac{3}{4}"$

WIDTH OF HATCH  $13'-6" \times 35'-0"$  LONG

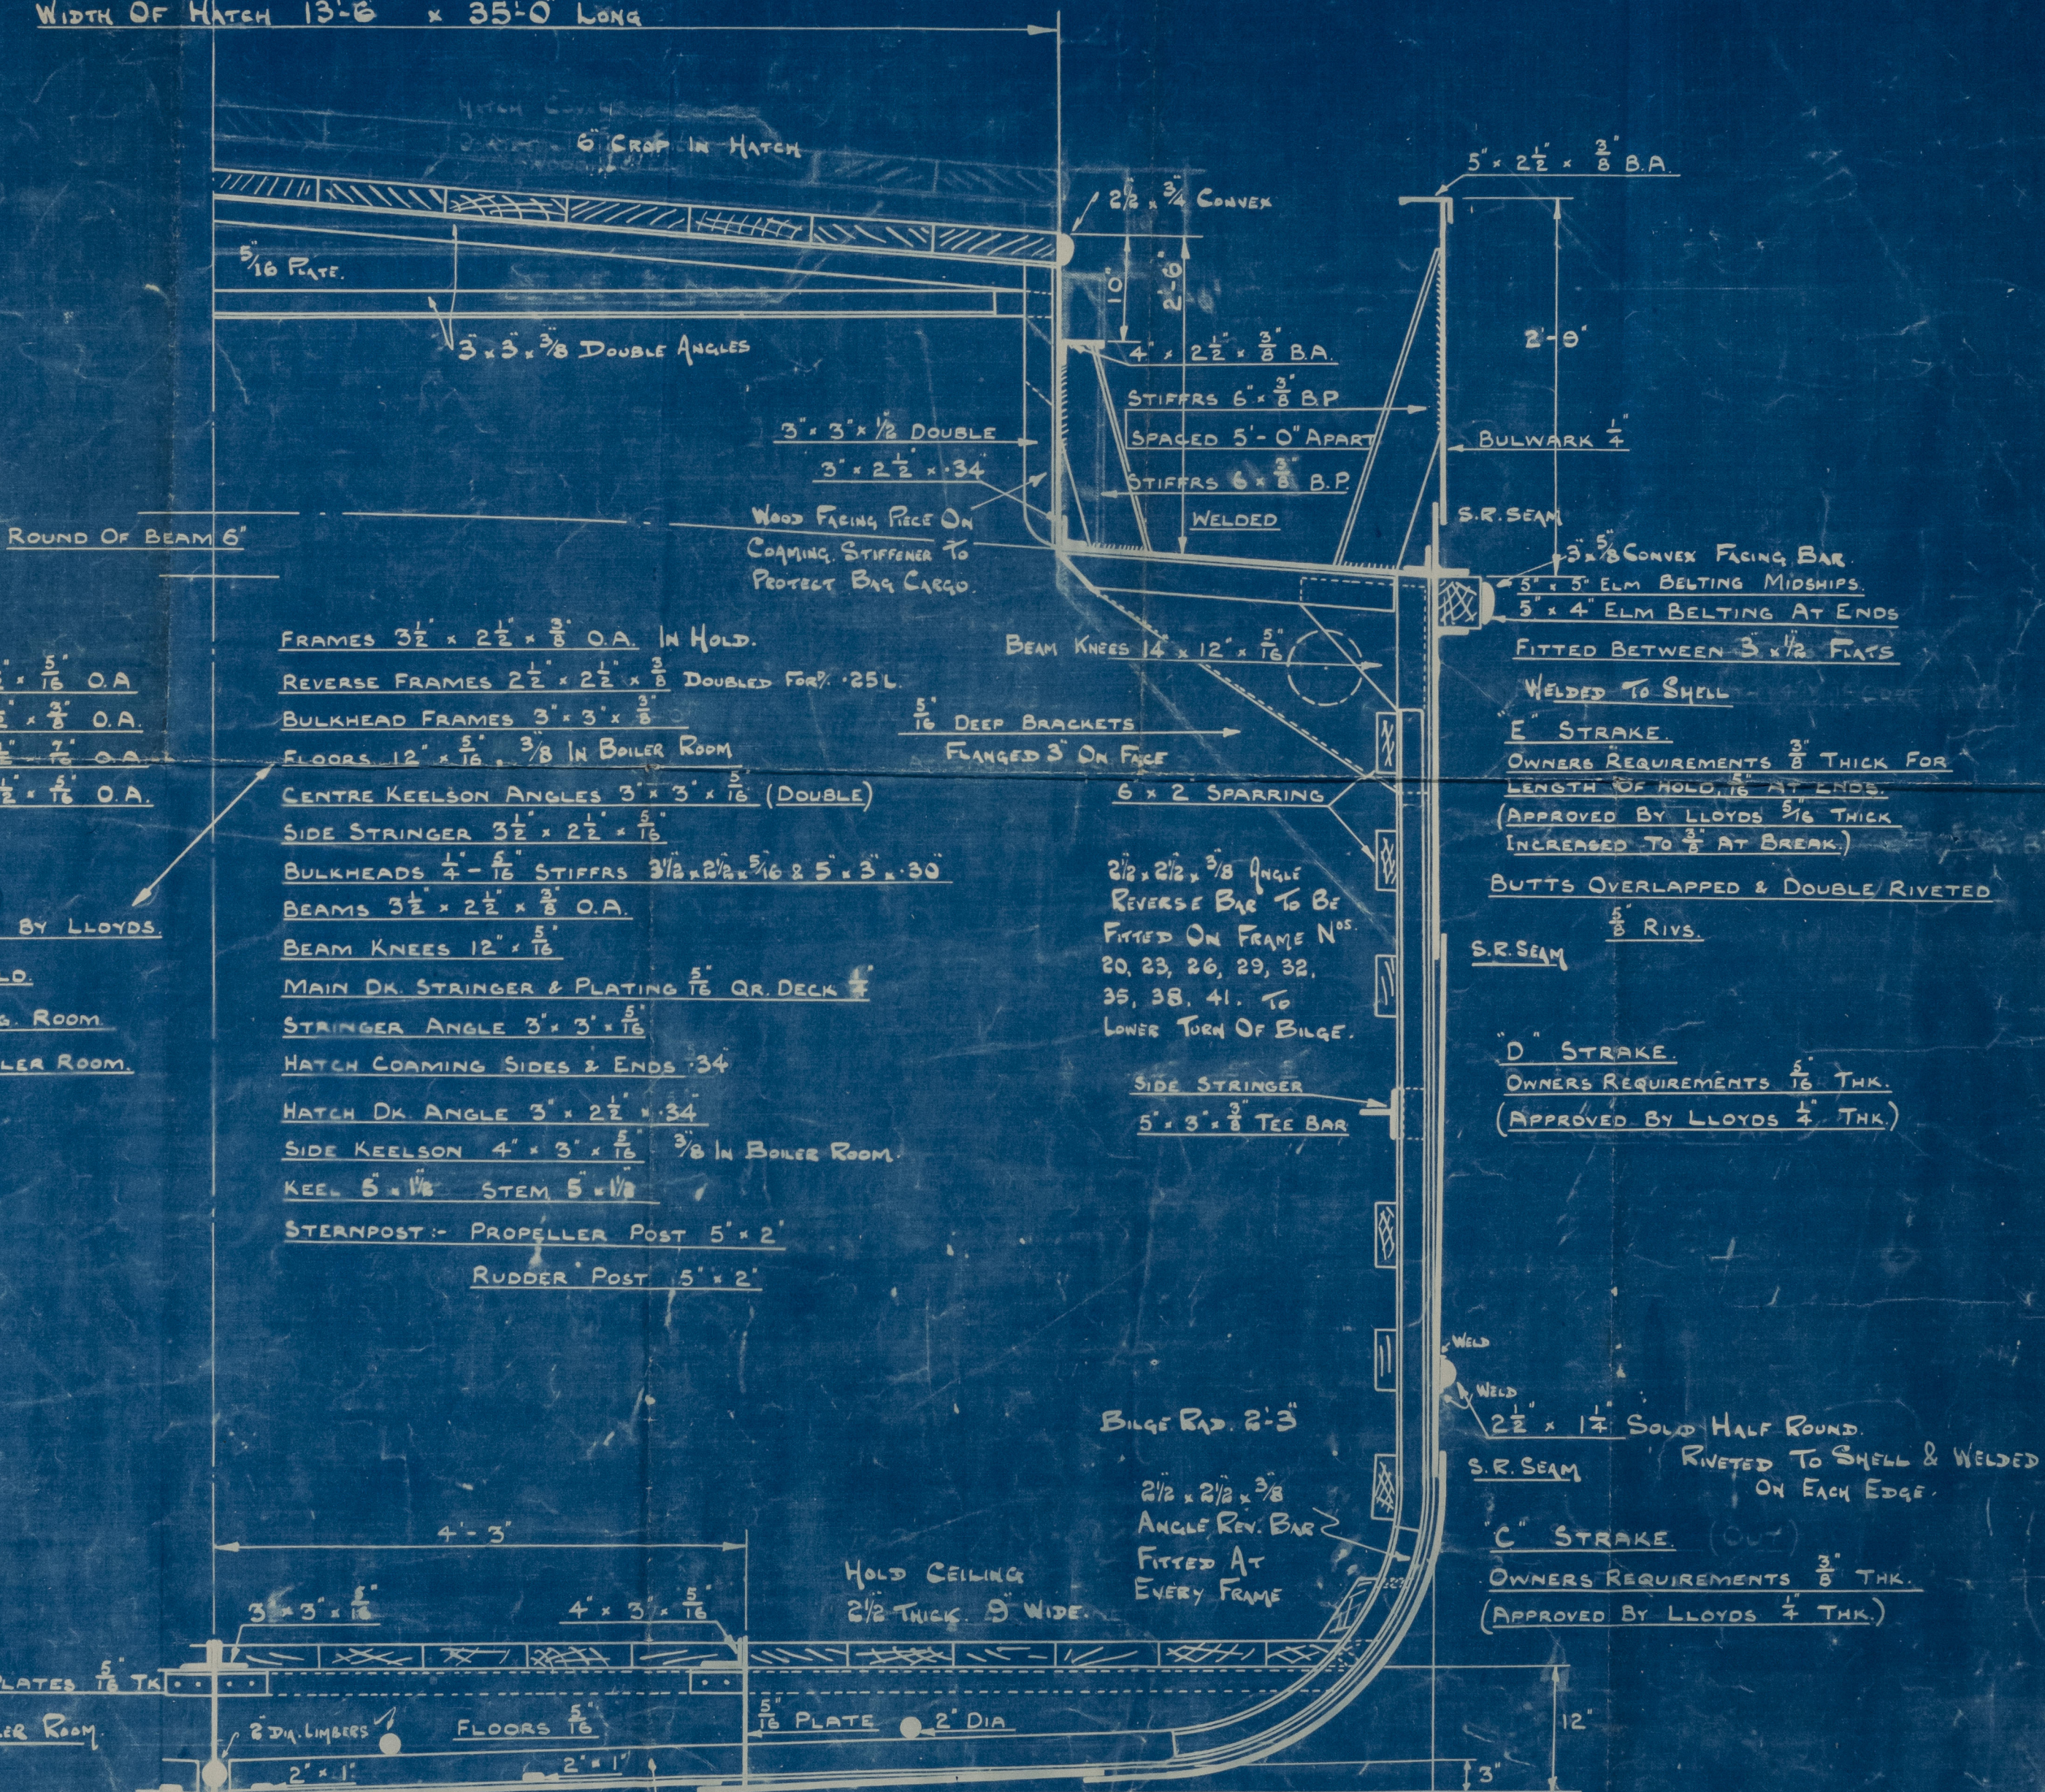

### FRAMES

PEAKS  $3\frac{1}{2}" \times 2\frac{1}{2}" \times \frac{5}{16}"$  O.A.

HOLD  $3\frac{1}{2}" \times 2\frac{1}{2}" \times \frac{3}{8}"$  O.A.

BUNKER  $1" \times 3\frac{1}{2}" \times \frac{7}{8}"$  O.A.

ENG. ROOM  $4" \times 2\frac{1}{2}" \times \frac{7}{8}"$  O.A.

FLOORS APPROVED BY LLOYDS.

$\frac{7}{8}"$  THICK IN HOLD.

$\frac{5}{16}"$  " " ENG. ROOM.

$\frac{3}{8}"$  " " BOILER ROOM.

FRAMES  $3\frac{1}{2}" \times 2\frac{1}{2}" \times \frac{3}{8}"$  O.A. IN HOLD.

REVERSE FRAMES  $2\frac{1}{2}" \times 2\frac{1}{2}" \times \frac{3}{8}"$  DOUBLED FOR  $\frac{1}{2}"$  25L.

BULKHEAD FRAMES  $3" \times 3" \times \frac{3}{8}"$

FLOORS  $12" \times \frac{5}{16}"$   $\frac{3}{8}"$  IN BOILER ROOM.

CENTRE KEELSON ANGLES  $3" \times 3" \times \frac{5}{16}"$  (DOUBLE)

SIDE STRINGER  $3\frac{1}{2}" \times 2\frac{1}{2}" \times \frac{5}{16}"$

BULKHEADS  $\frac{1}{4}" - \frac{5}{16}"$  STIFFERS  $3\frac{1}{2}" \times 2\frac{1}{2}" \times \frac{5}{16}"$  &  $5" \times 3" \times \frac{3}{8}"$

BEAMS  $3\frac{1}{2}" \times 2\frac{1}{2}" \times \frac{3}{8}"$  O.A.

BEAM KNEES  $12" \times \frac{5}{16}"$

MAIN DK. STRINGER & PLATING  $\frac{5}{16}"$  QR. DECK  $\frac{1}{4}"$

STRINGER ANGLE  $3" \times 3" \times \frac{5}{16}"$

HATCH COAMING SIDES & ENDS  $\frac{3}{4}"$

HATCH DK. ANGLE  $3" \times 2\frac{1}{2}" \times \frac{3}{4}"$

SIDE KEELSON  $4" \times 3" \times \frac{5}{16}"$   $\frac{3}{8}"$  IN BOILER ROOM.

KEEL  $5" \times \frac{1}{2}"$  STEM  $5" \times \frac{1}{2}"$

STERNPOST:- PROPELLER POST  $5" \times 2"$

RUDDER POST  $5" \times 2"$

INTERCOSTAL PLATES  $\frac{5}{16}"$  THK.

$\frac{3}{8}"$  THICK IN BOILER ROOM.

KEEL BARS  $5" \times \frac{1}{2}"$

WELDED BUTTS

### DIMENSIONS

LENGTH B.P.  $85'-6"$

BREADTH MLD.  $19'-6"$

DEPTH MLD.  $10'-0"$

### "A" STRAKE

$\frac{5}{16}"$  THK INCREASED TO

$\frac{3}{8}"$  FOR  $\frac{1}{2}"$  OF  $\frac{1}{2}"$  25 L FROM STEM.

$\frac{3}{8}"$  FOR  $\frac{1}{2}"$  OF

$\frac{1}{2}"$  25 L FROM STEM.

"A" STRAKE BUTTS

TO BE WELDED

### "B" STRAKE

OWNERS REQ.  $\frac{5}{16}"$  THK.

(APPROVED BY LLOYDS  $\frac{3}{8}"$  THK.)

BOTTOM FRAME ANGLES

DOUBLED FOR  $\frac{1}{2}"$  25L.

STEM

NO. 36-37 & 45-46

PRINT NO. 1217

DATE 23-5-52

W. J. YARWOOD & SONS LTD.

SHIPBUILDERS

ENGINEERS and

IRONFOUNDERS

THE DOCK, NORTHWICH

RE SUBMITTED & APPROVED BY LLOYDS 16-8-51

APPROVED BY LLOYDS 9-4-51

W. J. YARWOOD & SONS LTD.

THE DOCK.

NORTHWICH.

DATE: 1-2-51

SHIP NO 878

DRG NO 7216 A

DRAWN BY K. CHECKED BY

TRACED BY P.S. INDEXED BY



Away.

014827-014834-0106


'MOONLIGHT'



Section through hole

(as fitted)

RECORDS DEPT  
LONDON

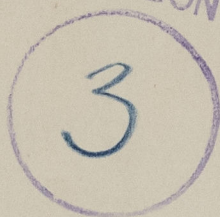

© 2021

Lloyd's Register  
Foundation

014827-014834-0106