


A x D = 21 x 142

= 30

NO. ON DRG	DESCRIPTION	NO. OFF	MAT.
1	STERNFRAME	1	FORGED STEEL
2	RUDDER STOCK IN 2 LENGTHS	1	FORGED STEEL
3	RUDDER BRACE (SPLIT)	2	FORGED STEEL
4	HARDENED STEEL BUTTON & BUSH	1	STEEL
5	QUADRANT ARM BORED AND KEYED READY FOR STOCK	1	FORGED STEEL
6	RUDDER STOCK TOP LENGTH M/C READY TO RECEIVE COUPLING & QUADRANT	1	FORGED STEEL


ALL TO BE PASSED BY LLOYDS & THEIR CERTIFICATE TO BE SUPPLIED.

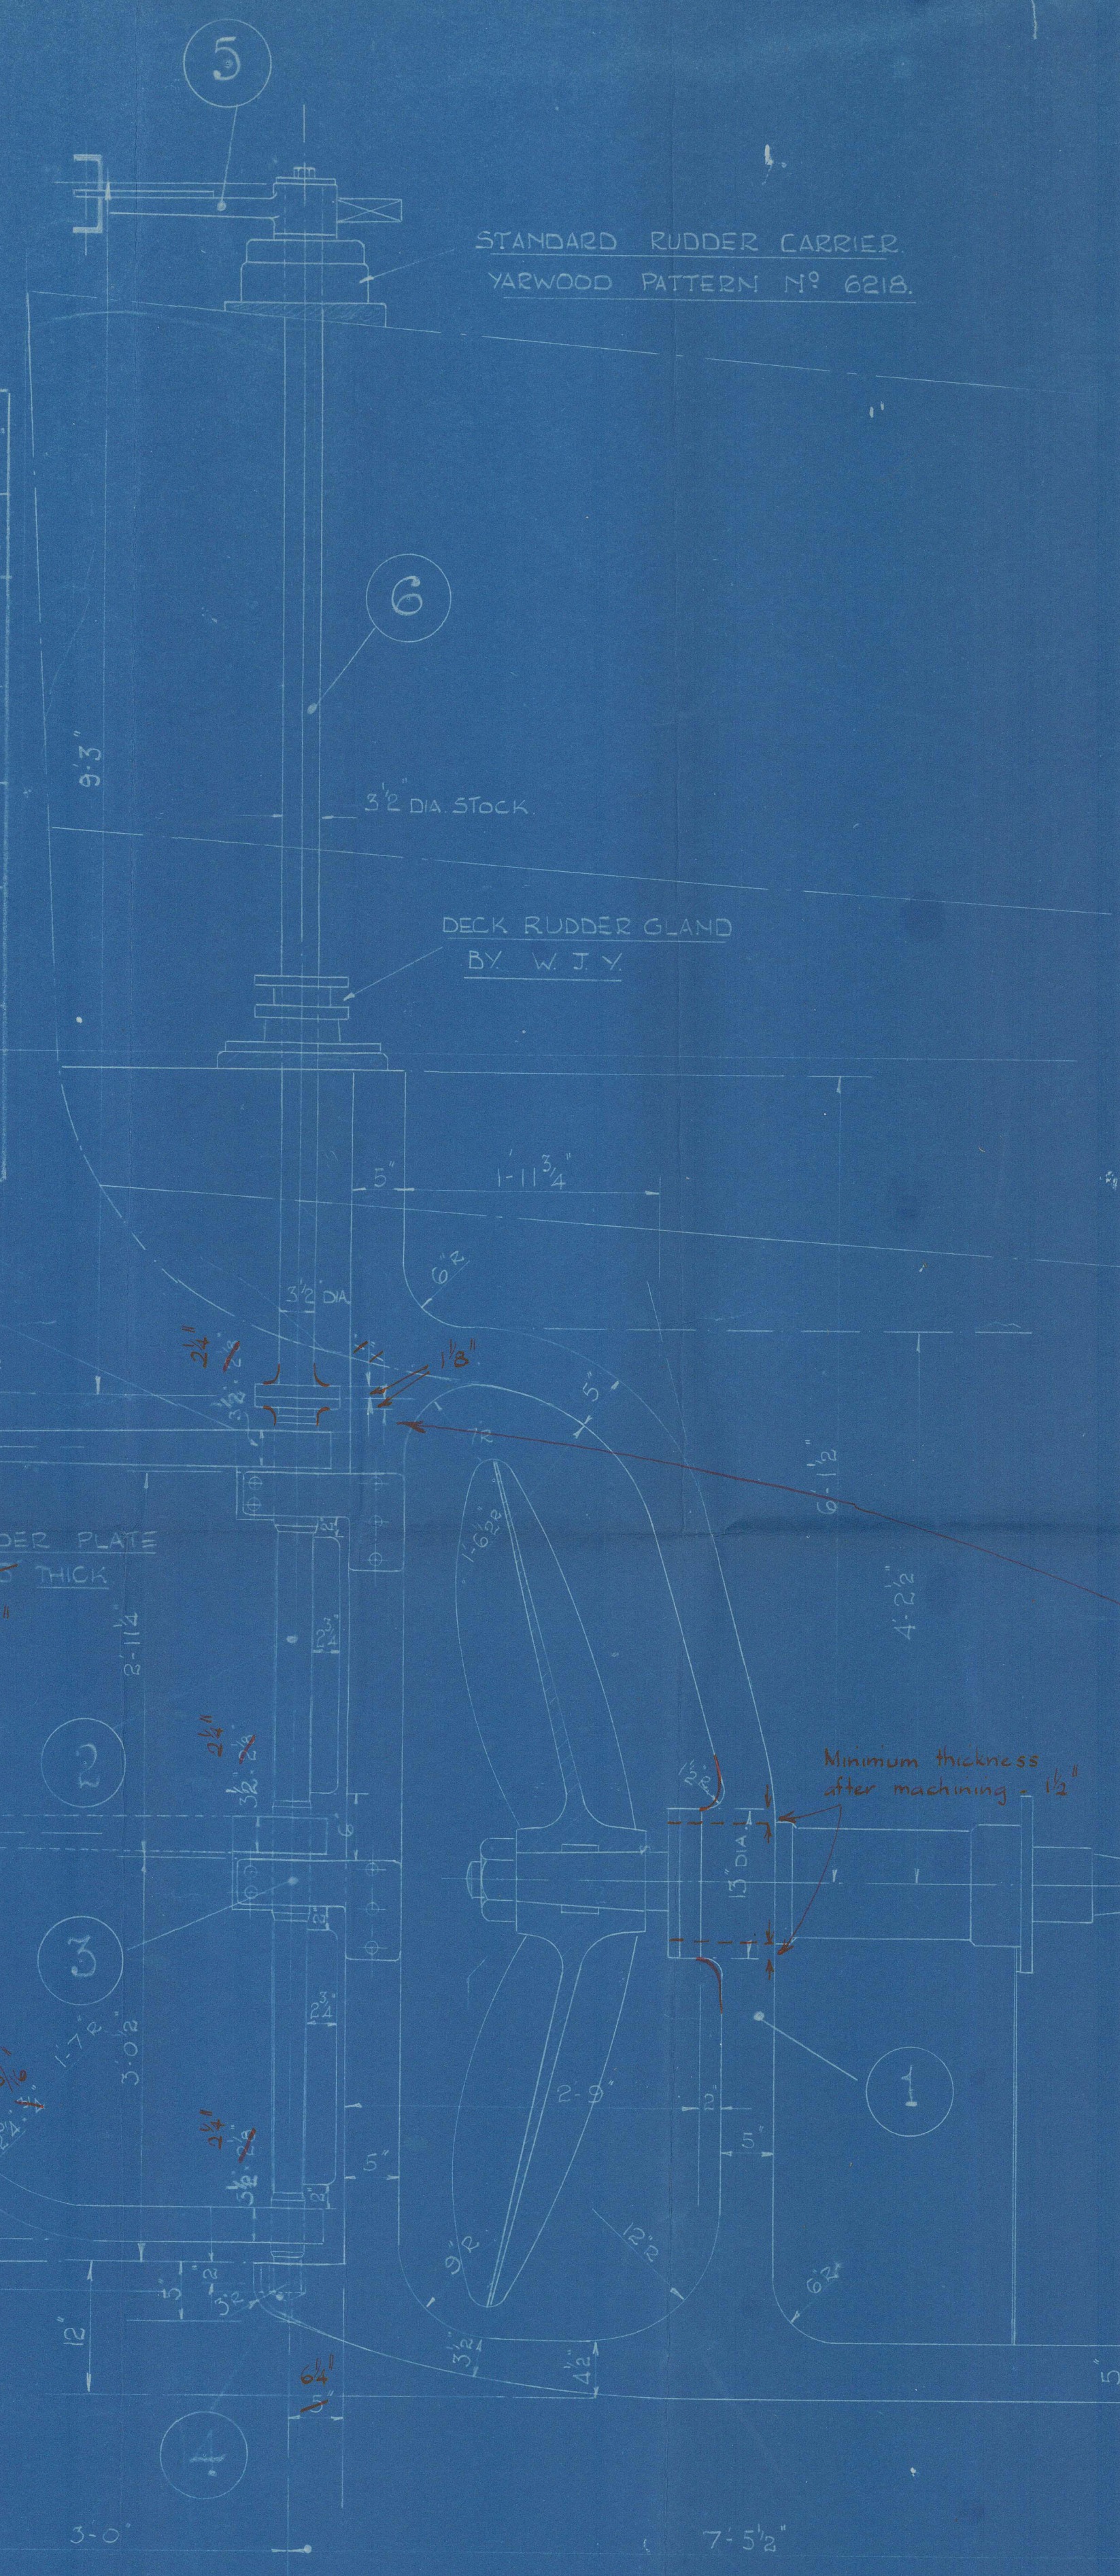

### DETAIL OF TOP ARM.


SCALE: 3\"/>

MAT: MILD STEEL FORGING.

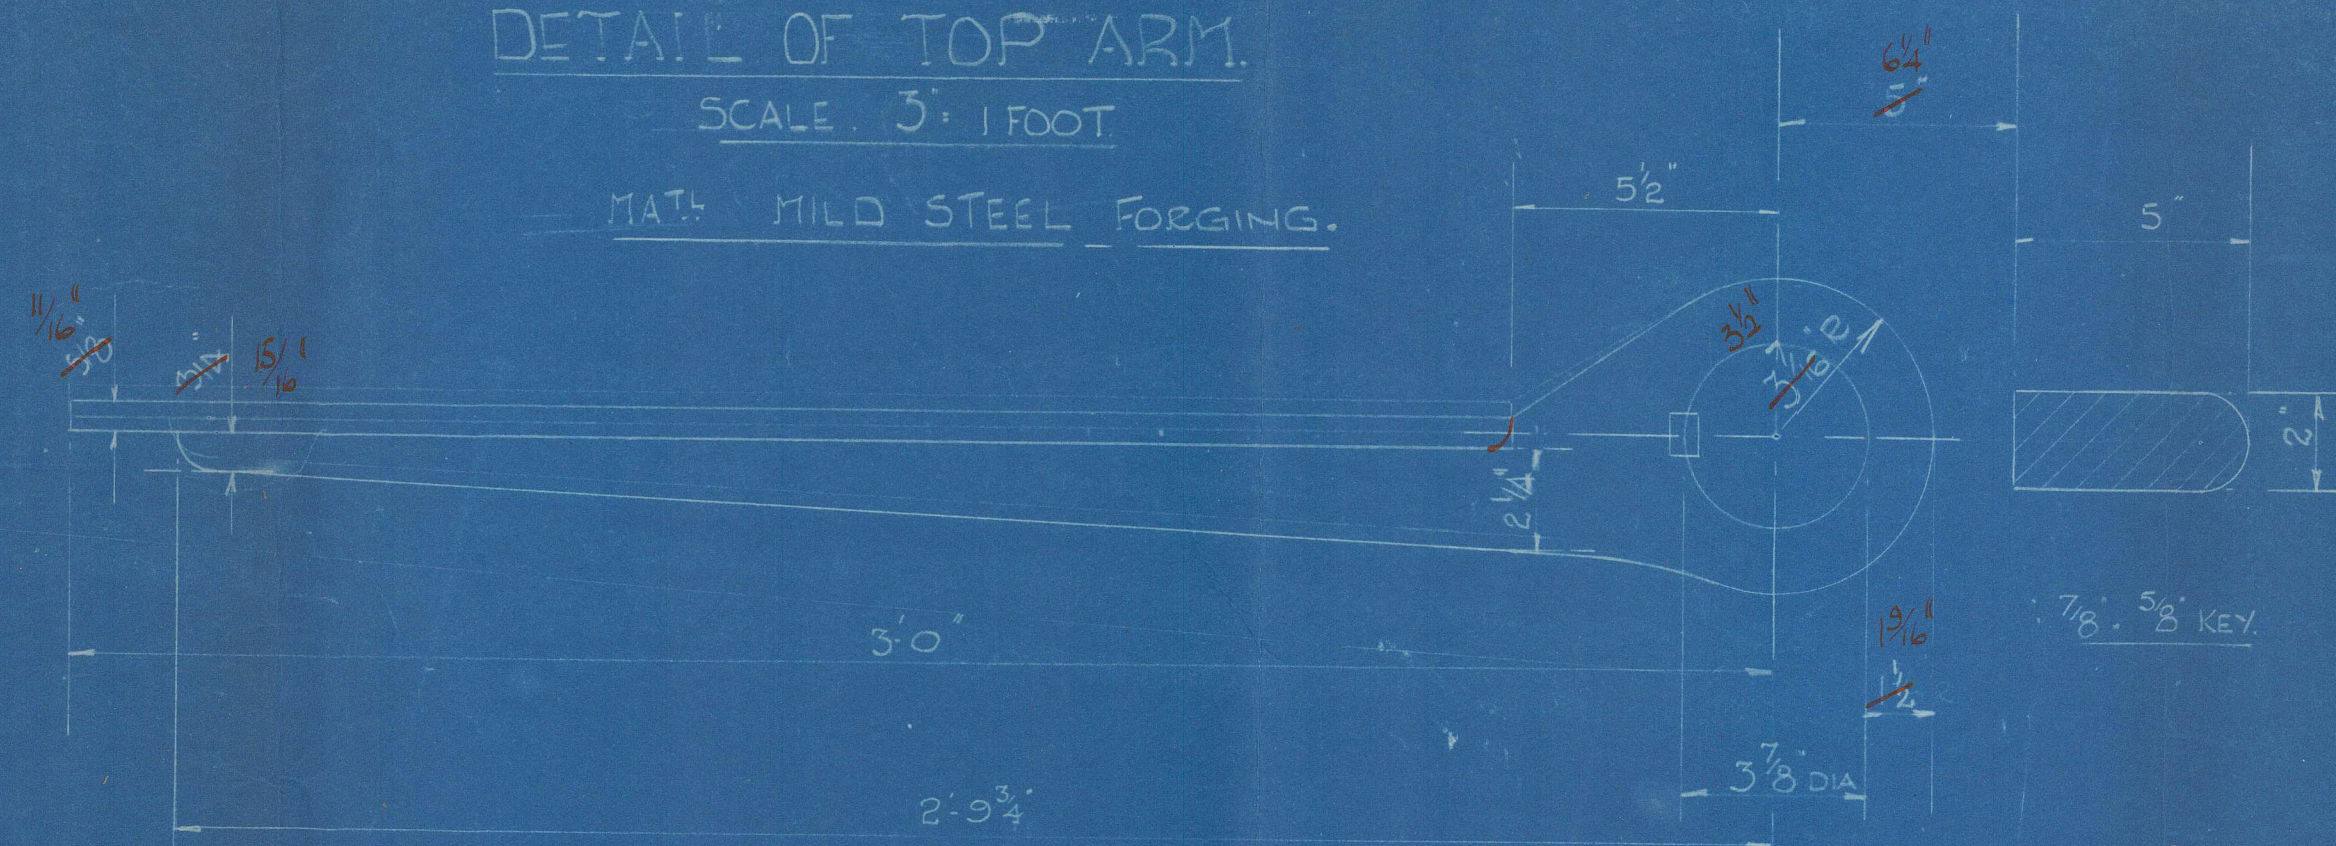


### DETAIL OF CENTRE ARM.

MAT: MILD STEEL FORGING.

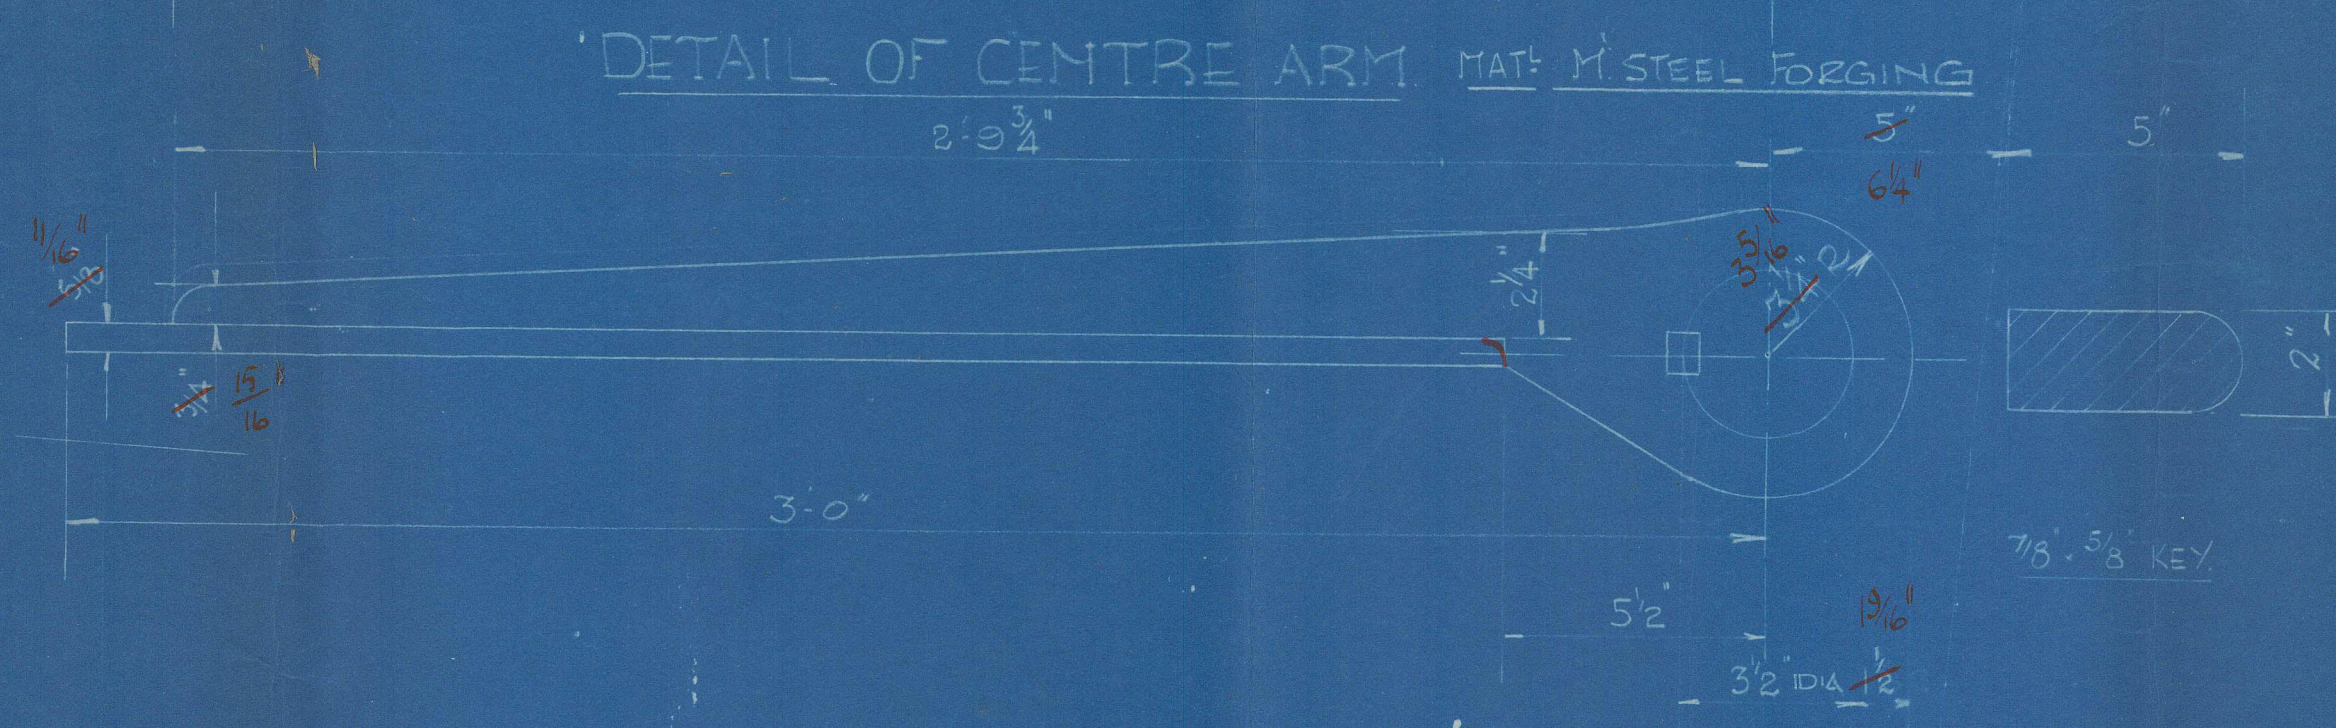



### DETAIL OF BOTTOM ARM.

MAT: MILD STEEL FORGING.

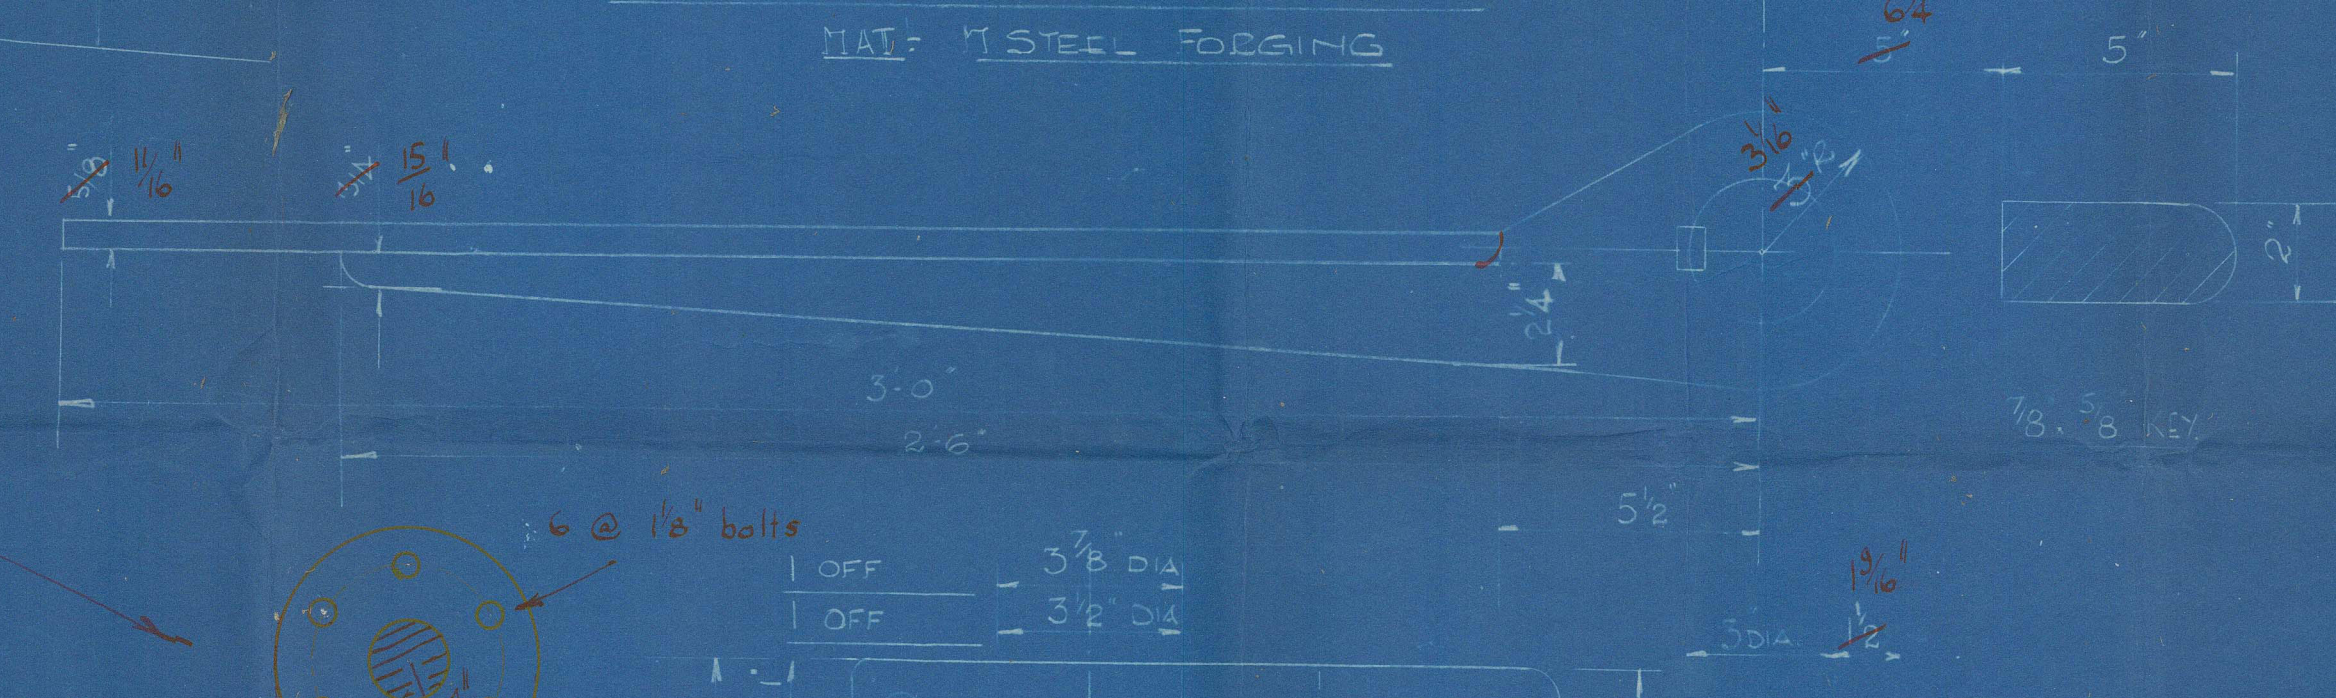


### DETAIL OF STEERING QUADRANT.

MILD STEEL FORGING.

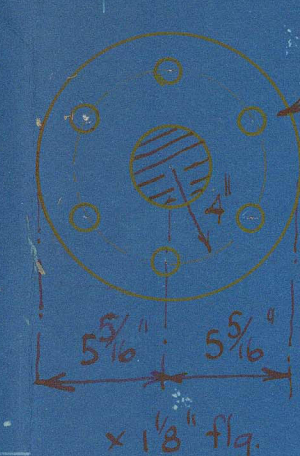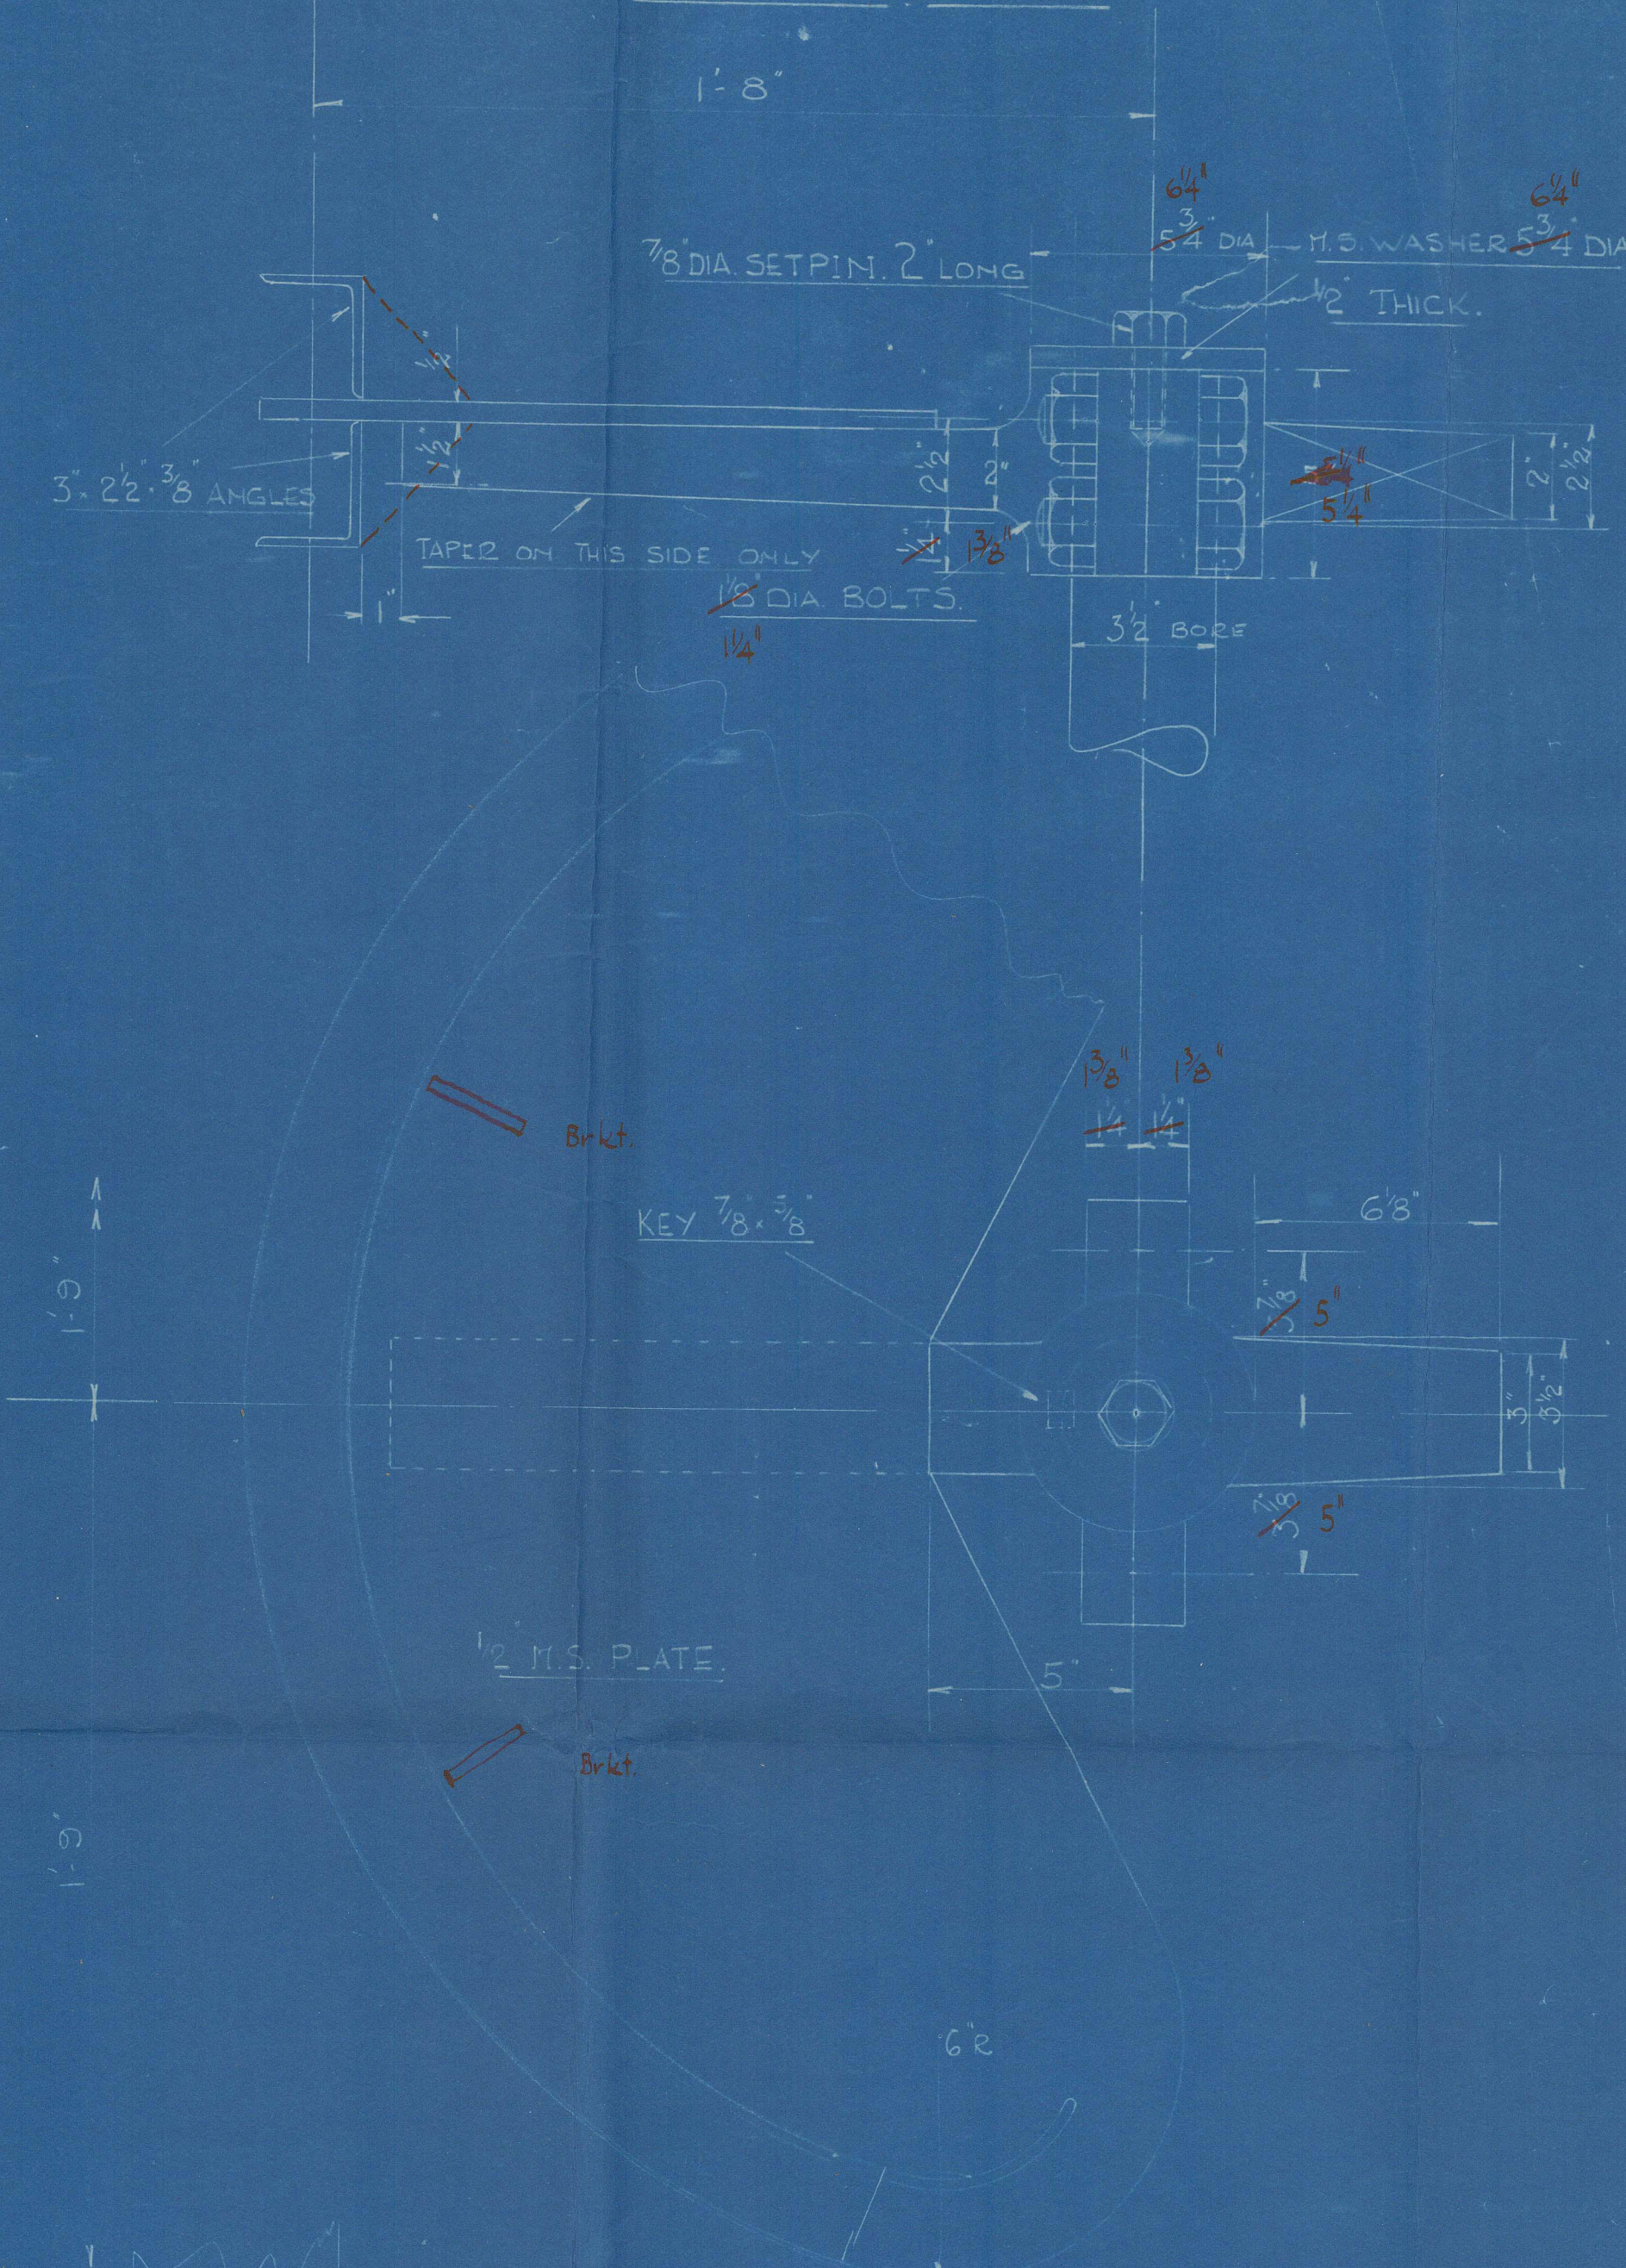

RUDDER COUPLING

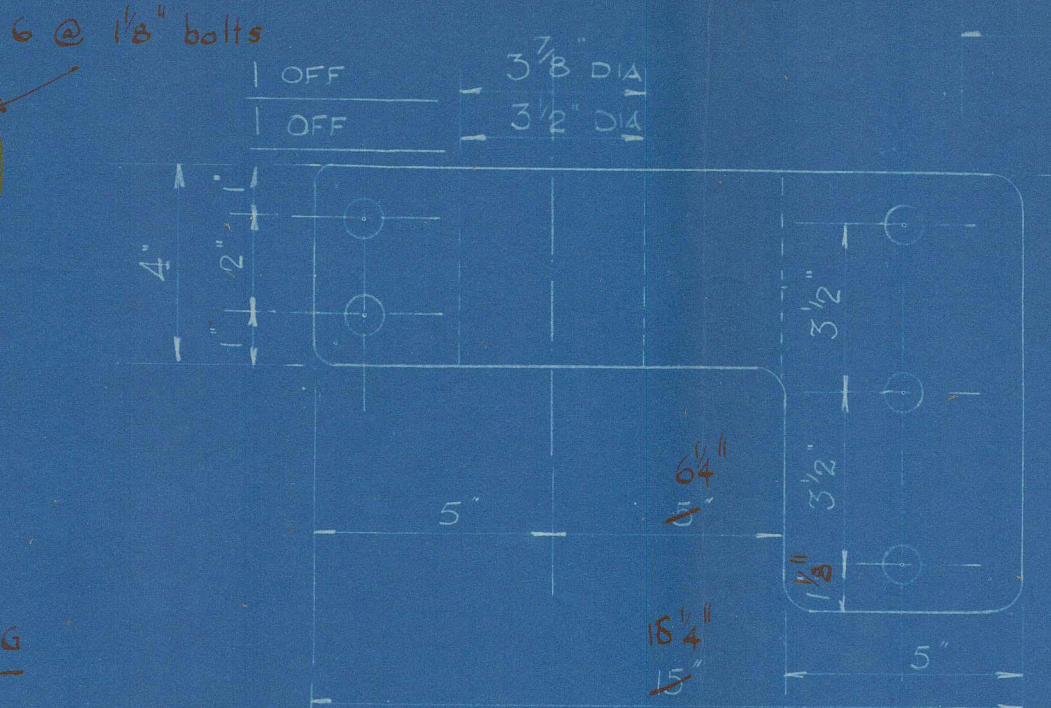

### DETAIL OF SPLIT BRACE.

MILD STEEL FORGING.

ONE OFF 3\"/>

ONE OFF 3\"/>

### DETAIL OF RUDDER STOCK HEE.

CASE HARDENED STEEL BUTTON.

1\"/>

1\"/>

3\"/>

3\"/>

### STERNFRAME AND RUDDER DETAILS

SHIP NO. 878

SERVICE SPEED 8 KNOTS

PRINT 5079

DATE 1-11-51

MESSRS W.J. YARWOOD & SONS LTD  
NORTHWICH, CHES.

SHIP NO 878

DRG NO 7241.

DRAWN: HSR.

TRACED: —

DATE: 6.3.51.

INCHES: HSR.

FOOTING: —

LLOYD'S REGISTER

FOUNDATION



W J Yarwood & Son. Ltd  
Yard No 878

ss Moonlight ★

Rudder + Stern frame

Rudder + stern frame.

RECORDS DEPT.,  
LONDON

7



© 2021

Lloyd's Register  
Foundation

014 827 214834-0108



0108

878



© 2021

Lloyd's Register  
Foundation