

SHIP No 481.
PROFILE & DECKS.


SCALE $\frac{1}{4}'' = 1 \text{ FOOT}$.
RIVER & ESTUARY TANKER

DIMENSIONS
LENGTH OVERALL - 171'-4" LENGTH B.P. - 162'-0"
BREADTH MOULDED - 33'-0" DEPTH MOULDED - 10'-6" (R.Q. DECK 1'-6")
TO LLOYD'S CLASS AI +, 'OIL TANKER, FP ABOVE 150°F.
FOR SERVICE ON THE RIVER THAMES & TO COLCHESTER'
MOT & PLA REQUIREMENTS TO BE THE RESPONSIBILITY OF THE BUILDERS

ALL SCANTLINGS SPECIFIED BY OWNERS.

NOTES - MASTS, WINDLASS, CAPSTAN, STEERING GEAR,
DECKHOUSES, SUPPORTED TO SURVEYORS SATISFACTION.

PLANS SUBMITTED SEPARATELY.
STRUCTURAL SECTIONS
BOTTOM FABRICATION
FRAMING PLANS
SHELL PLAN
W.T. & O.T. BULKHEADS
ENGINE CASING & DECKHOUSES

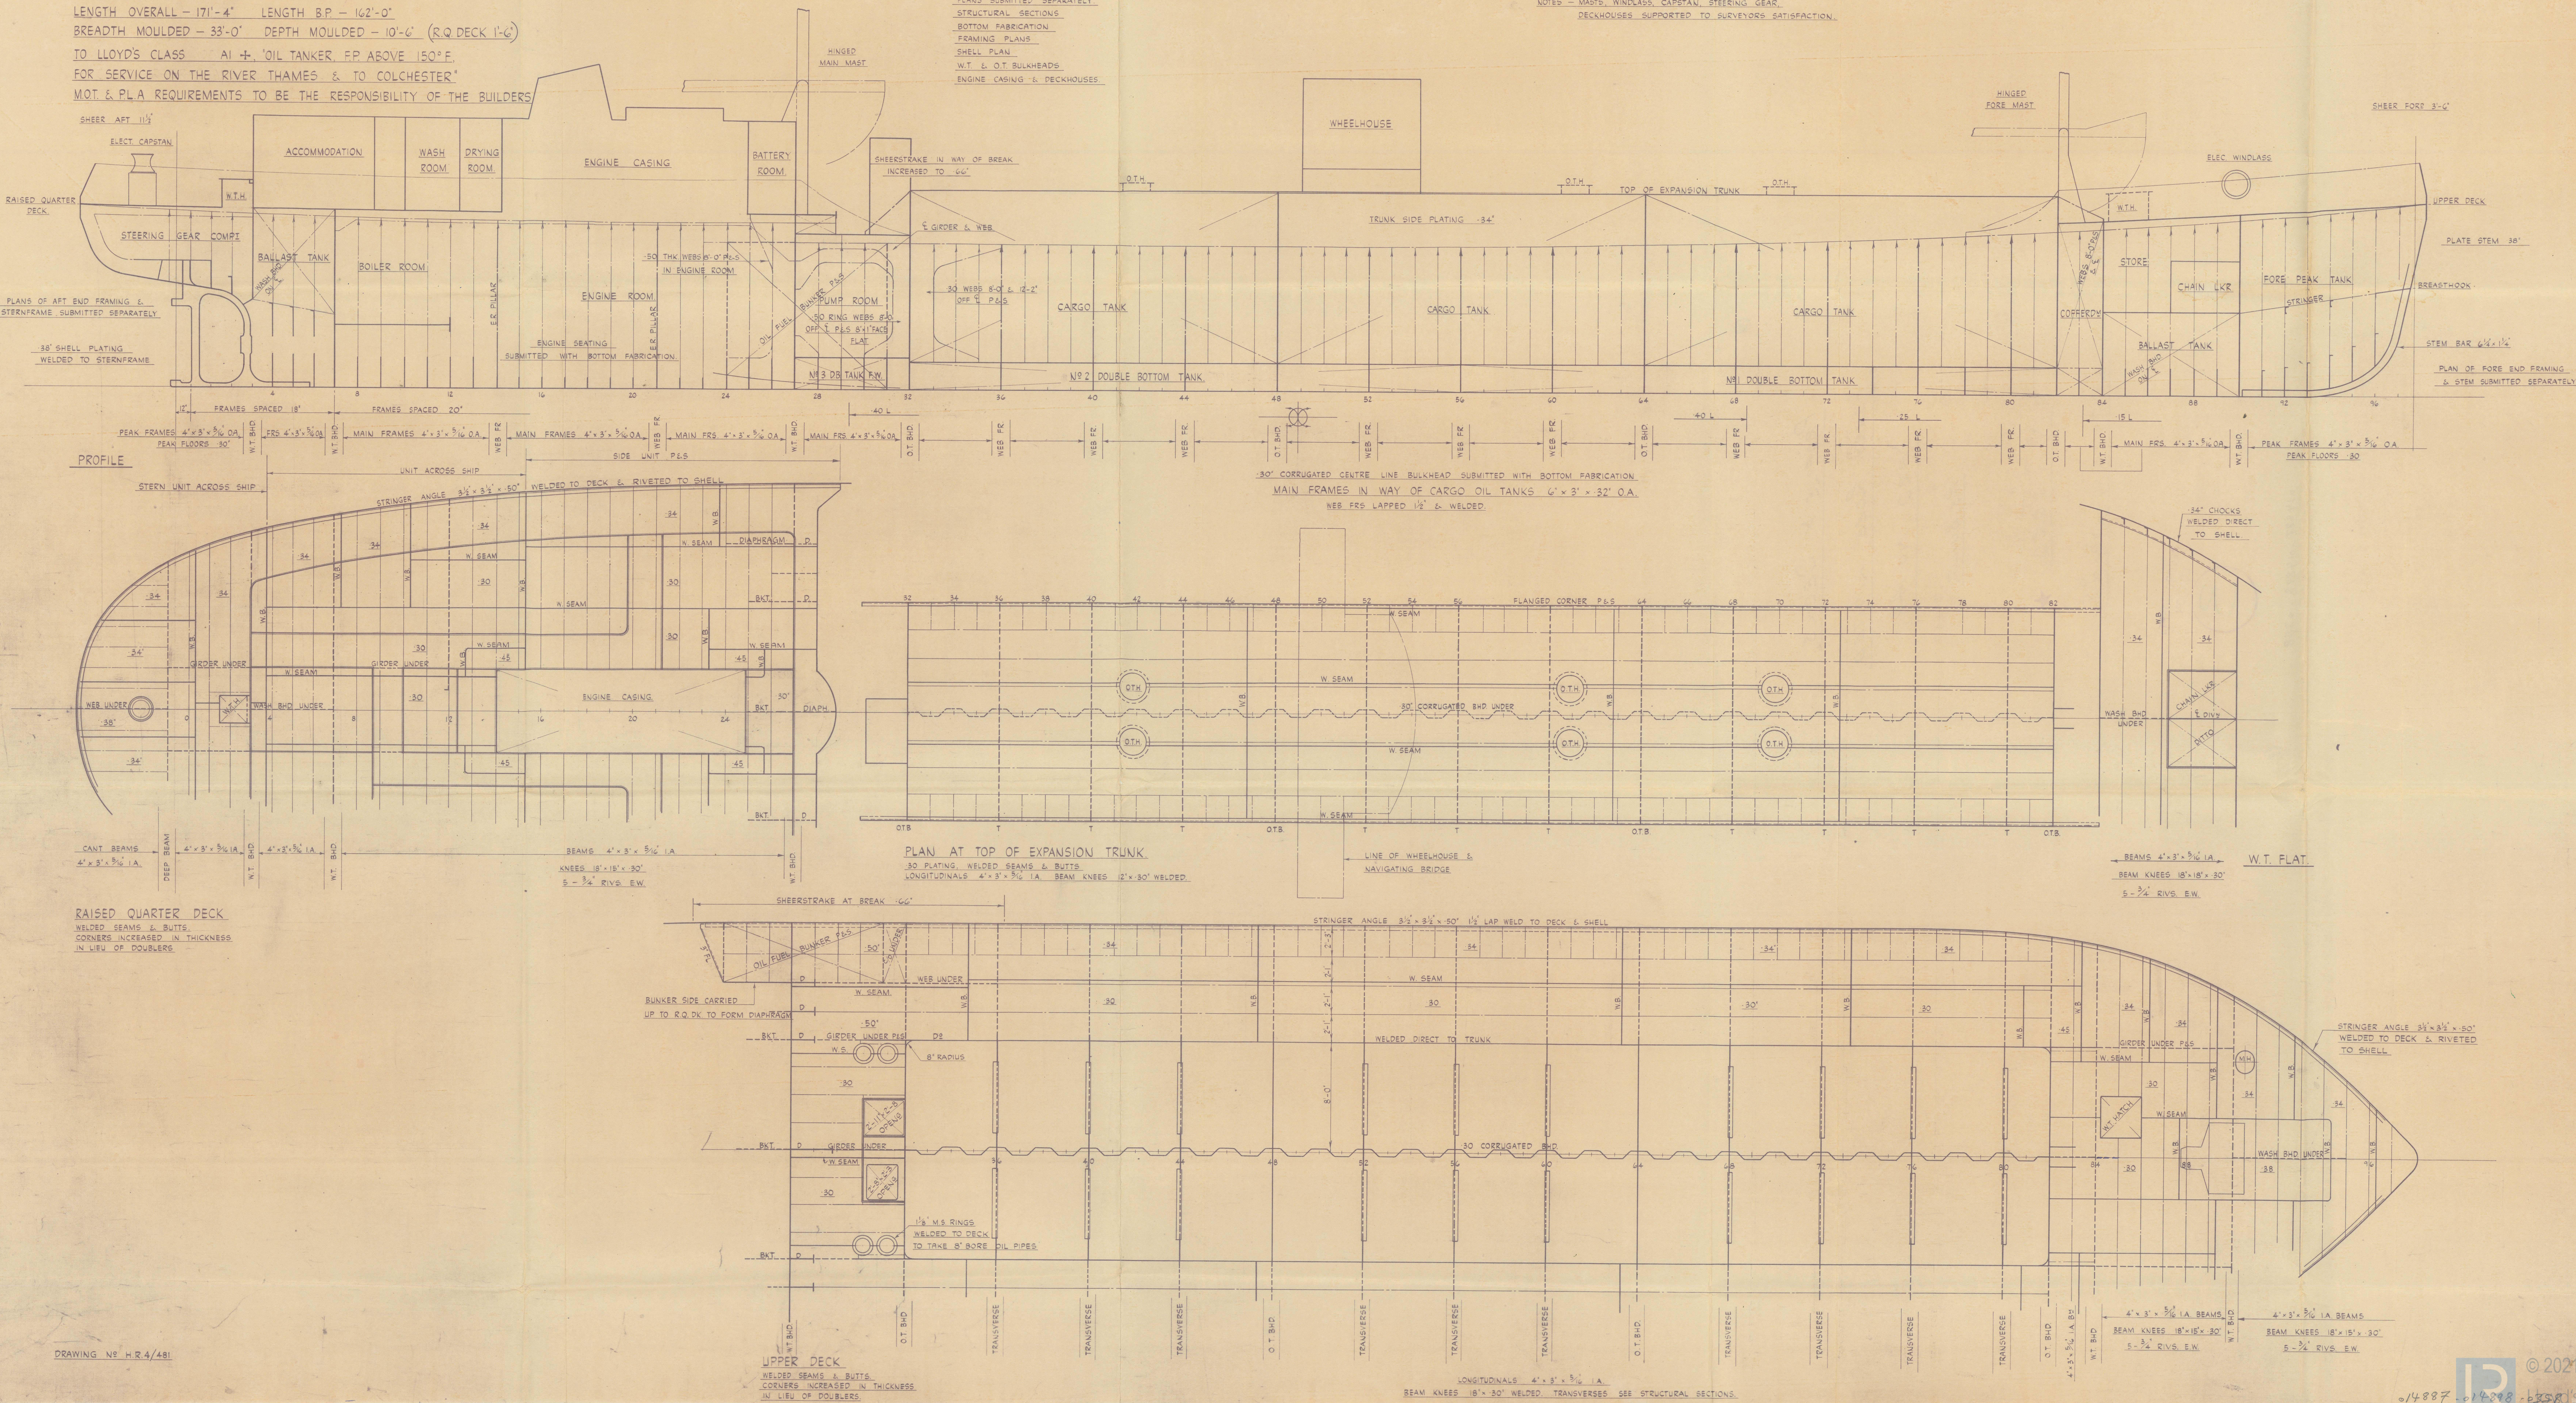


PROFILE & DECKS.

HENRY ROBB LIMITED.

YARD No. 481.

"AS. BUILT."

M.T. "TORO." ★

LEITH RPT. No. 25047.

RECORDS DEPT.
LONDON



© 2021

Lloyd's Register
Foundation 

014887 - 014898 - 0358