


157 "AS ERECTED"  
N<sup>o</sup>s 150/161. (12 CRAFT) DIMENSIONS - 190'-0" L.W.L. x 30'-0" B.DTH. MLD. x 12'-6" DPTH. MLD.

MAIN DECK. APPROVED BY LLOYDS 5:8:49.

SCALES - 1/4" = 1 FOOT & AS MARKED.

SIDE FRAMES, ALL 6"x3"x27" B.A.s., SPACED 24" APART THROUGHOUT.

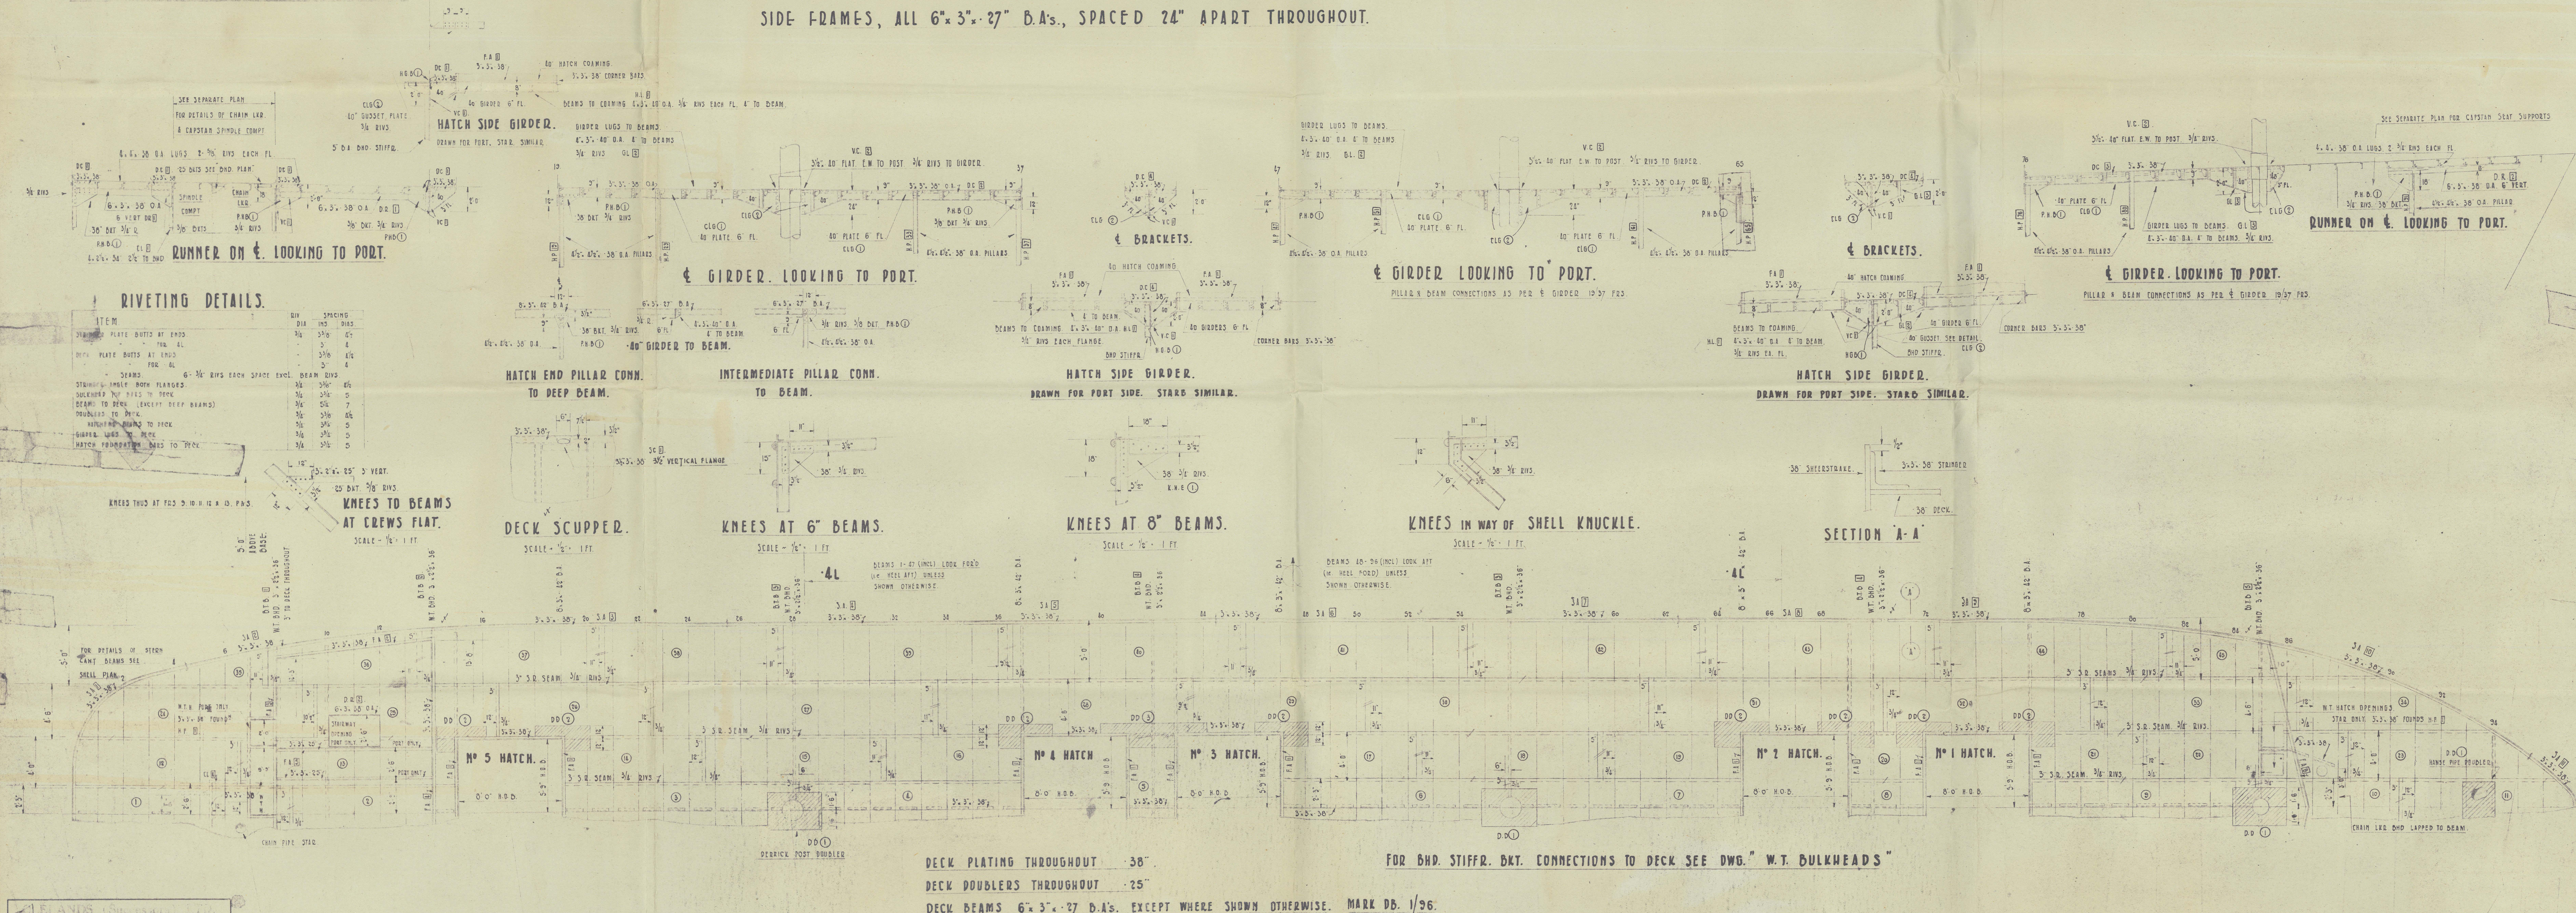




CLELANDS (SUCCESSORS) LTD.

Yard No 157 Chitra ★

Main Deck (its erected).

NEWCASTLE-ON-TYNE, No. 108109.

RECORDS DEPT.,  
LONDON

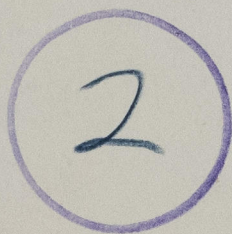

014899-014911-0141



© 2021

Lloyd's Register  
Foundation