



SCALE ~ 1/8" = 1 FOOT.

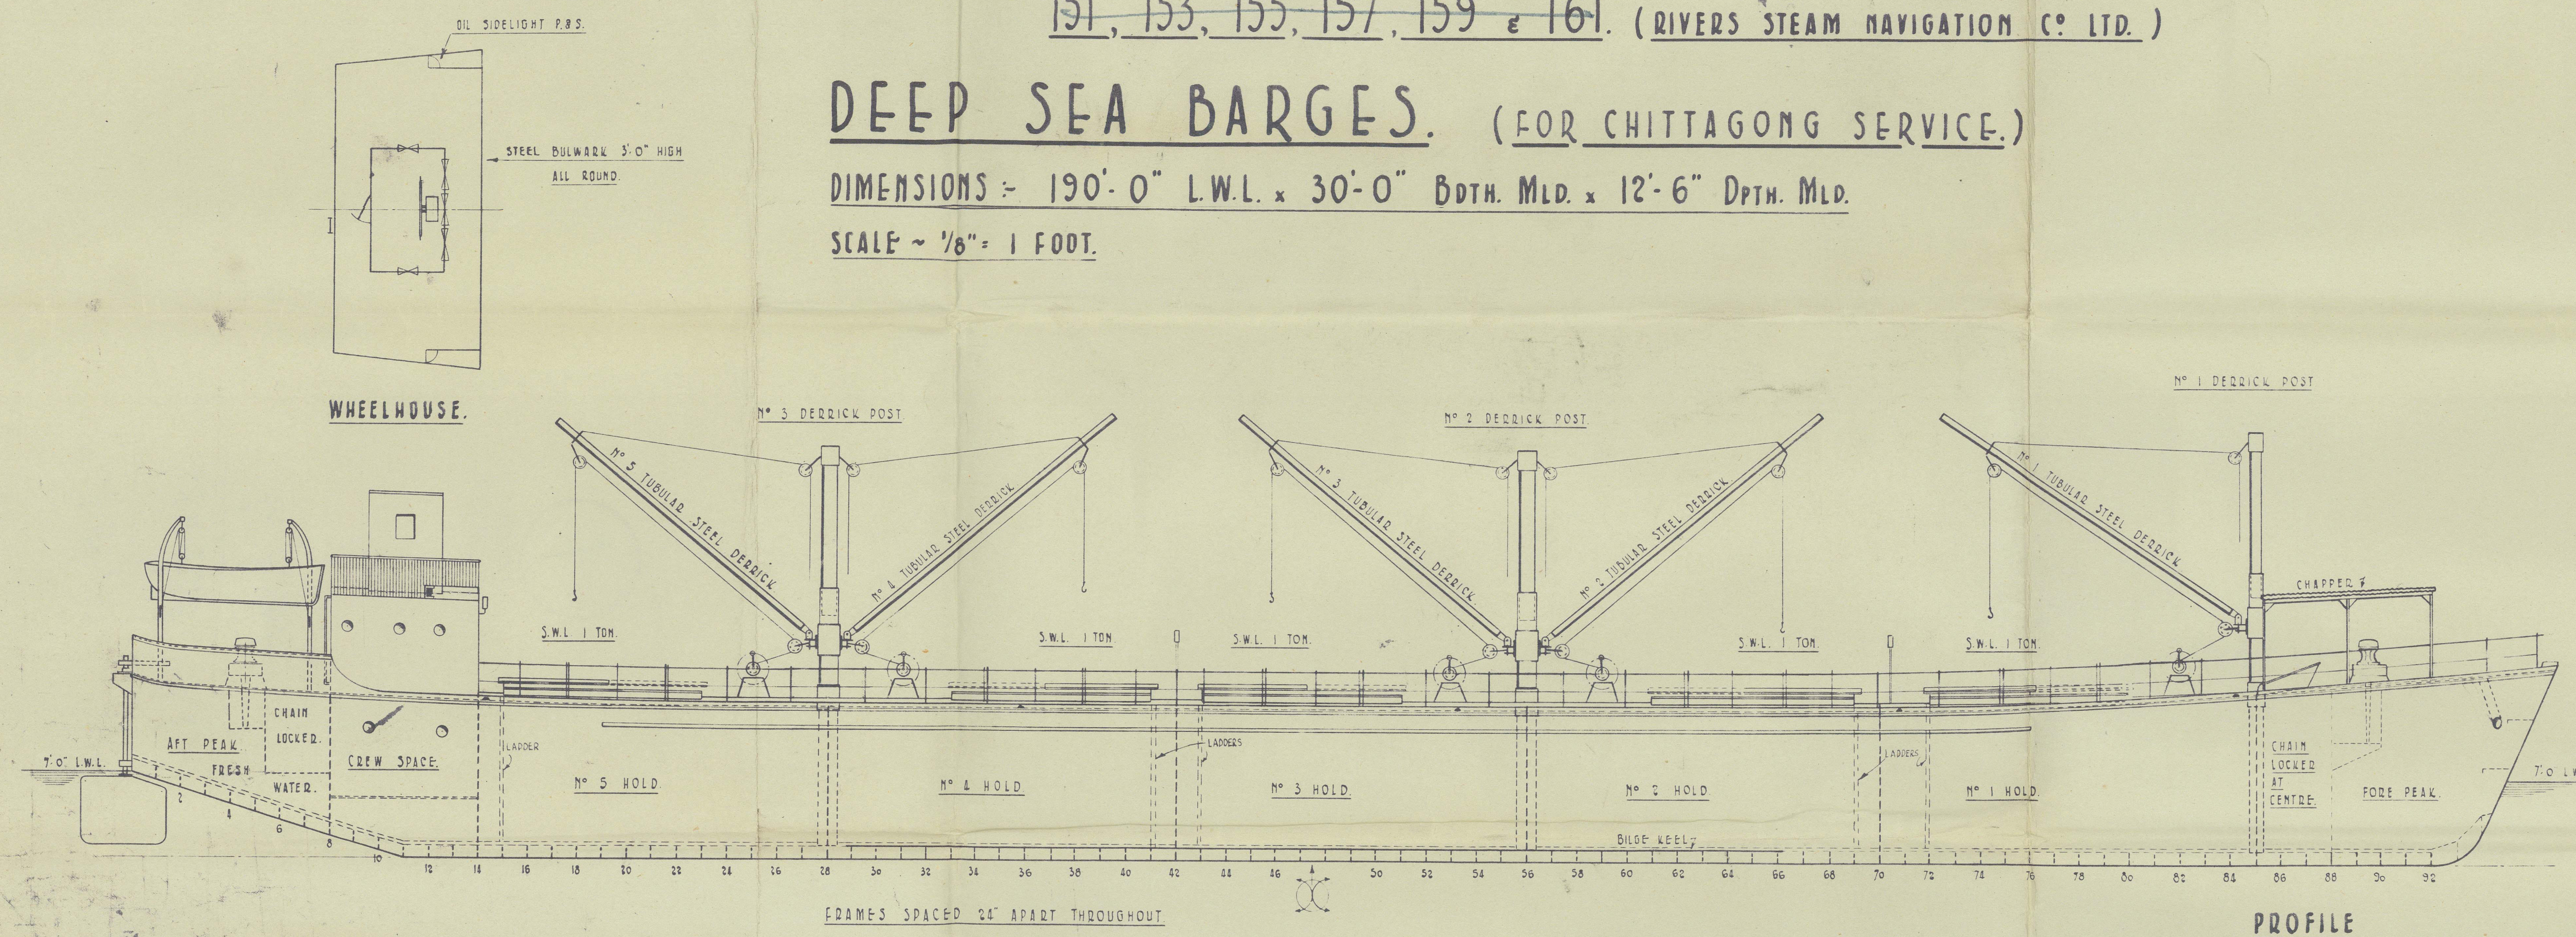

PROFILE

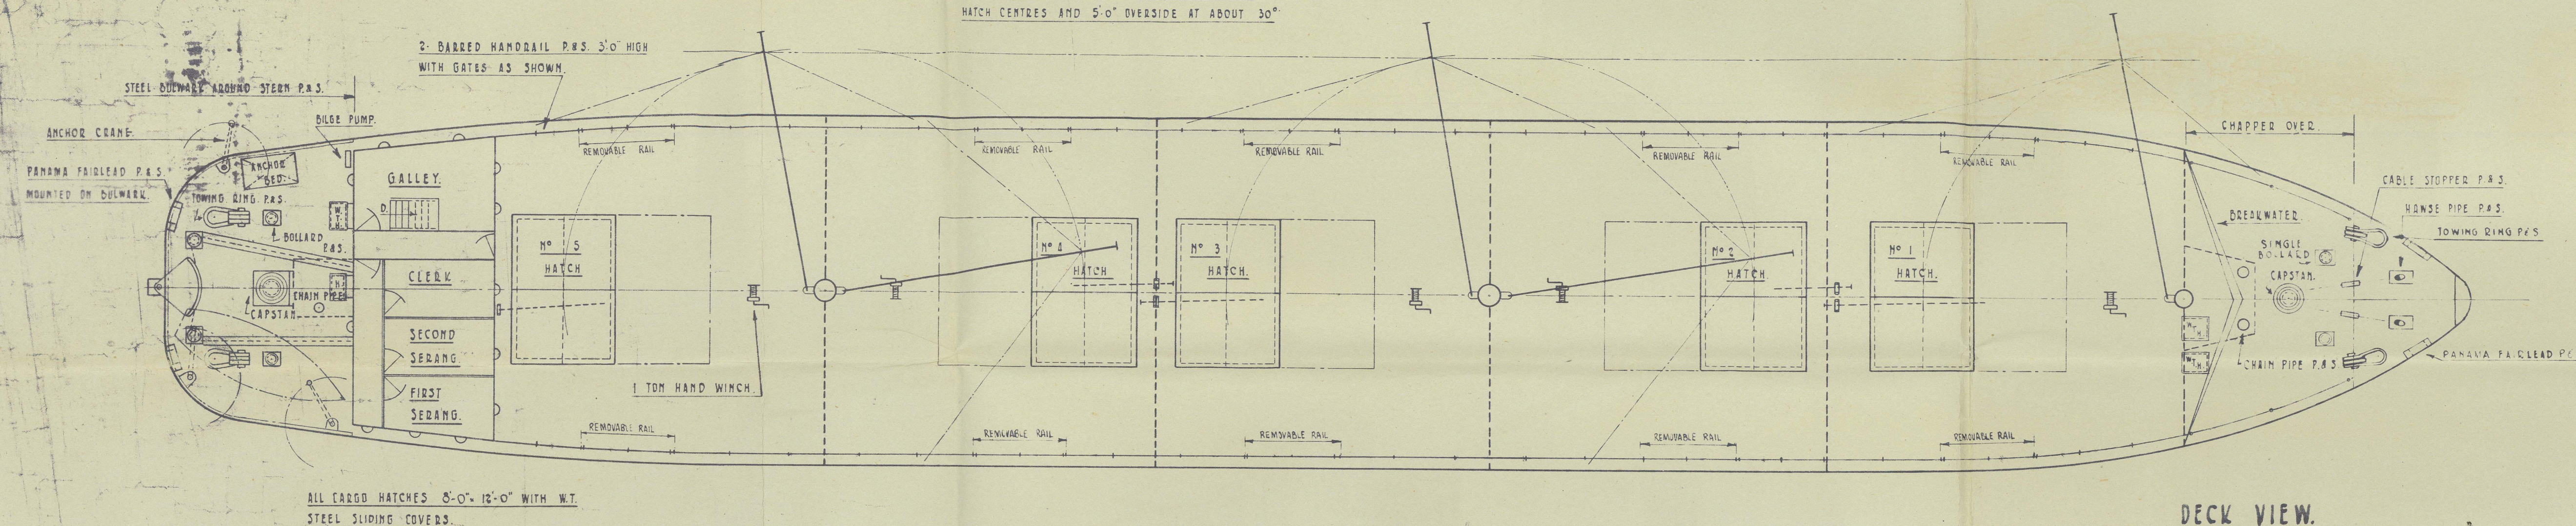


DECK VIEW.

## GENERAL ARRANGEMENT.


RECEIVED (Supervisor) L. J. WILSON  
WALSH  
NORTHUMBERLAND  
DRAWN BY E. W. M. CHECKED *File* JULY, 1949

## STRUCTURAL DETAILS.

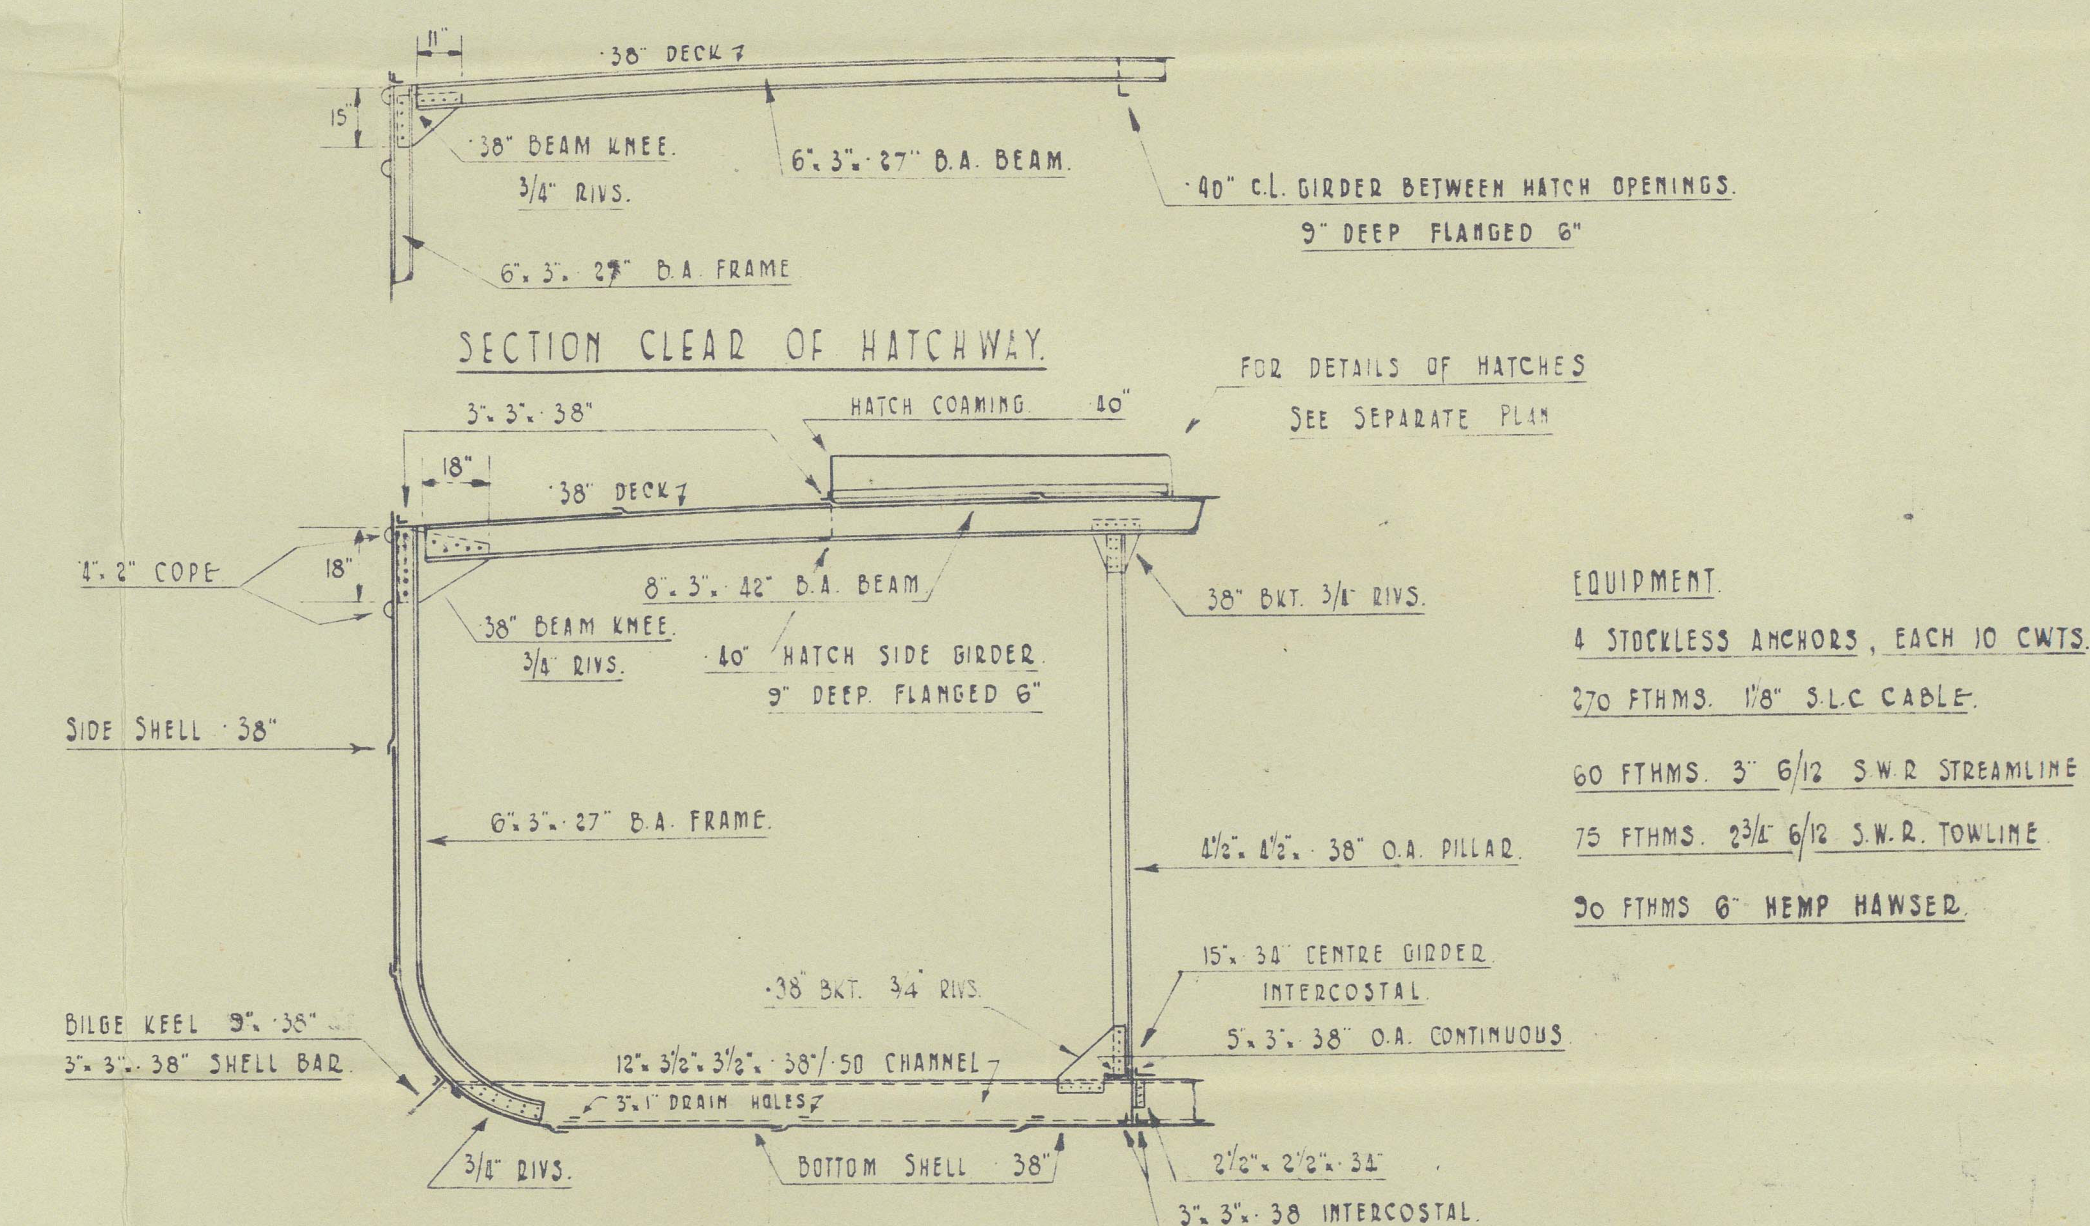

SECTION AT HATCH END

SCALE -  $\frac{1}{4}$ " = 1 FOOT

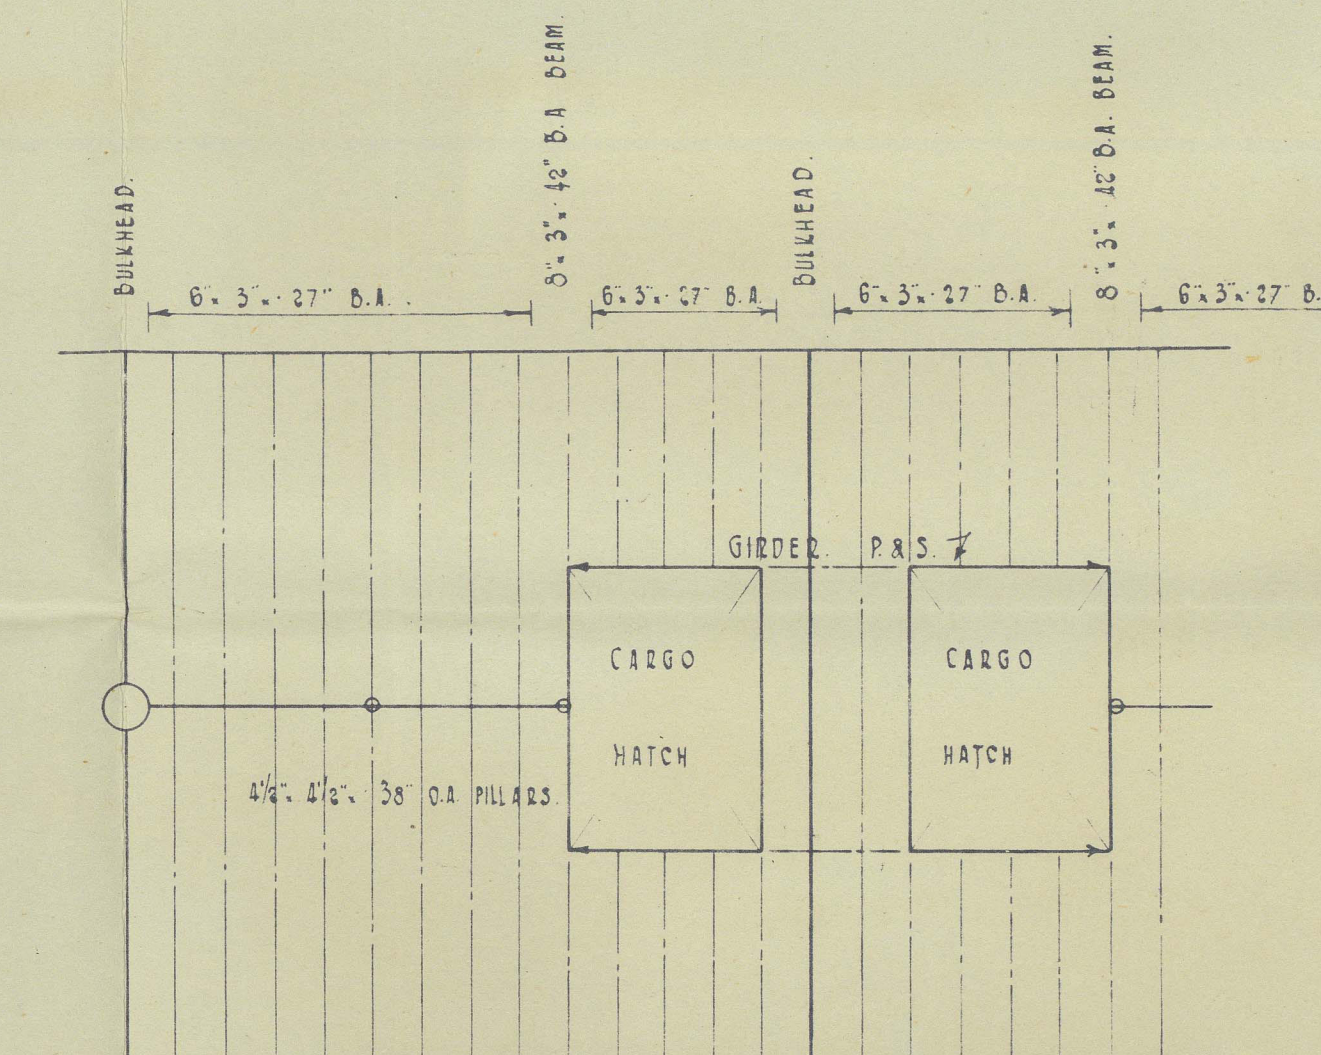

TYPICAL PLAN SHOWING LAYOUT OF PILLARS, GIRDERS & BEAMS.

SCALE ~ 1/8" = 1 FOOT.




CLELANDS (SUCCESSORS) LTD

Yard No 157. Chitra ★

gen. logt & structural details  
(As Erected).

NEWCASTLE-ON-TYNE, No. 108109.

RECORDS DEPT.,  
LONDON

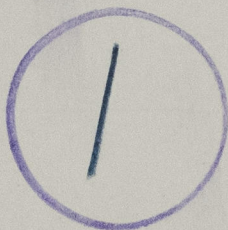

014899-014911-0142



© 2021

Lloyd's Register  
Foundation