

SHIP N^o 120 & 121. STERN FRAME & RUDDER. FORGED IRON.

SURVEY LLOYDS.



SCALE:- 1/2" = 1 FOOT.

DIMENSIONS.
LENGTH BP. 297'-0"
BREADTH MLD. 43'-9"
DEPTH MLD. 23'-6"


NOTE:- FIGURED DIMENSIONS ONLY TO BE WORKED TO.

NUMERALS	
AREA OF RUDDER = 94.23 sq. ft.	"A"
C.G. FROM CR. OF PINTLES = 2.83'	"D"
A x D (94.23 x 2.83) = 267.0	
SPEED NOT EXCEEDING 10 KNOTS.	


A-D not to exceed 2 1/2' from center of rudder
COUPLING.
1" = 1 FT.

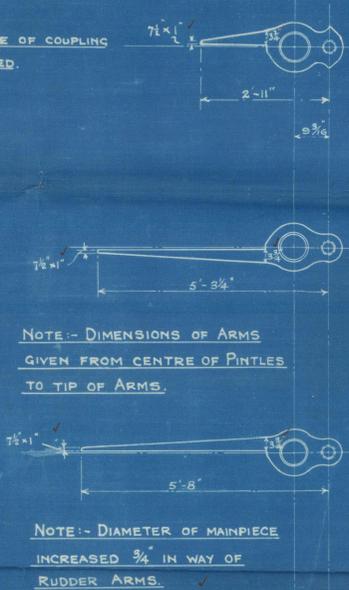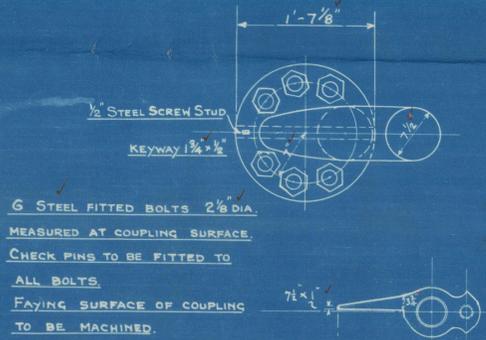


DRILLING.
RUDDER (SINGLE PLATE) 1 3/16" HOLES 5" APART C.T.O.C.
STERN FRAME 1 1/16" HOLES 5" APART C.T.O.C. IN EACH ROW.

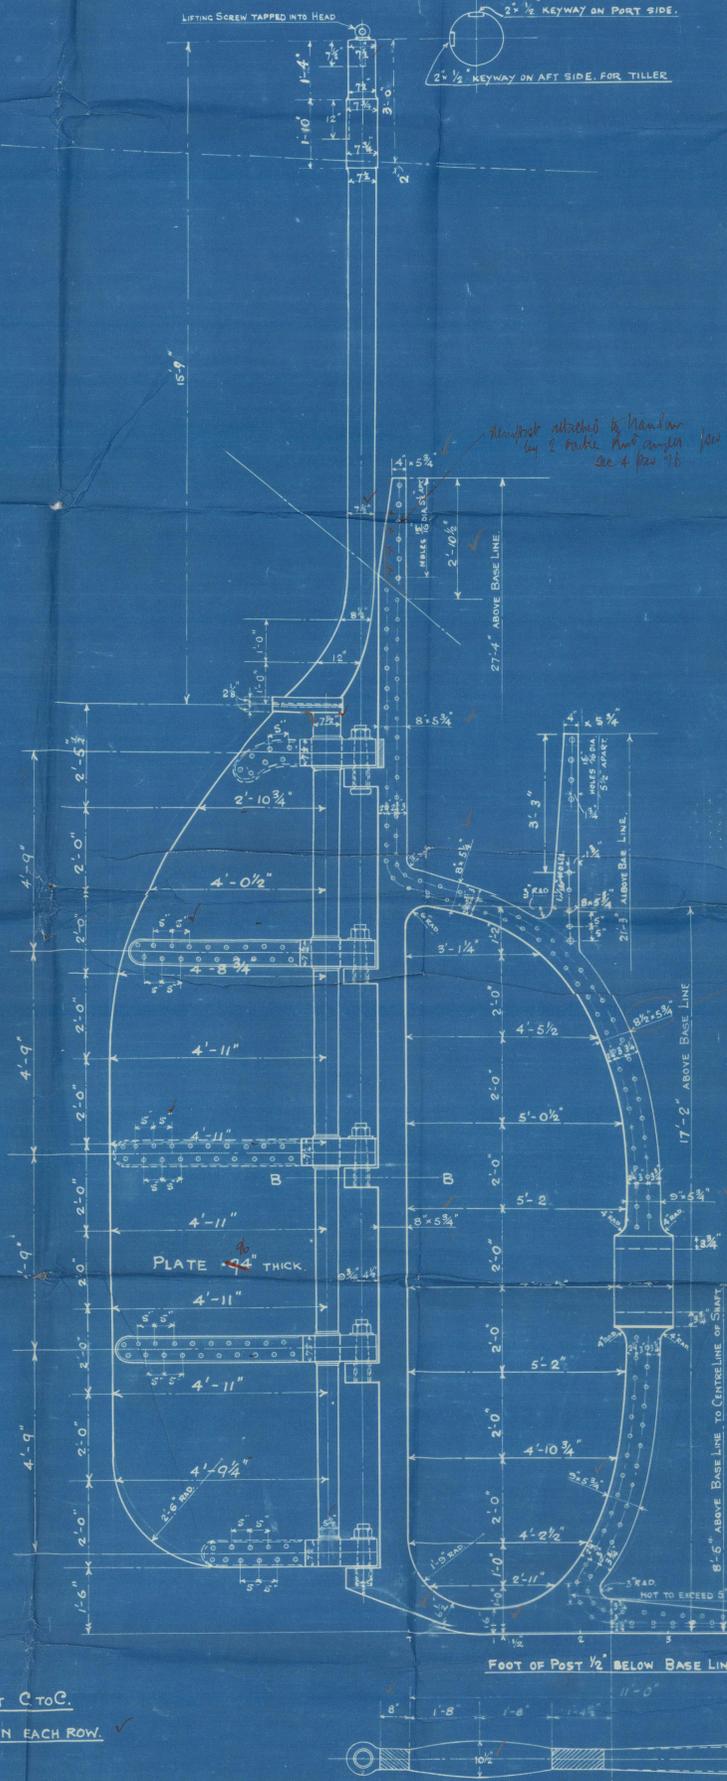

DETAIL OF BUSHES ON PINTLES.
SCALE:- 3" = 1 FOOT.



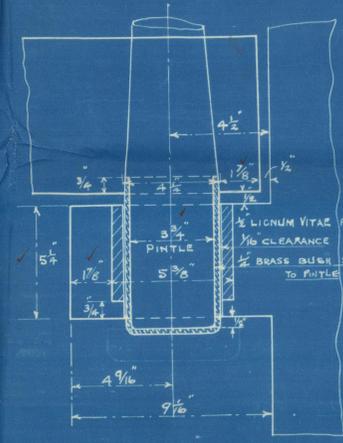


DETAILS OF PINTLES & GUDGEONS.
SCALE:- 1" = 1 FOOT.

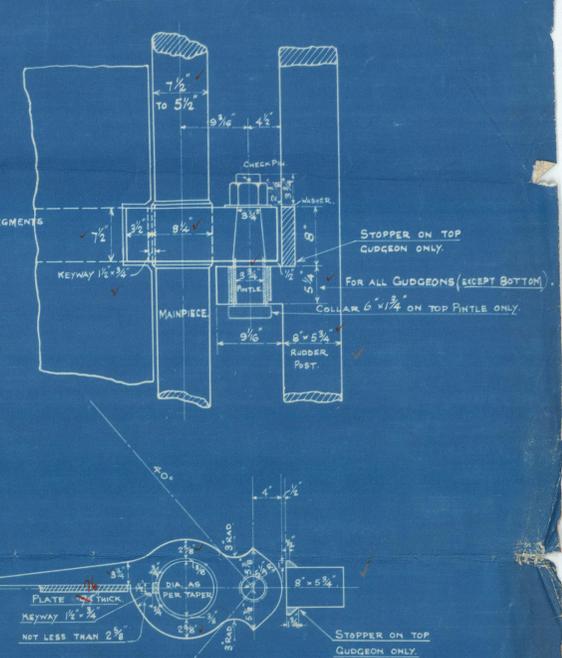

NOTE:- CENTRE LINE OF PINTLES TO BE PERPENDICULAR TO BASE & 4 1/2" PARALLEL TO AFTER SIDE OF RUDDER POST OF STERN FRAME. CENTRE LINE OF MAINPIECE TO BE 9 3/16" PARALLEL TO CENTRE LINE OF PINTLES. ALL PINTLES TO BE OF STEEL, BRASS BUSHED. TO BE MADE & EFFICIENTLY FITTED AS PER DRAWING.

ALL HOLES MARKED TO BE DRILLED BY CONTRACTOR.

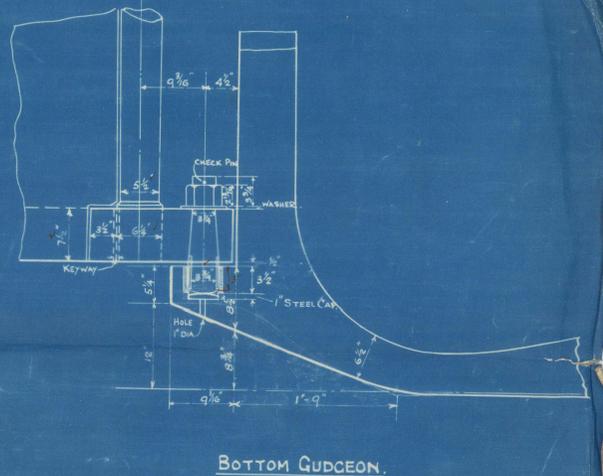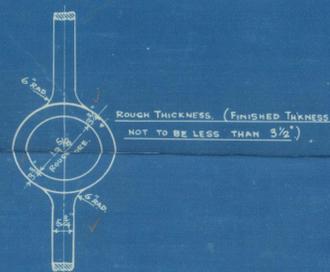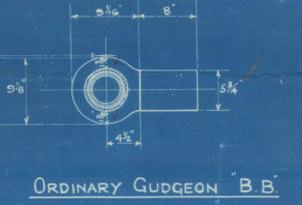

PLAN N^o 413.
PRINT N^o 984



Rutahland J. B. Co

No 120 - 121

Steinframe &

Rudder.

"Mekhaven"

Lh. 16300.

Algarrobo 
ex
Mekbridge

Lh 16536.



© 2021

014899 - 014911 - 0285

Lloyd's Register
Foundation