


Mahrö.

Hockmors Mek. Verkstads A. B.

M/T 226 "Mahröhrns"

Profile and Plans of vessel as built.

(Mahrö F.E. Report No. 2001)

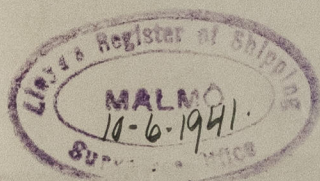

© 2021

Lloyd's Register
Foundation

015139-015154-0022