

17 JUL 1946

No 739.


PROFILE & DECK PLAN.

DIMENSIONS:- RULE LENGTH 435'-0" BREADTH M₀ 59'-8 1/2" DEPTH M₀ 20'-5" to 22'-0"

SCALE 1/8" = ONE FOOT.

FULL SCANTLING VESSEL WITH ERECTIONS.

CLASS:- LLOYDS 100 A.1.

 

015183-015187-0002



BH 673
3rd Floor

DOXFORDS 739-47

PROFILE AND DECKS

SUNDERLAND RPT NO. 34613

"Herdsmen"

COMPUTERISED


SUNDERLAND RPT. NO. 34613

Interpreter



TAXIARCHIS MICHAEL
EX
INTERPRETER

RECORDS DEPT.,
LONDON

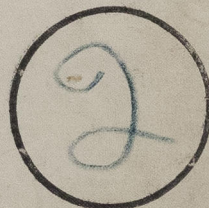


BUNDLE
673

SHELF 46.
IBEX.

S/V KOTA SELAMAT


015183-015187-0002

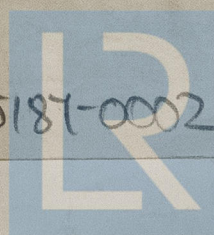

© 2021

Lloyd's Register
Foundation

015183-015187-0002

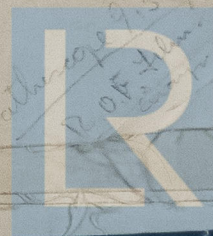

© 2021

Lloyd's Register
Foundation