



Lloyds
Known
J 1184
No J. 1574

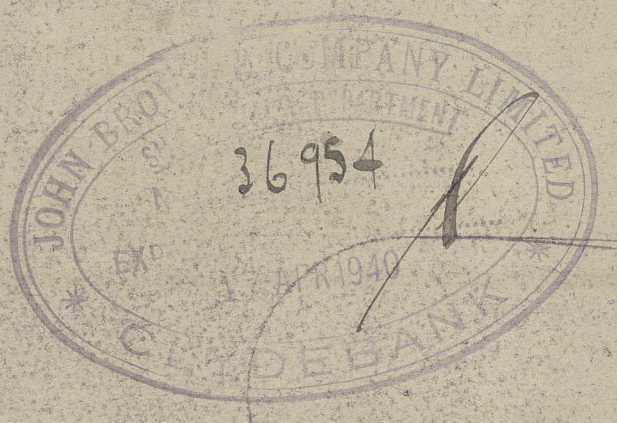

PROFILE & DECK PLANS
Scale 1/2" = 1' 0"

DIMENSIONS:
180' 0" Overall, 55' 0" Ht, 19' 0" Wd

SUITABLE DOUBLING PLATES ARRANGED AT
BALANCED ENDS OF UPPER DECK
IN WAY OF BOLLERS & SALVAGE BOLLERS ON LOWER DECK
IN WAY OF DE MAST & SALVAGE CHIMNEYS

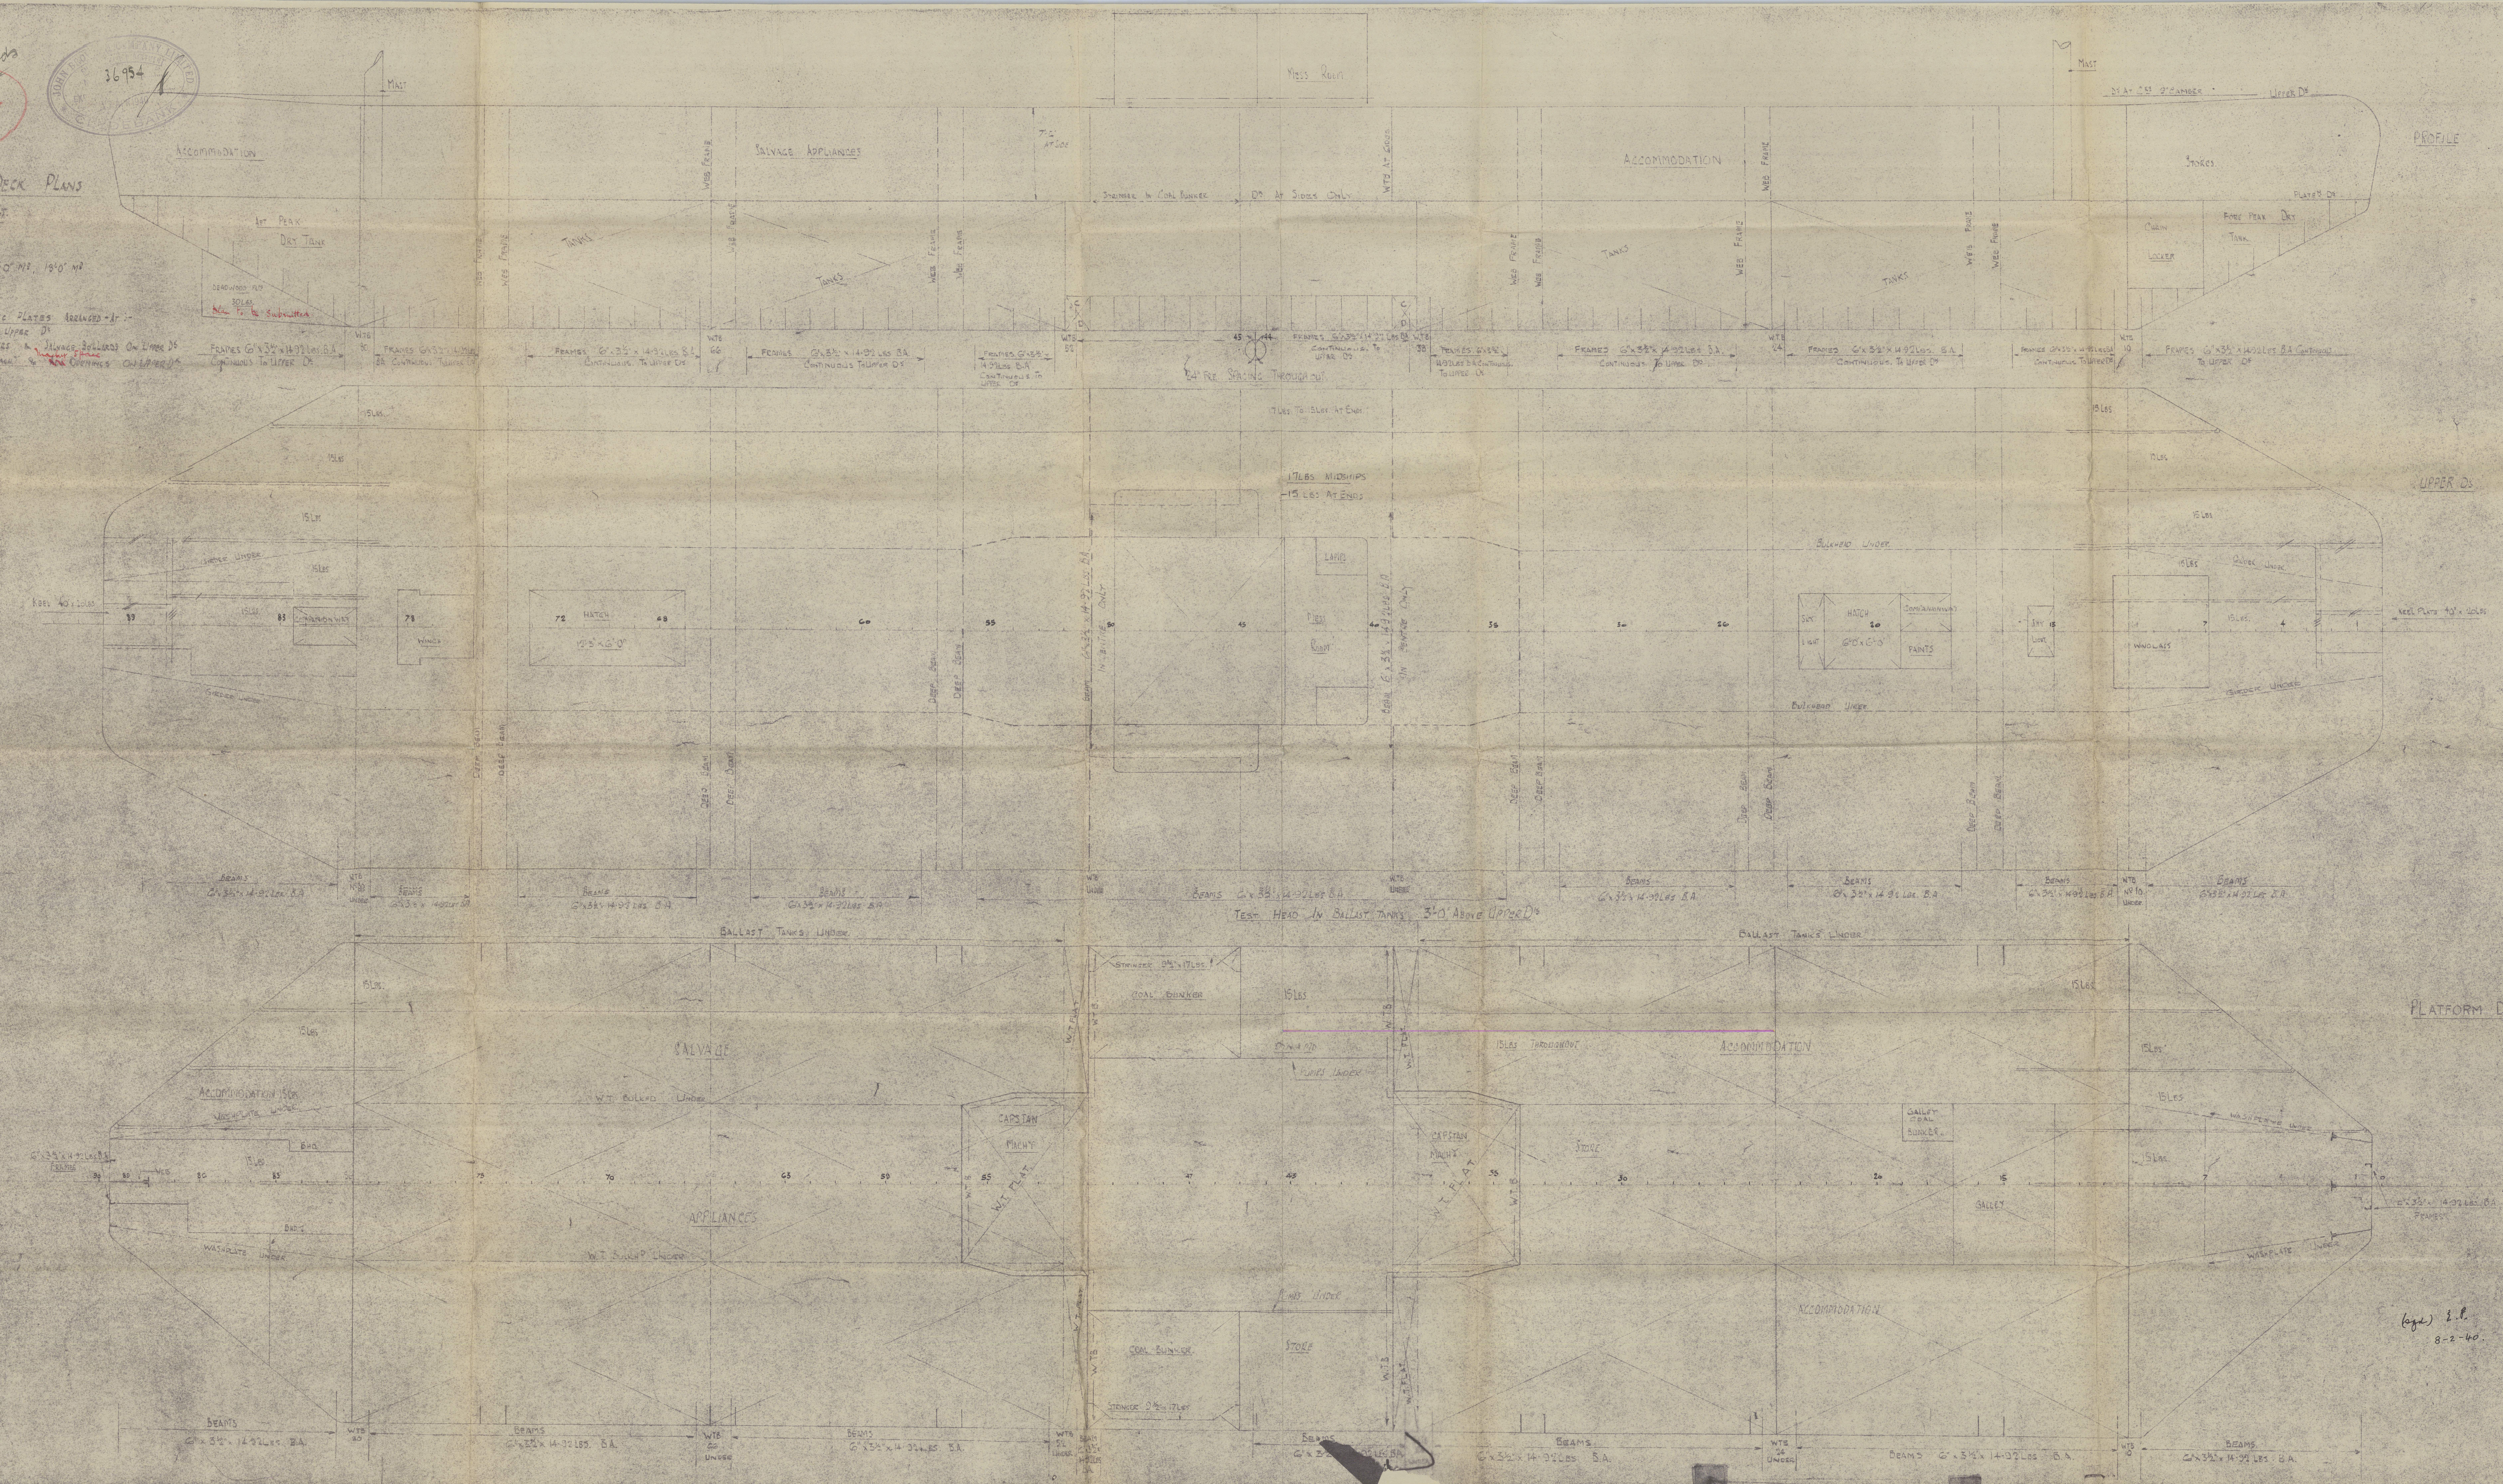

(apt) E.P.
8-2-40.

J. Samont & Co Ltd

Yard n° 1184

(2)

Profile & Deck Plan

"L.C. 9"

GREENOCK 1ST ENTRY REPORT NO 21220.



© 2021

Lloyd's Register
Foundation

015224-015232-0231