




General Arrangement of two Steel Screw Coasting Steamers  
 No 174 & 175  
 Scale 1" = 10'





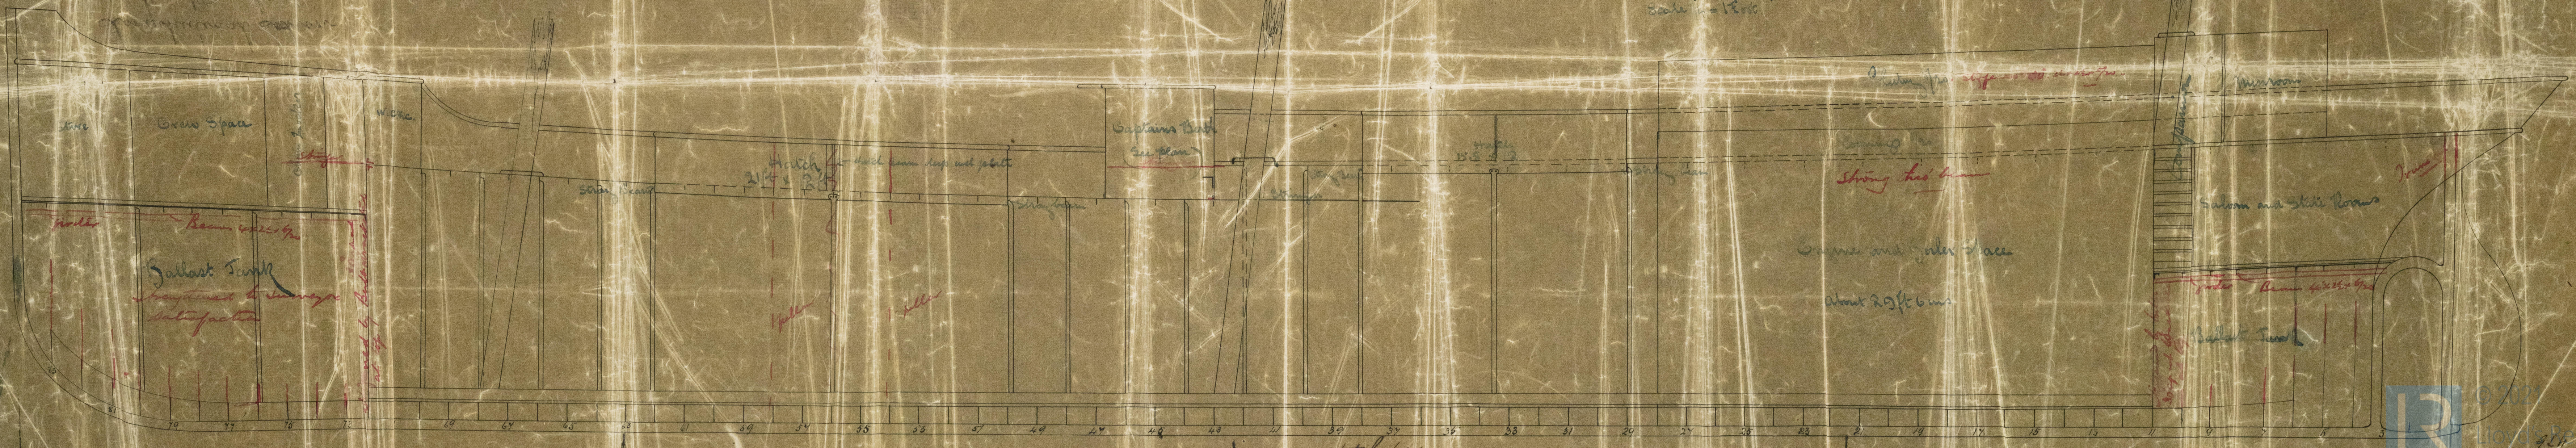

Longitudinal Section  
Messrs J. Guthrie & Sons  
S.S. No. 1447143

S.S. Golfer  
S.S. Carver

4273

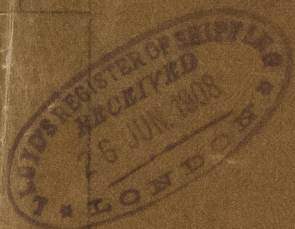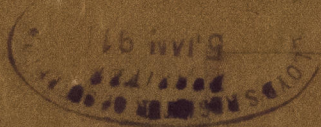

ABW21-0101



© 2021

Lloyd's Register  
Foundation