
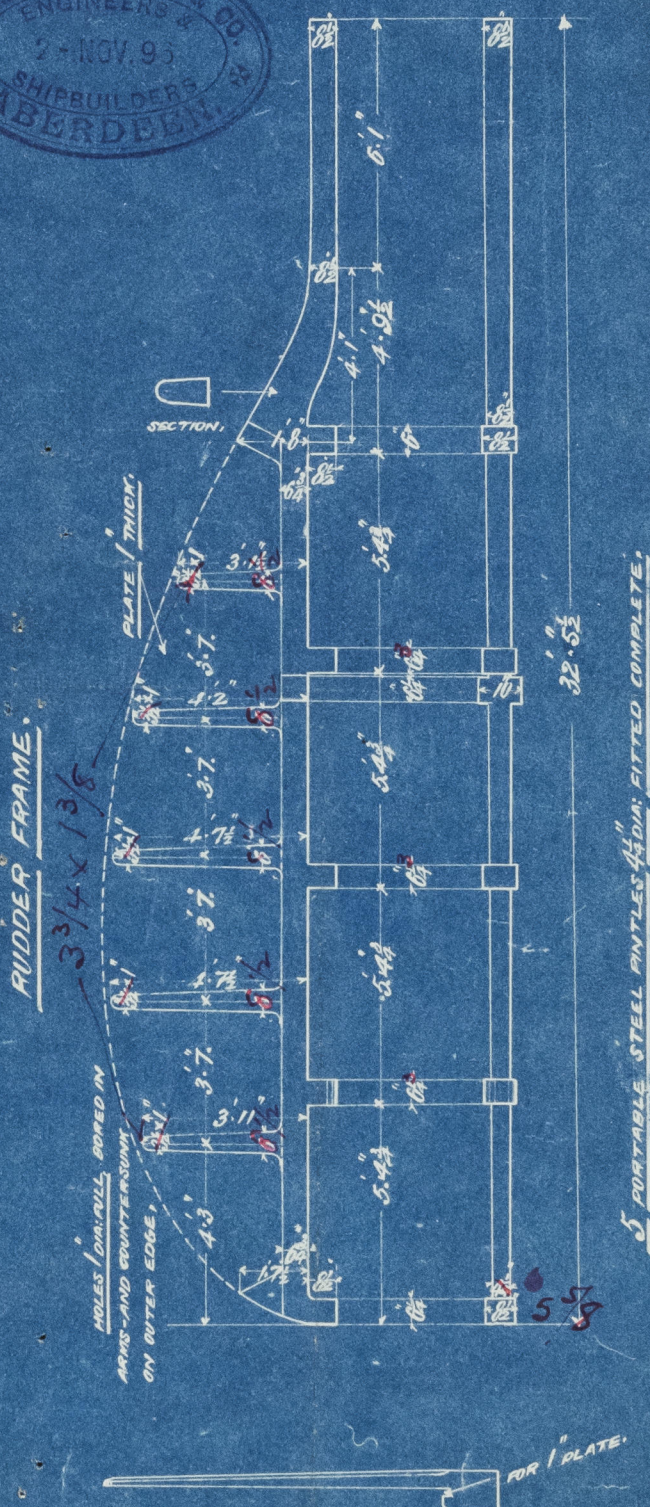


•S.S. № 303.

11. 11. 96

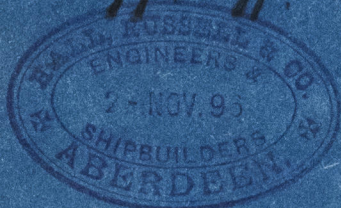

SECTION 1

arms on alternate  
sides of swing



1796



Rudder Frame  
of  
Messrs Hall Russells  
S. S. no 303  
S. S. "Engeli"  
Rpt no. 5637



© 2021

Lloyd's Register  
Foundation

ABN 26 019