


Ref. 91  
3-2-91

Under Seel Pumpage about 2500  
PUMPING ARRANGEMENT  
OF  
S. S. N<sup>o</sup> 303.  
SCALE 1/4" = 1'-0"



Left hand pumps ref to  
Spec. 24f.

 




---

Pumping Plans  
for  
Messrs Hall Russell's  
S.S. No 303

S.S. "Ingeli."

Abd's Report No 5634.

---

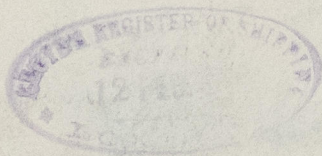

© 2021

Lloyd's Register  
Foundation  
ABN26-0131