

# Lloyd's Register of British and Foreign Shipping.

(Report on Vessel No. \_\_\_\_\_ Port \_\_\_\_\_)

## No. 5642 SHIP FORGINGS OR CASTINGS.

The words FORGINGS or CASTINGS, IRON or STEEL, should be struck out as may be required.

I have to report that the undermentioned Iron or Steel Forgings or Castings, manufactured by *The Lennystown Forge Co.* of *Lumberton.* for the Vessel No. *148*, being built by *Messrs. Workmen Clark & Co.* of *Belfast.* have been inspected by me as set forth below, and found to be, so far as can be seen, *Sound.*

Mark on Forgings.


Lloyd's  
No. 5642  
F.C.

*Frank Cook.*

*Glasgow.*  
*19/6/97*

	STERN FRAME.	RUDDER FRAME.	STEM.
Material* ...	<i>Scrap Iron.</i>		
How made ...	<i>Forged.</i>		
Dimensions ...	<i>12 x 9 3/4</i>		
Progress on Inspection	<i>Forged &amp; admitted</i>		
Date when Inspected	<i>16/4/97 to 12/6/97.</i>		

SKETCHES OF FRAMES SHOWING POSITION AND DESCRIPTION OF WELDS OF FORGINGS, OR PARTICULARS OF TESTS APPLIED TO CASTINGS.

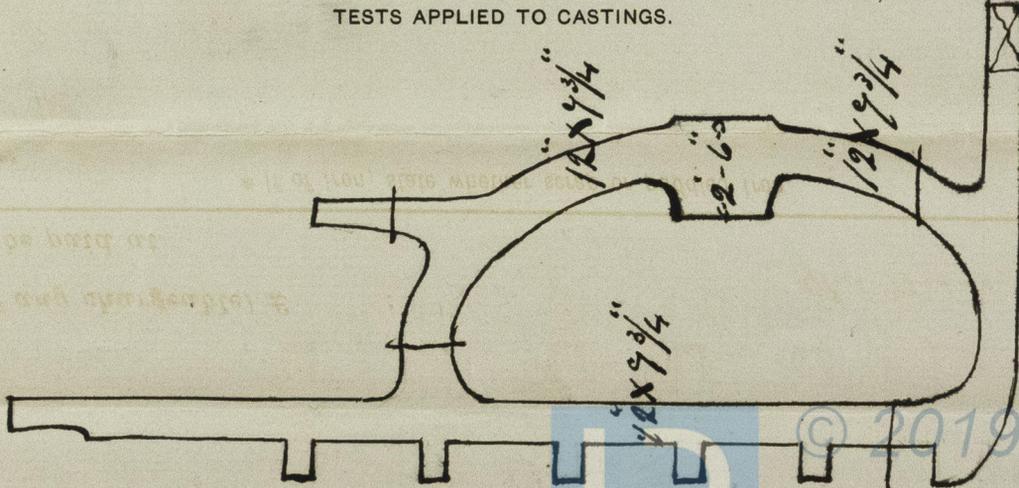

Fee (if any chargeable) £ : :

To be paid at \_\_\_\_\_

*Gut Welds.*  
Lloyd's Register  
Foundation

\* If of Iron, state whether scrap or puddled Iron.

Stern Frame

Wm Ruman Clear R 148

No 148



© 2019

Lloyd's Register  
Foundation