
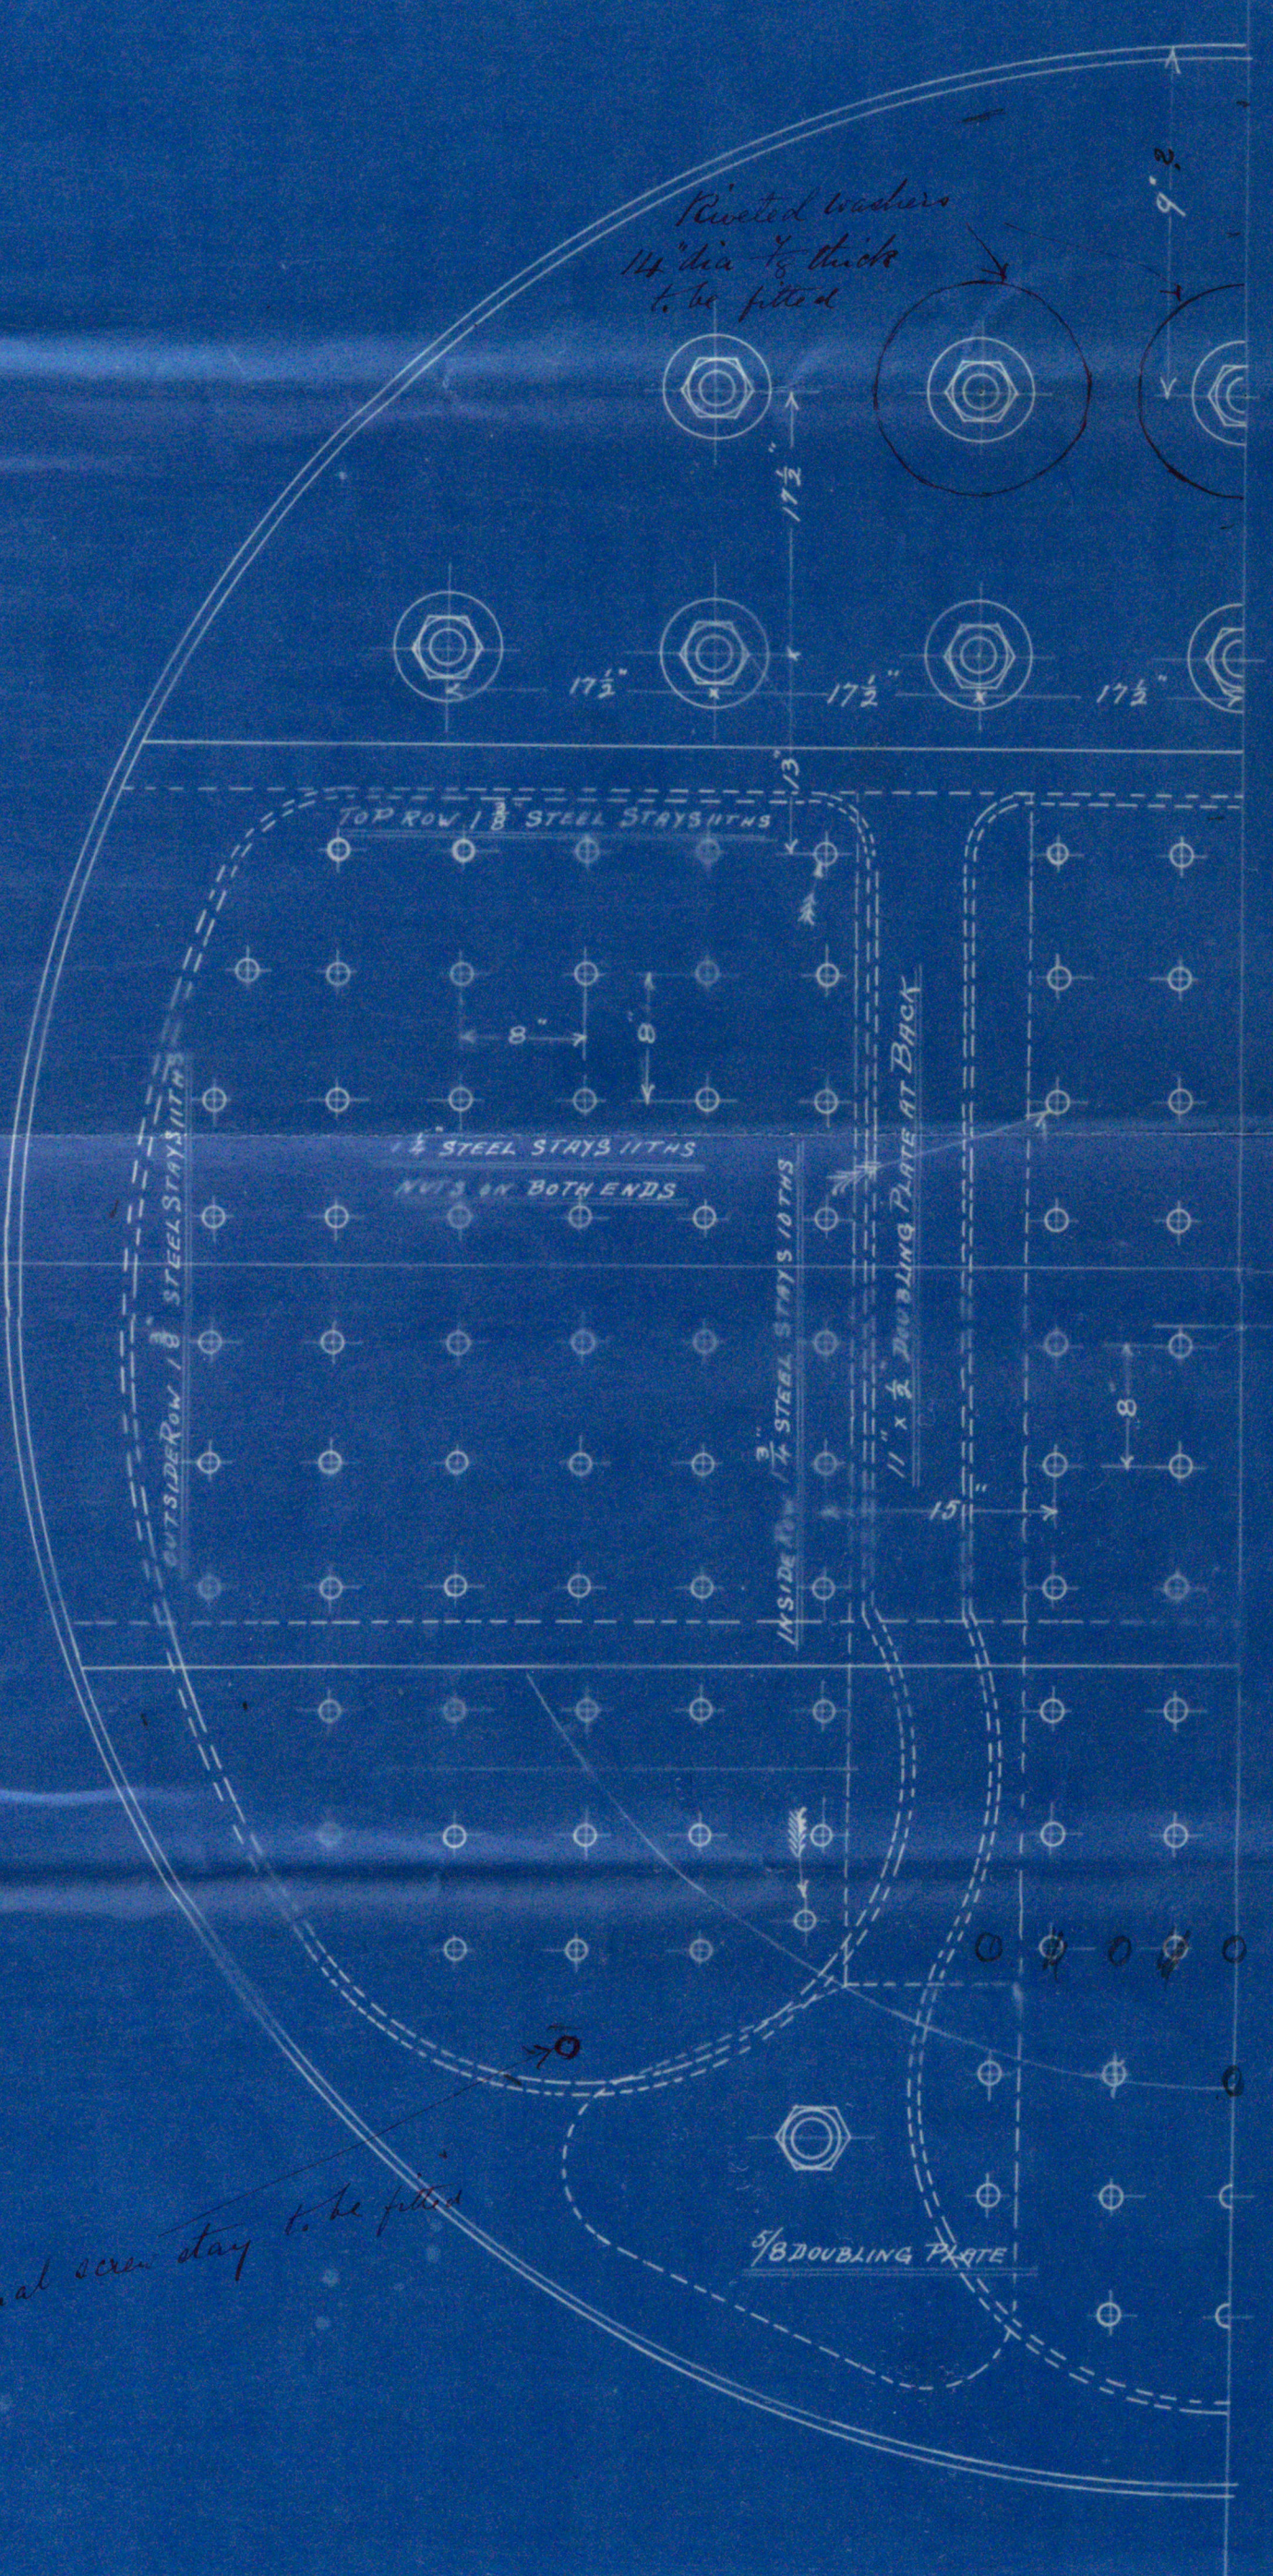
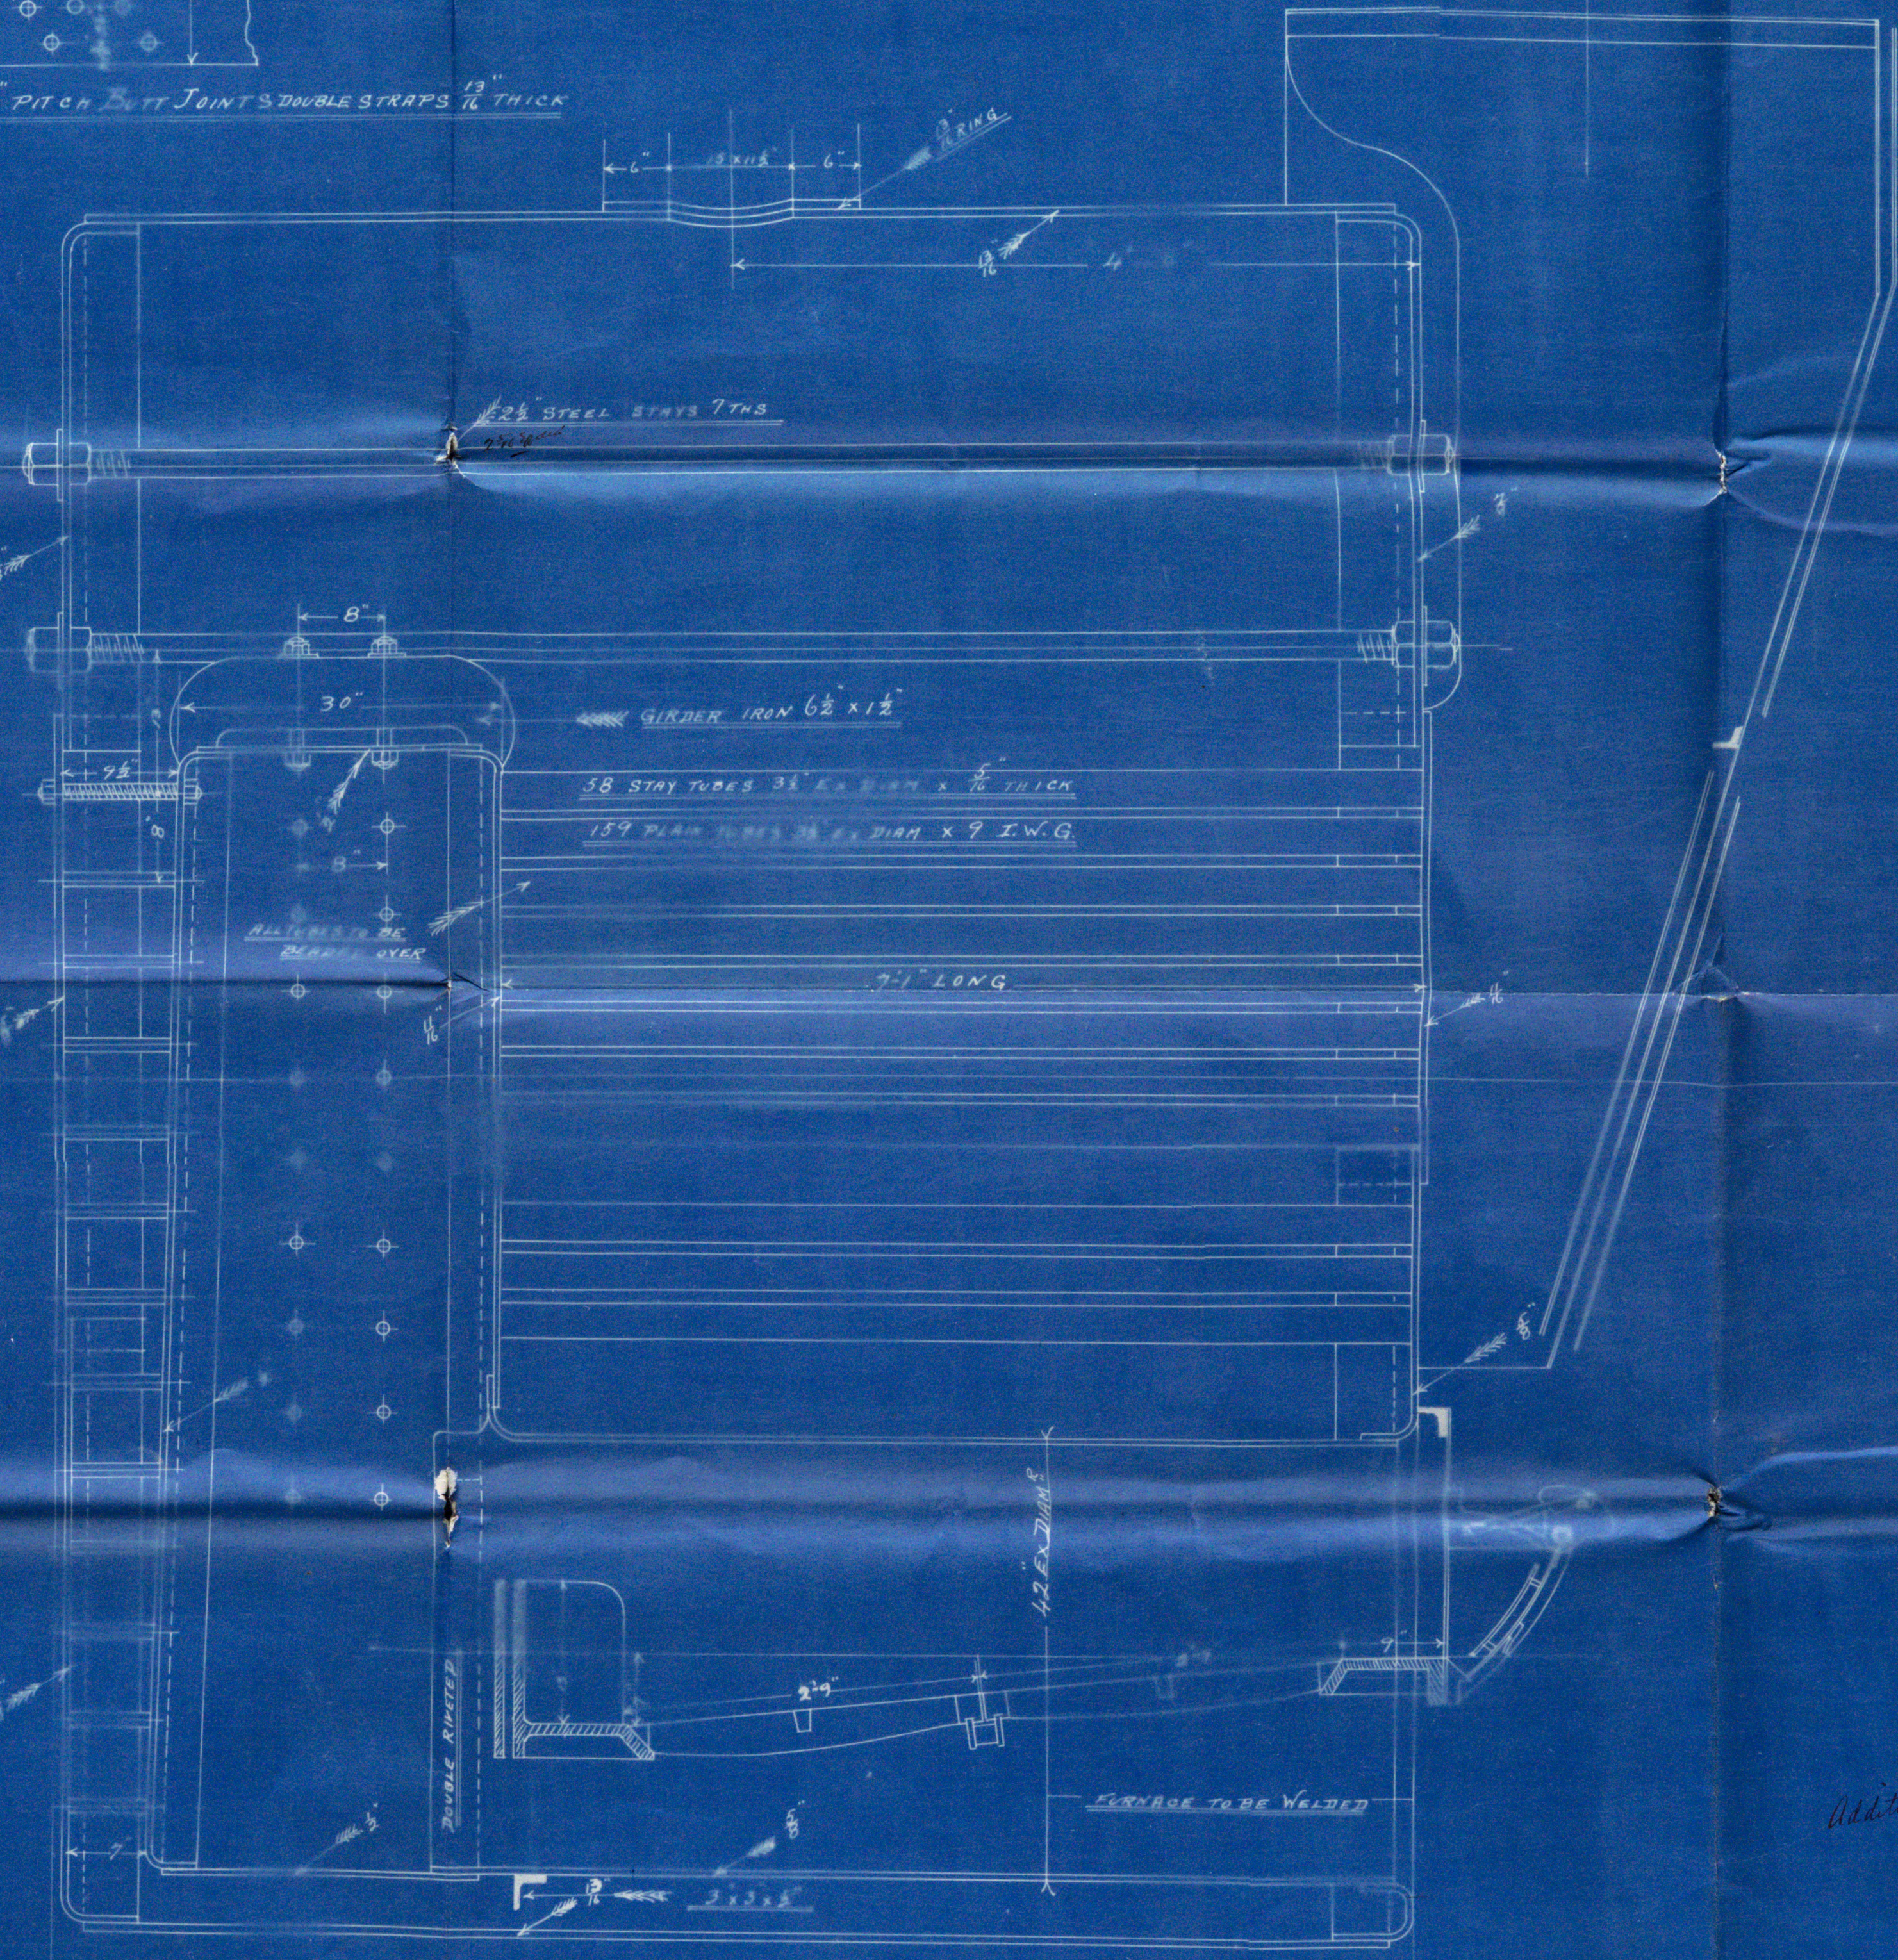


22/12/97

STEEL PLATES BARS AND RIVETS
ALL HOLES DRILLED IN PLACE

1/2" STEEL DOUBLE RIVETED
1 HOLES 4 PITCH 2 1/2" DIA

1/2" HOLES 6" PITCH BUT JOINTS DOUBLE STRAPS 1/2" THICK

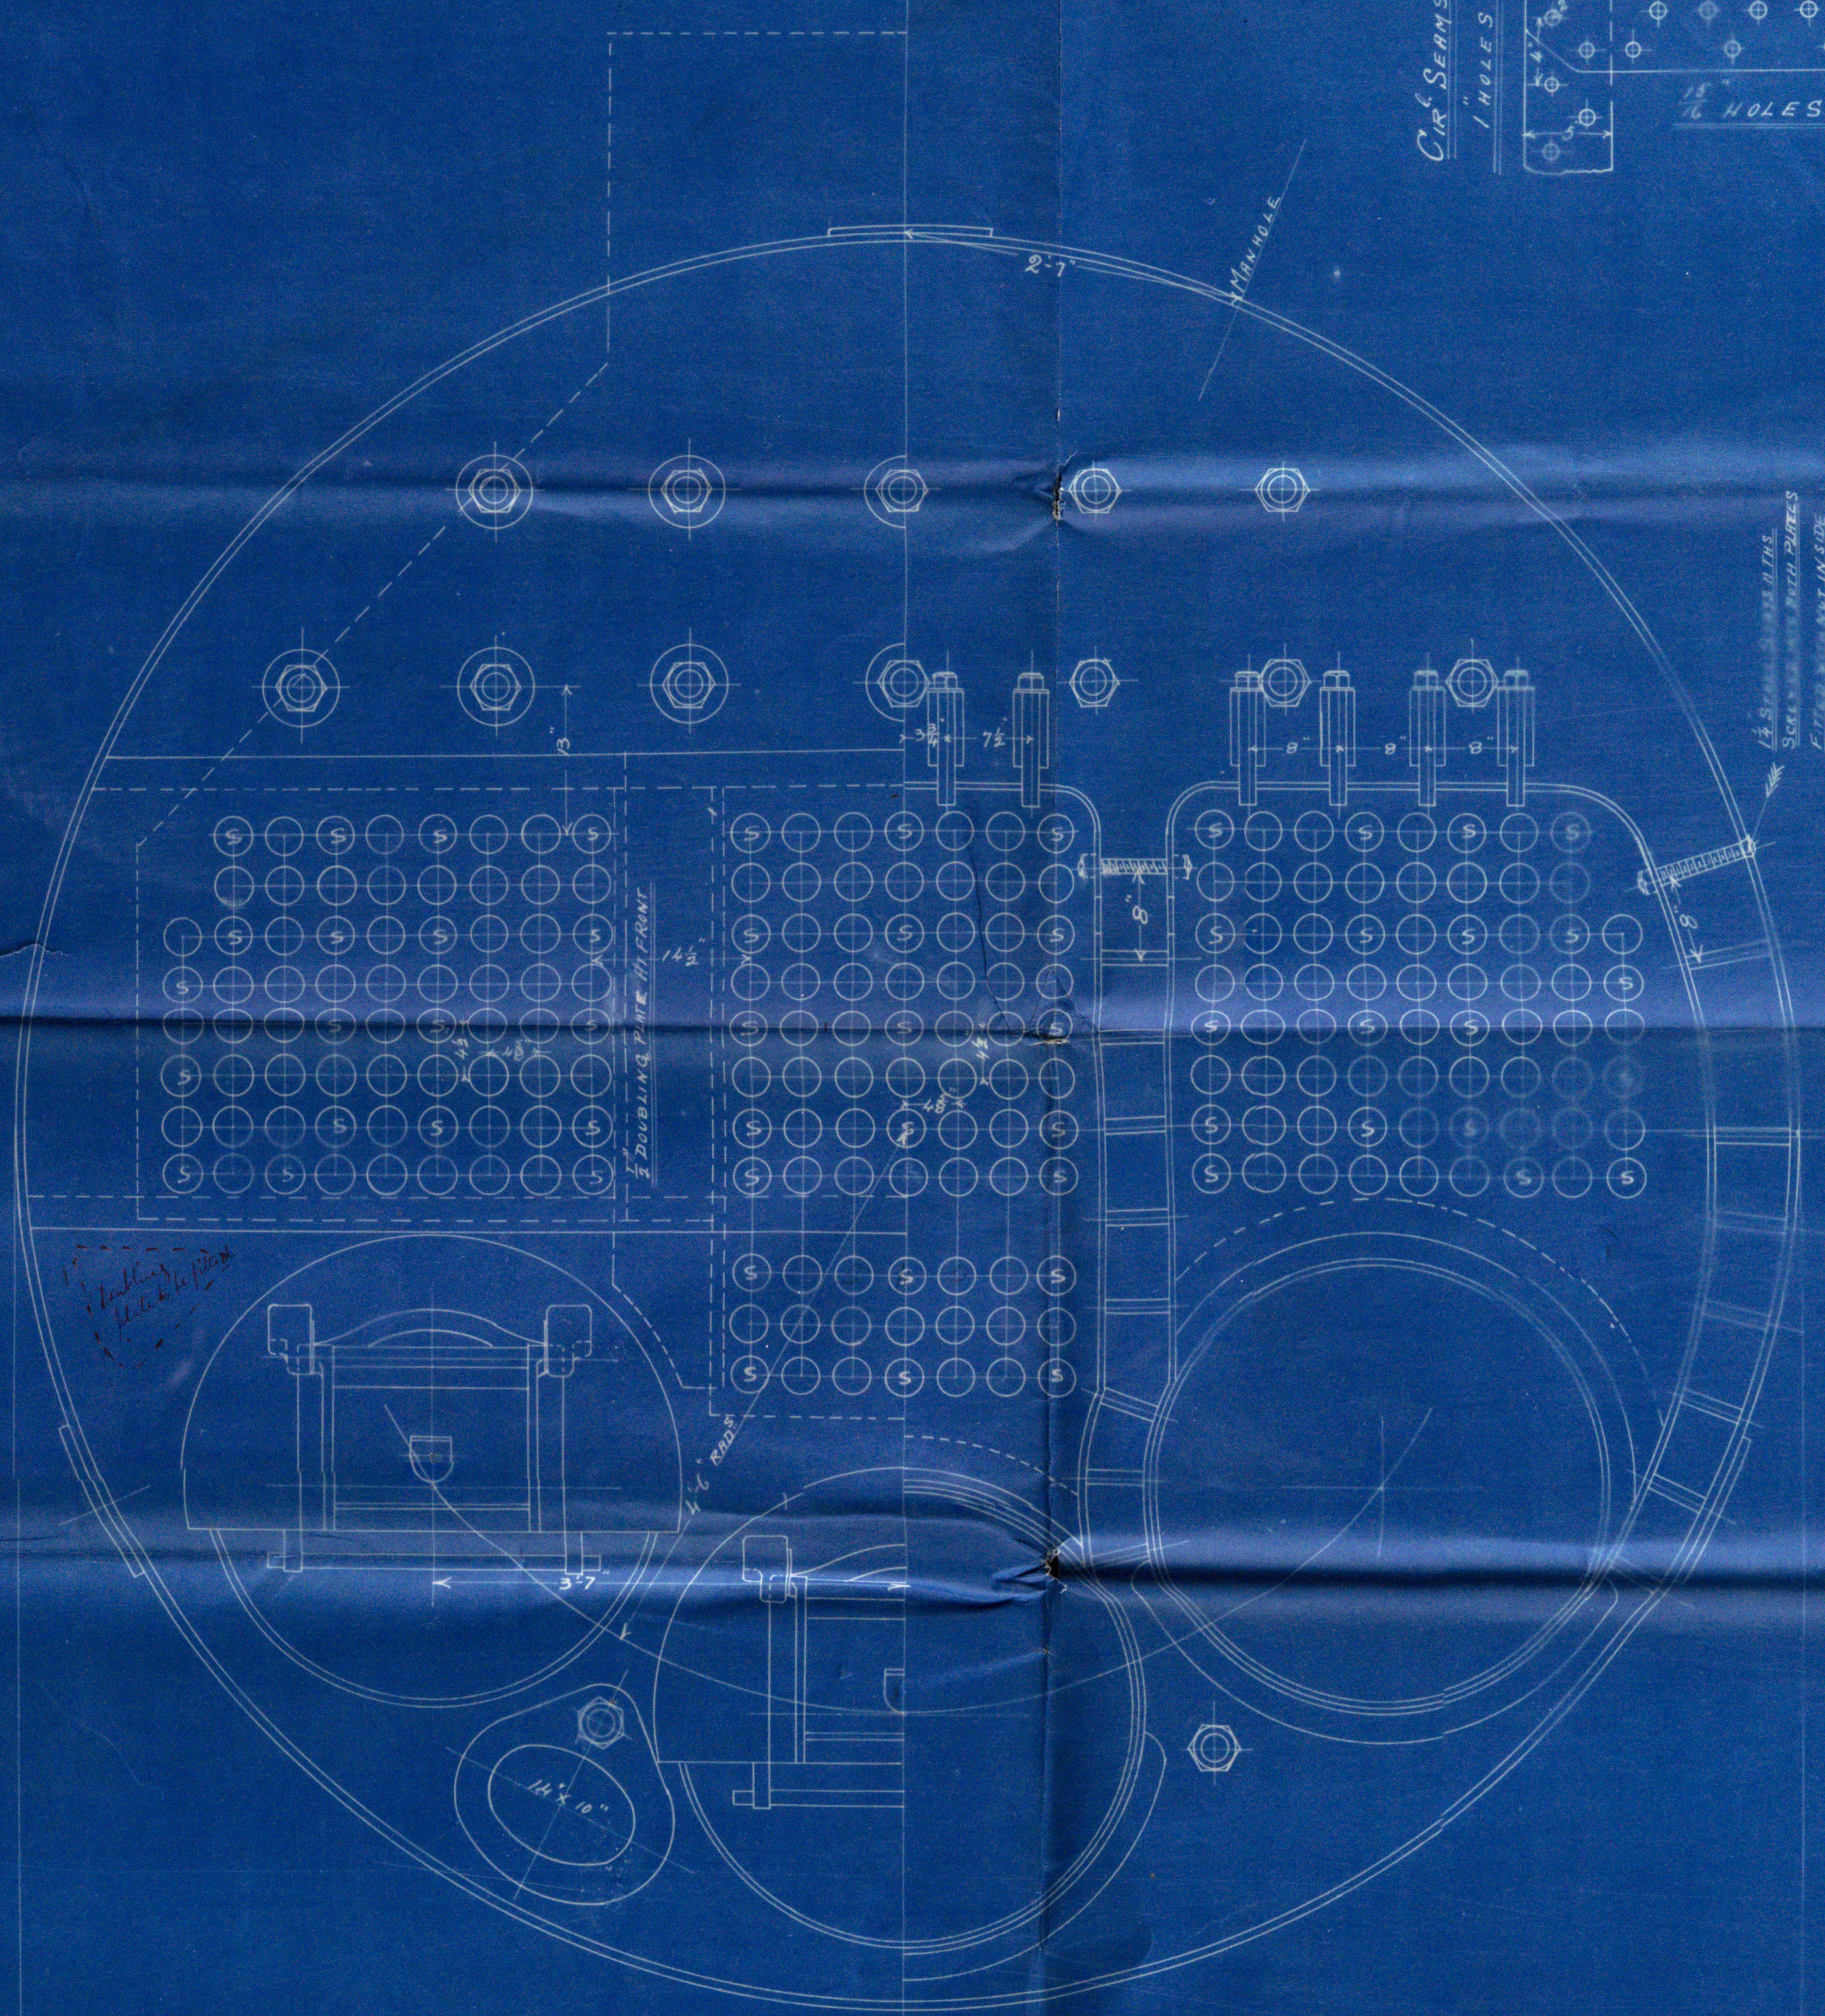

BOILER N° 756
Working Pressure 150 lbs per sq in
SCALE 1 inch = 1 foot

GRATE SURFACE	= 56 sq ft
TUBE	= 1431.2 sq ft
OTHER	= 294 sq ft
TOTAL HEATING	= 1725.2 sq ft

TO HAVE LLOYD'S CERTIFICATE

22/12/97

Main Boiler No 453
- 459 Impairs

by
Rosirduncan
for


R. Williamson Rons No 118 $\frac{1}{4}$

115 lbs working pressure.

S. S. Luddick

Glasgow Report No. 16574
Serial 5710198

BRW - 0078 (2/2)

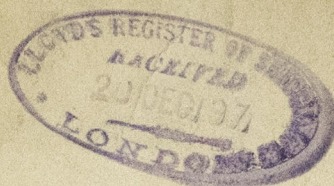

© 2021

Lloyd's Register
Foundation