

mod? piniq
no 2 + m...
. 02 0L . 2.2

TRACING N°1232
SEPTEMBER 9-198

PUMPING PLAN. N^o 156

SCALE $\frac{1}{4}$ INCH TO THE FOOT.

under deck Tonnage. about 220 tons.

R. WILLAMSON & SON
SHIPBUILDERS
WORKINGTON.

③ 3" HAND pump to Bilge

MAIN HOLD.

NO WATER BALLAST

Fluction to fore peak ballast tank 2" diameter galvanized iron pipe

③ ← 3" HAND pump to Bilge

FORE PEAK TANK.

3" hand pump to
Forecastle

1" Sounding pipe

1 1/2" air pipe
2 in slips

~~Bru~~
~~20.10.98~~
~~N.S.~~

Pumping Plan


R. Williamson & Sons

S.S. No 156.



S.S. "Fred"

Pls Rpt No. 16860

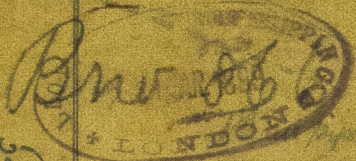




BRW 46-0122

TANK.

#8



© 2021

Lloyd's Register
Foundation