

RUDDER FRAME.

S.S. "GREENWICH"

SCALE $\frac{1}{2}" = 1 \text{ FOOT}$.



TO BE CONSTRUCTED UNDER LLOYDS SURVEY.

RIVET HOLES $1\frac{3}{16}$ " $5\frac{5}{8}$ " PITCH.


HOLES IN ARMS TO BE COUNTERSUNK.

DETAILS OF GUDGEONS.



SCALE $1\frac{1}{2}'' = 1$ FOOT.

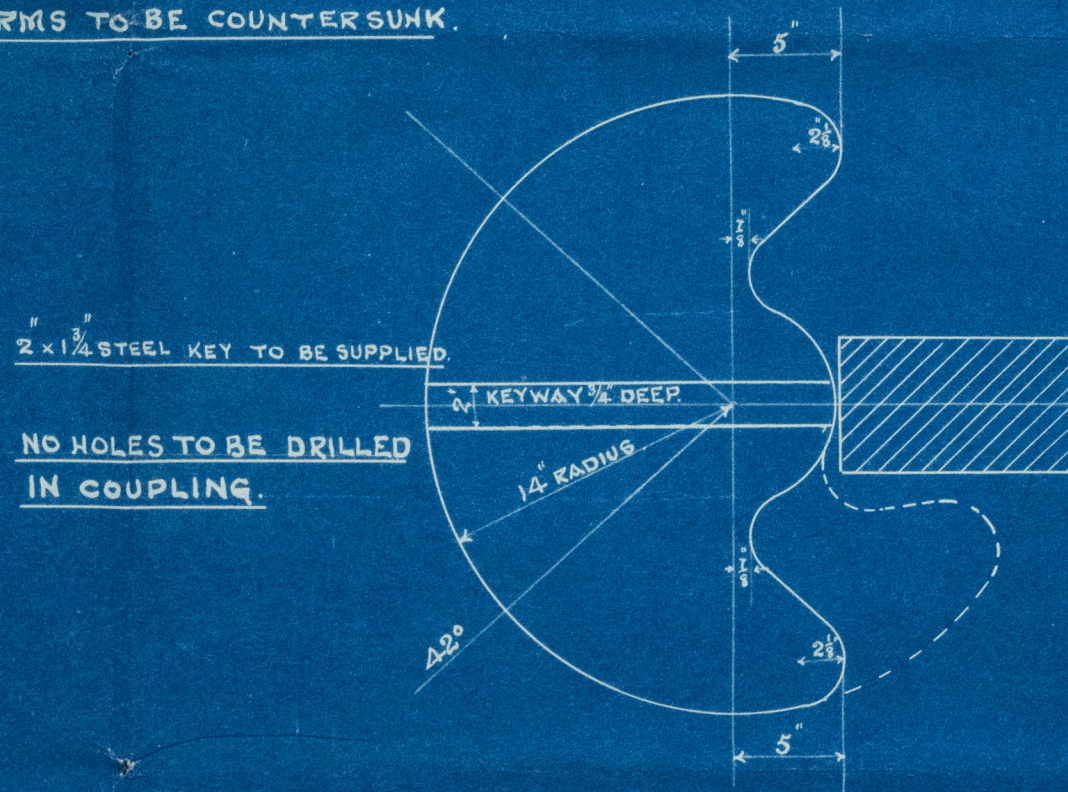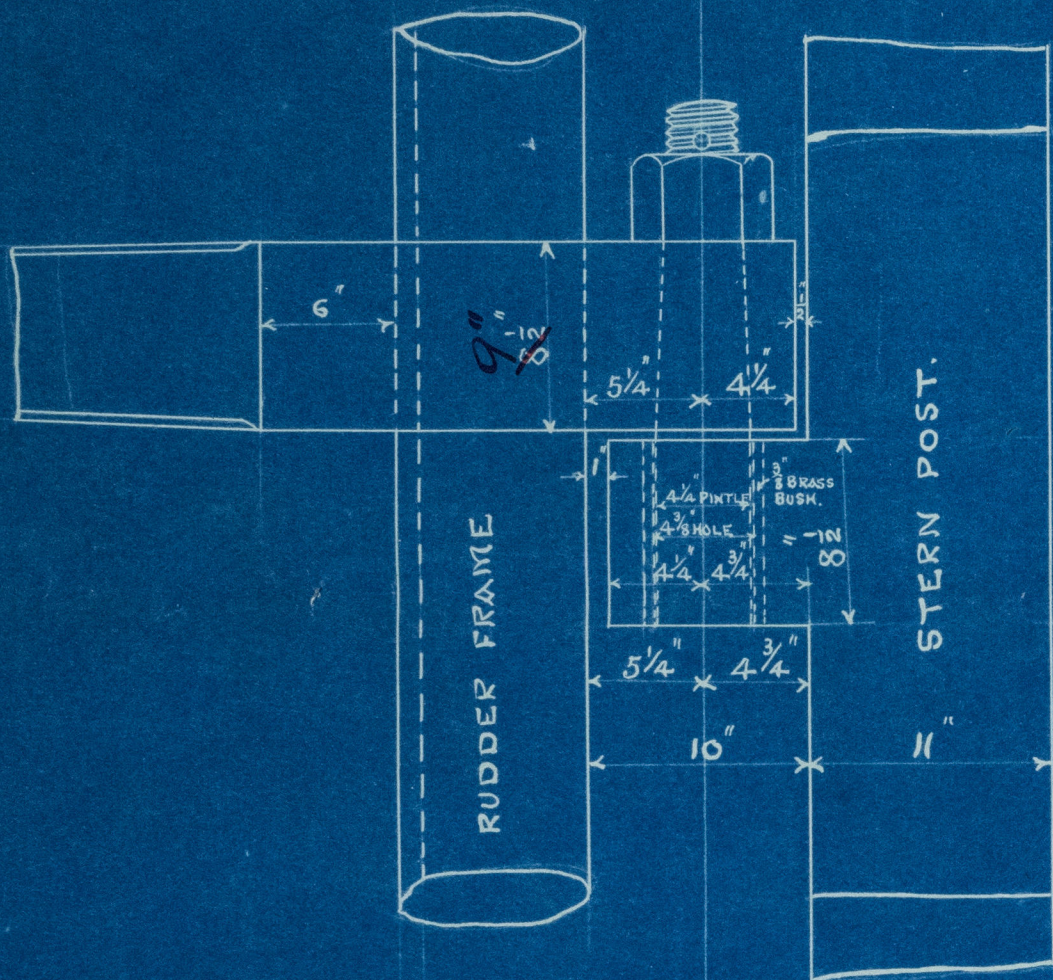

ORDINARY GUDGEON ON STERN POST.

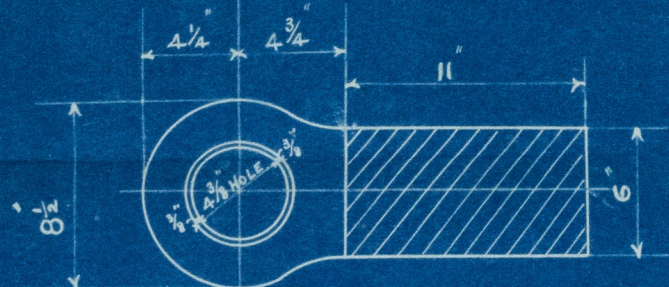

STOPPER GUDGEON AT "A.A."

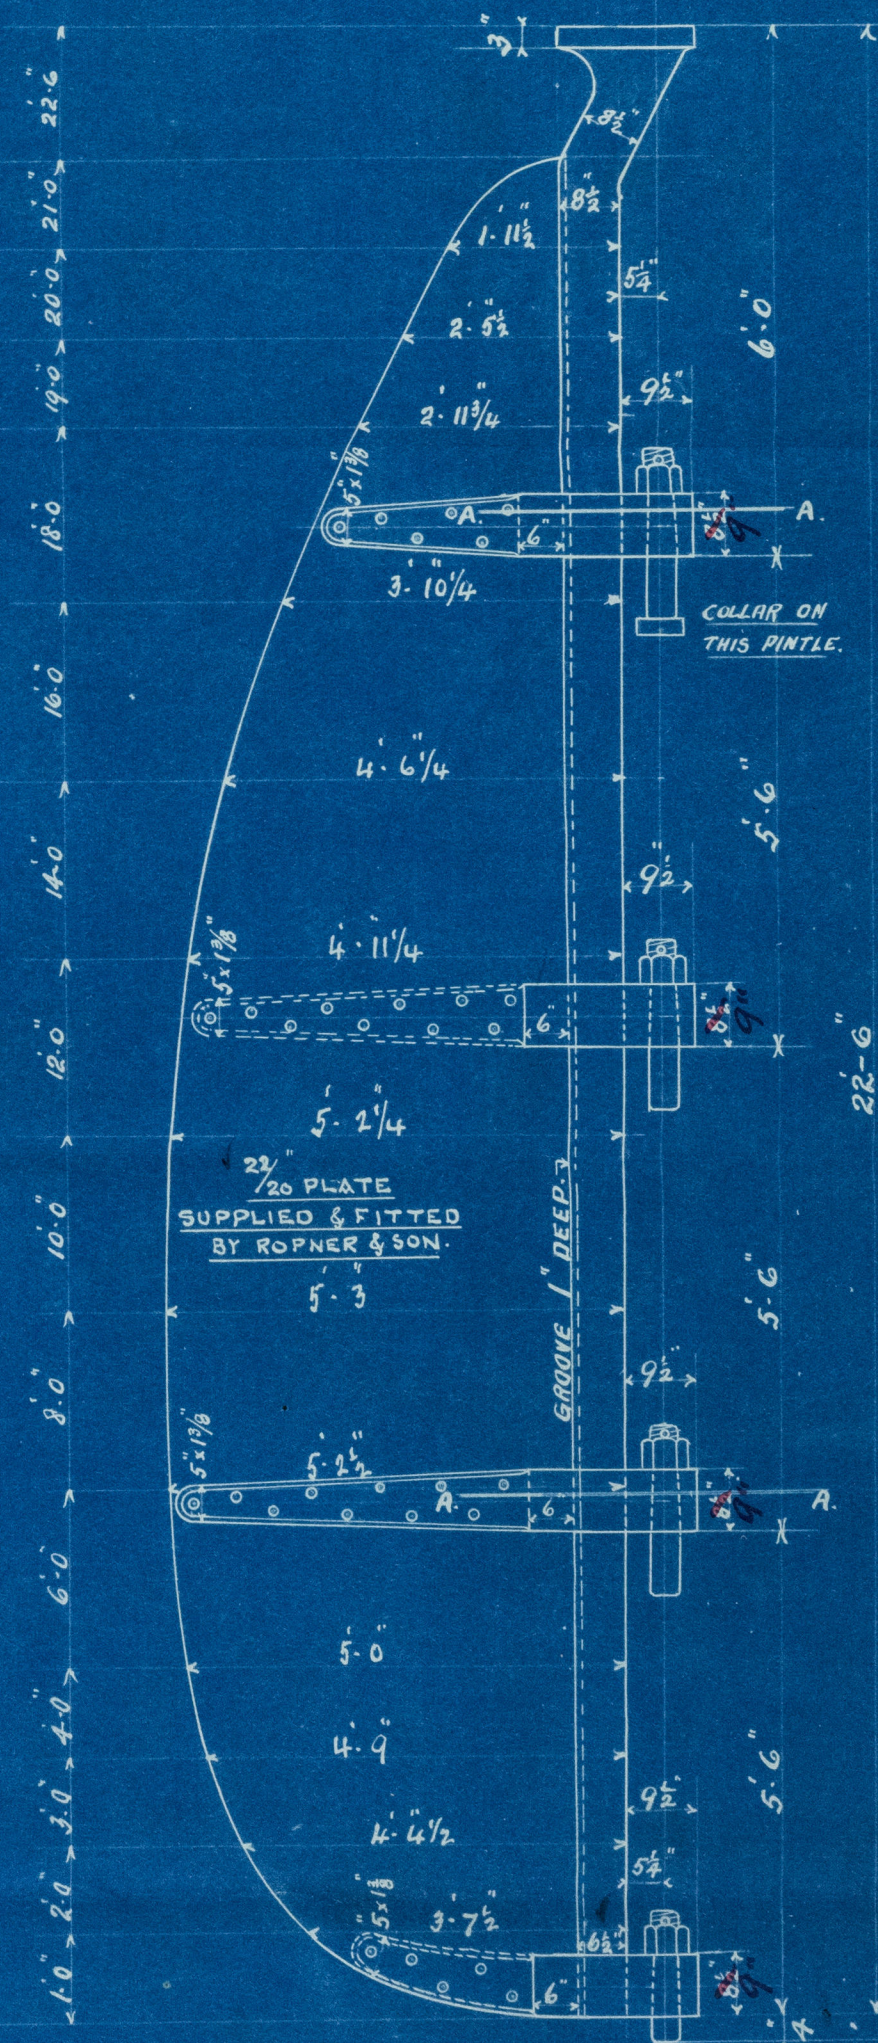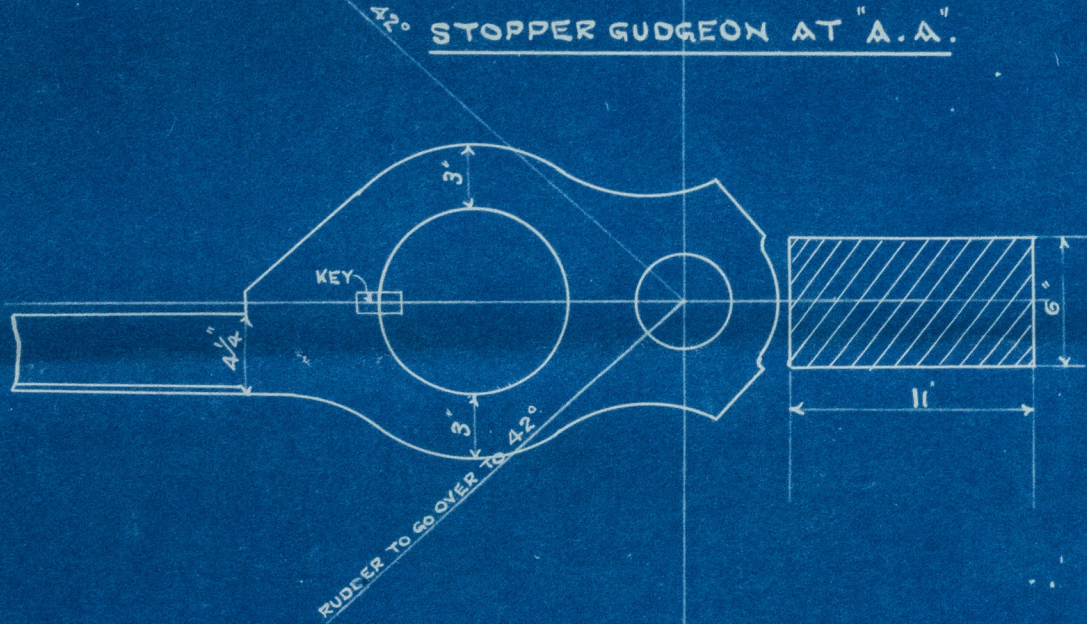

Nº 354.



R. Roper & Son
S/S. "Greenwich"

Single plate
coupled rudders
(without head)

Barris Report No. 4261.

To be made by
Central Marine
Dept. —



© 2021

Lloyd's Register
Foundation