
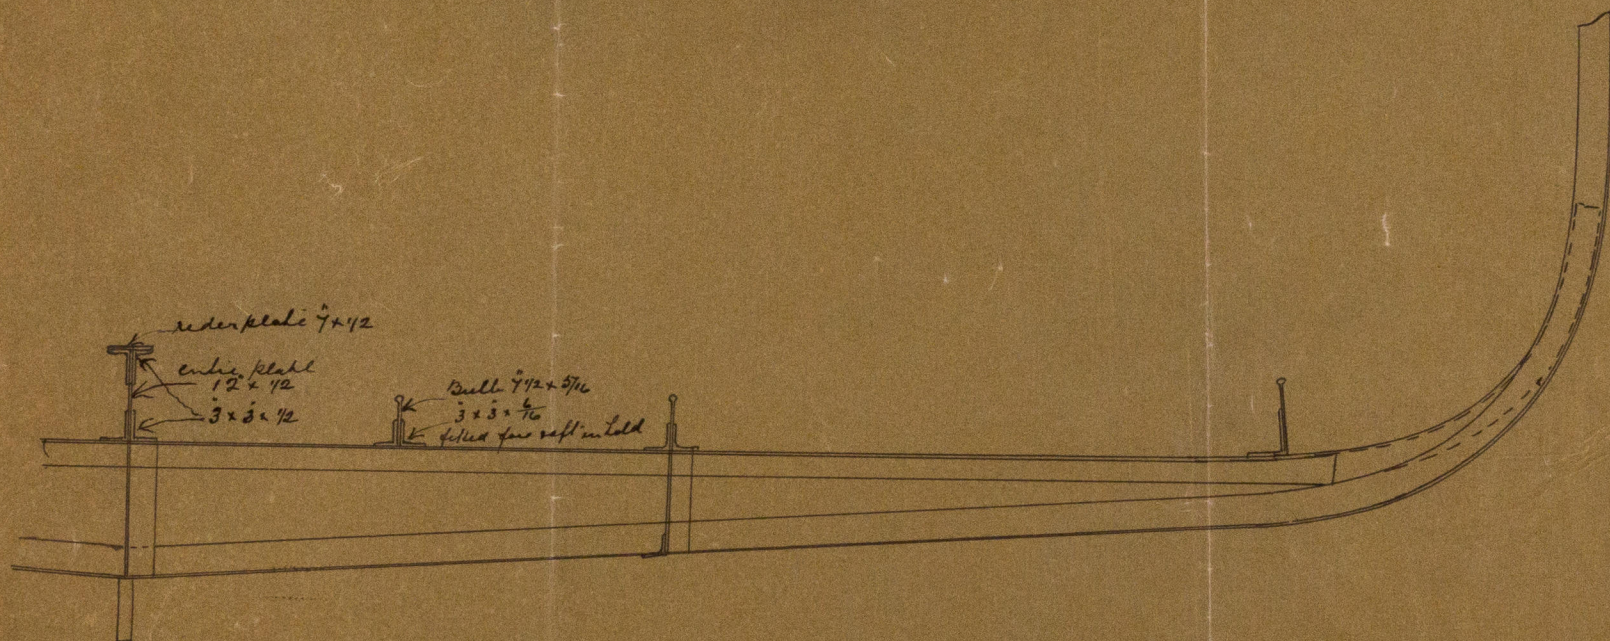


Showing the alterations in Reelions of the Steamer  
 "Treleigh" Owners Bain & Co.

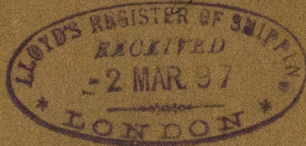

© 2019

Lloyd's Register  
 Foundation

FAL137 - 0093