P 45
20

Cargo boat 181 R

Modified bridge and casings

Scale 1:100

13716 16-11-98

Longitudinal section

External sides of upper casing plating 5/16 vertical stiffeners 3 x 2½ x 7/16 30 apart; Wood deck 2½ on collins steel deck 3/8 on engine, galley, donkey boiler, on 5 x 3½ x 9/16 beams spaced 30 apart on boilers casing with steel covers

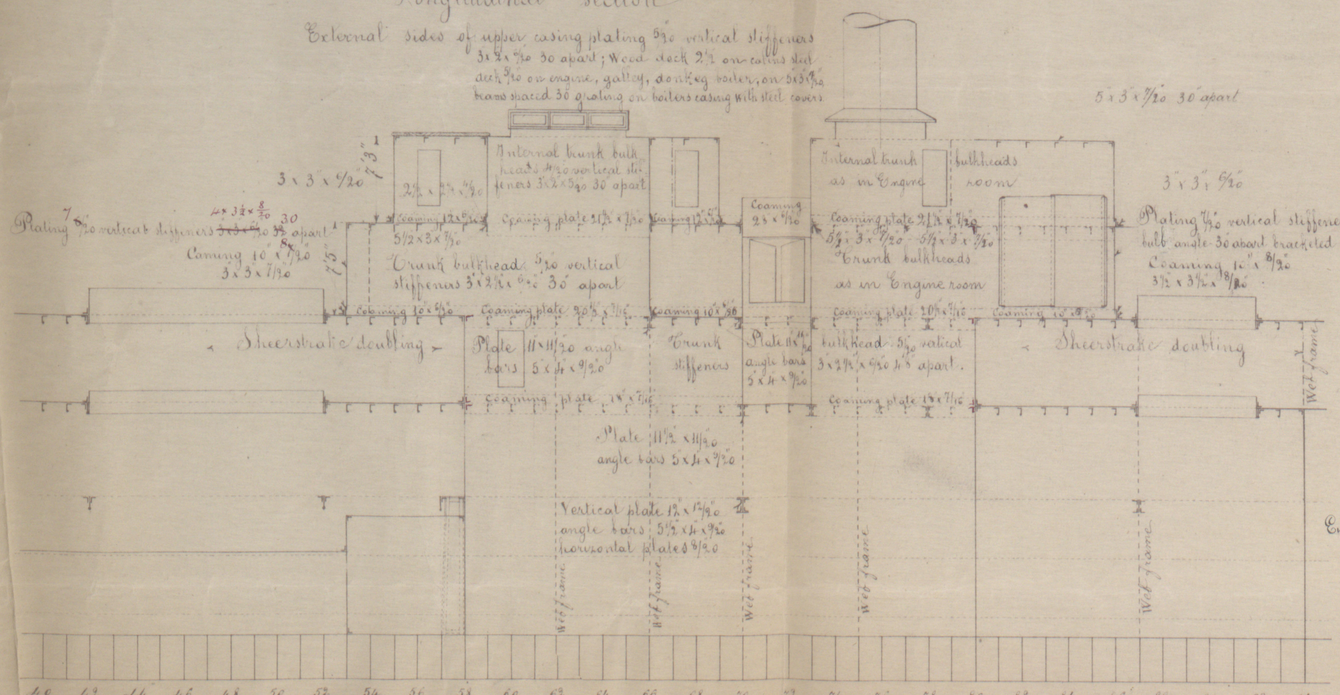

Engine & Boilers space and deep tank shall may be transfered two or three frame spaces for conveniently trimming vessel.

Section of casings

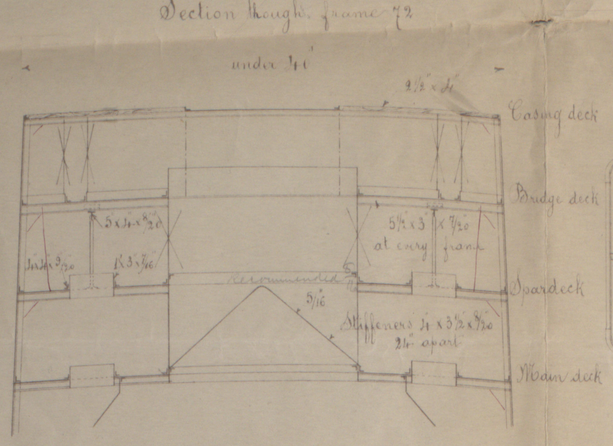

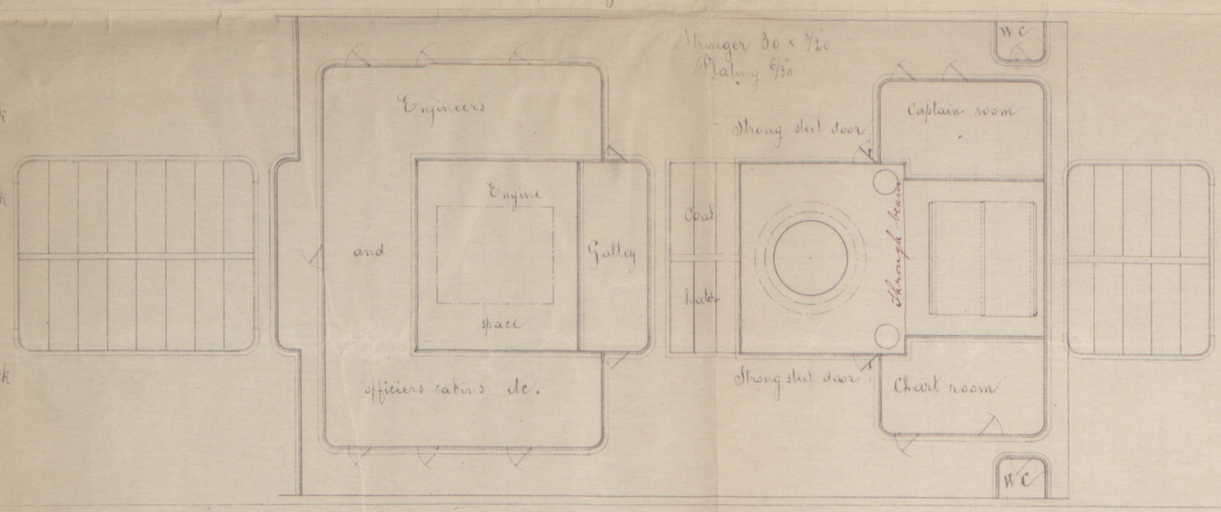

Section between decks

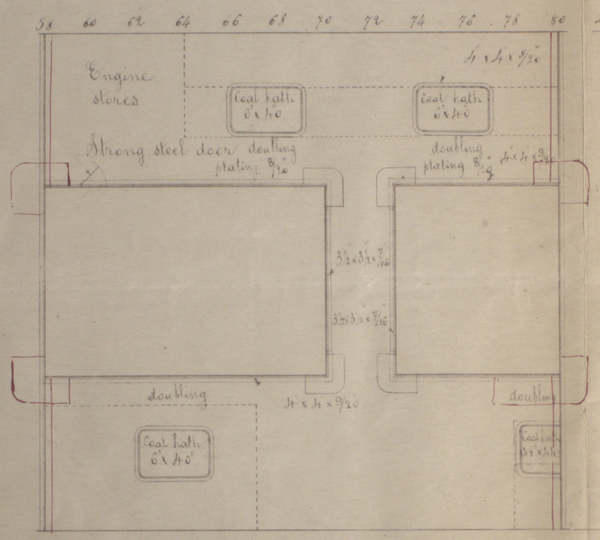

Section of bridge

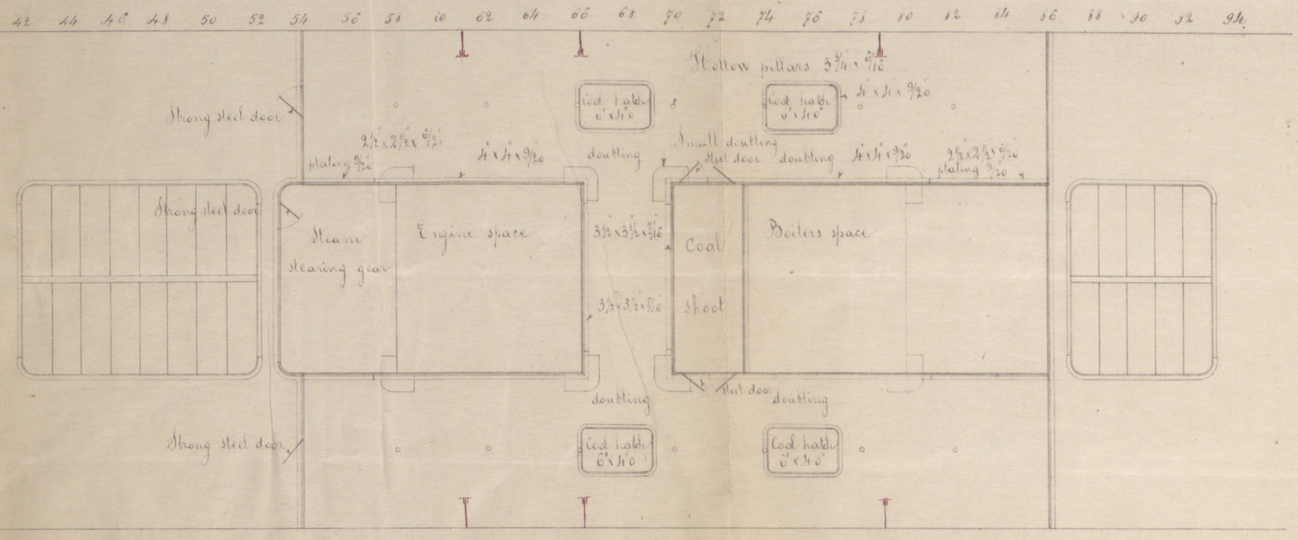

Section through frame 72

GEN1114 - 0030

© 2020 Lloyd's Register Foundation