

*S.S. City of Calcutta*  
*Glasgow Report No. 3336*

# MIDSHIP SECTION IRON SCREW STEAMER No 125

SCALE 1/2 INCH PER FOOT

NUMERALS	EQUIP. NUMERALS
20.87	30.37
32.16	32.16
47.70	47.70
100.73	100.73
7.00	398.5
93.73	303.5
398.5	80.384
64.84	302.19
74.94	15) 40.140 (2676
84.55	30.37
39.19	30.37
37.35	30.37


DIMENSIONS		
	FT.	IN.
LENGTH AS PER RULES	398.5	OR 398.5
HALF MOULDED BREADTH	20.87	20.87
CIRTH OF HALF MIDSHIP FRAME	47.70	47.70
DEPTH FROM TOP OF KEEL TO U. DECK	32.16	32.16
" " " " FLOORS	29.97	29.97
" " " " L.	14.83	14.83
" " " " KEEL	24.50	24.50

EXCESSIVE PROPORTIONS		
DEPTHS IN LENGTH TO UPPER DECK	12.39	
" " " " MAIN	16.26	
BREADTHS IN LENGTH	9.54	
NUMERALS	37.351	98.73
" FOR EQUIP.	42.816	37.357

## ANCHORS AND CHAINS ETC.

4 BOYERS	COLL. HEIGHT	159 1/2 CHT.
1 STREAM	"	12 1/2 "
1 KEDGE	"	6 1/2 "
1 "	"	3 1/2 "
300 FATHOMS	2 1/2 "	STUD CHAIN CABLES
90 "	1 1/2 "	STREAM CHAIN
90 "	12 "	TOYLINE
90 "	12 "	TRAP
90 "	8 "	"

TO CLASS 100 A.1. AS A THREE DECKED CARGO STEAMER

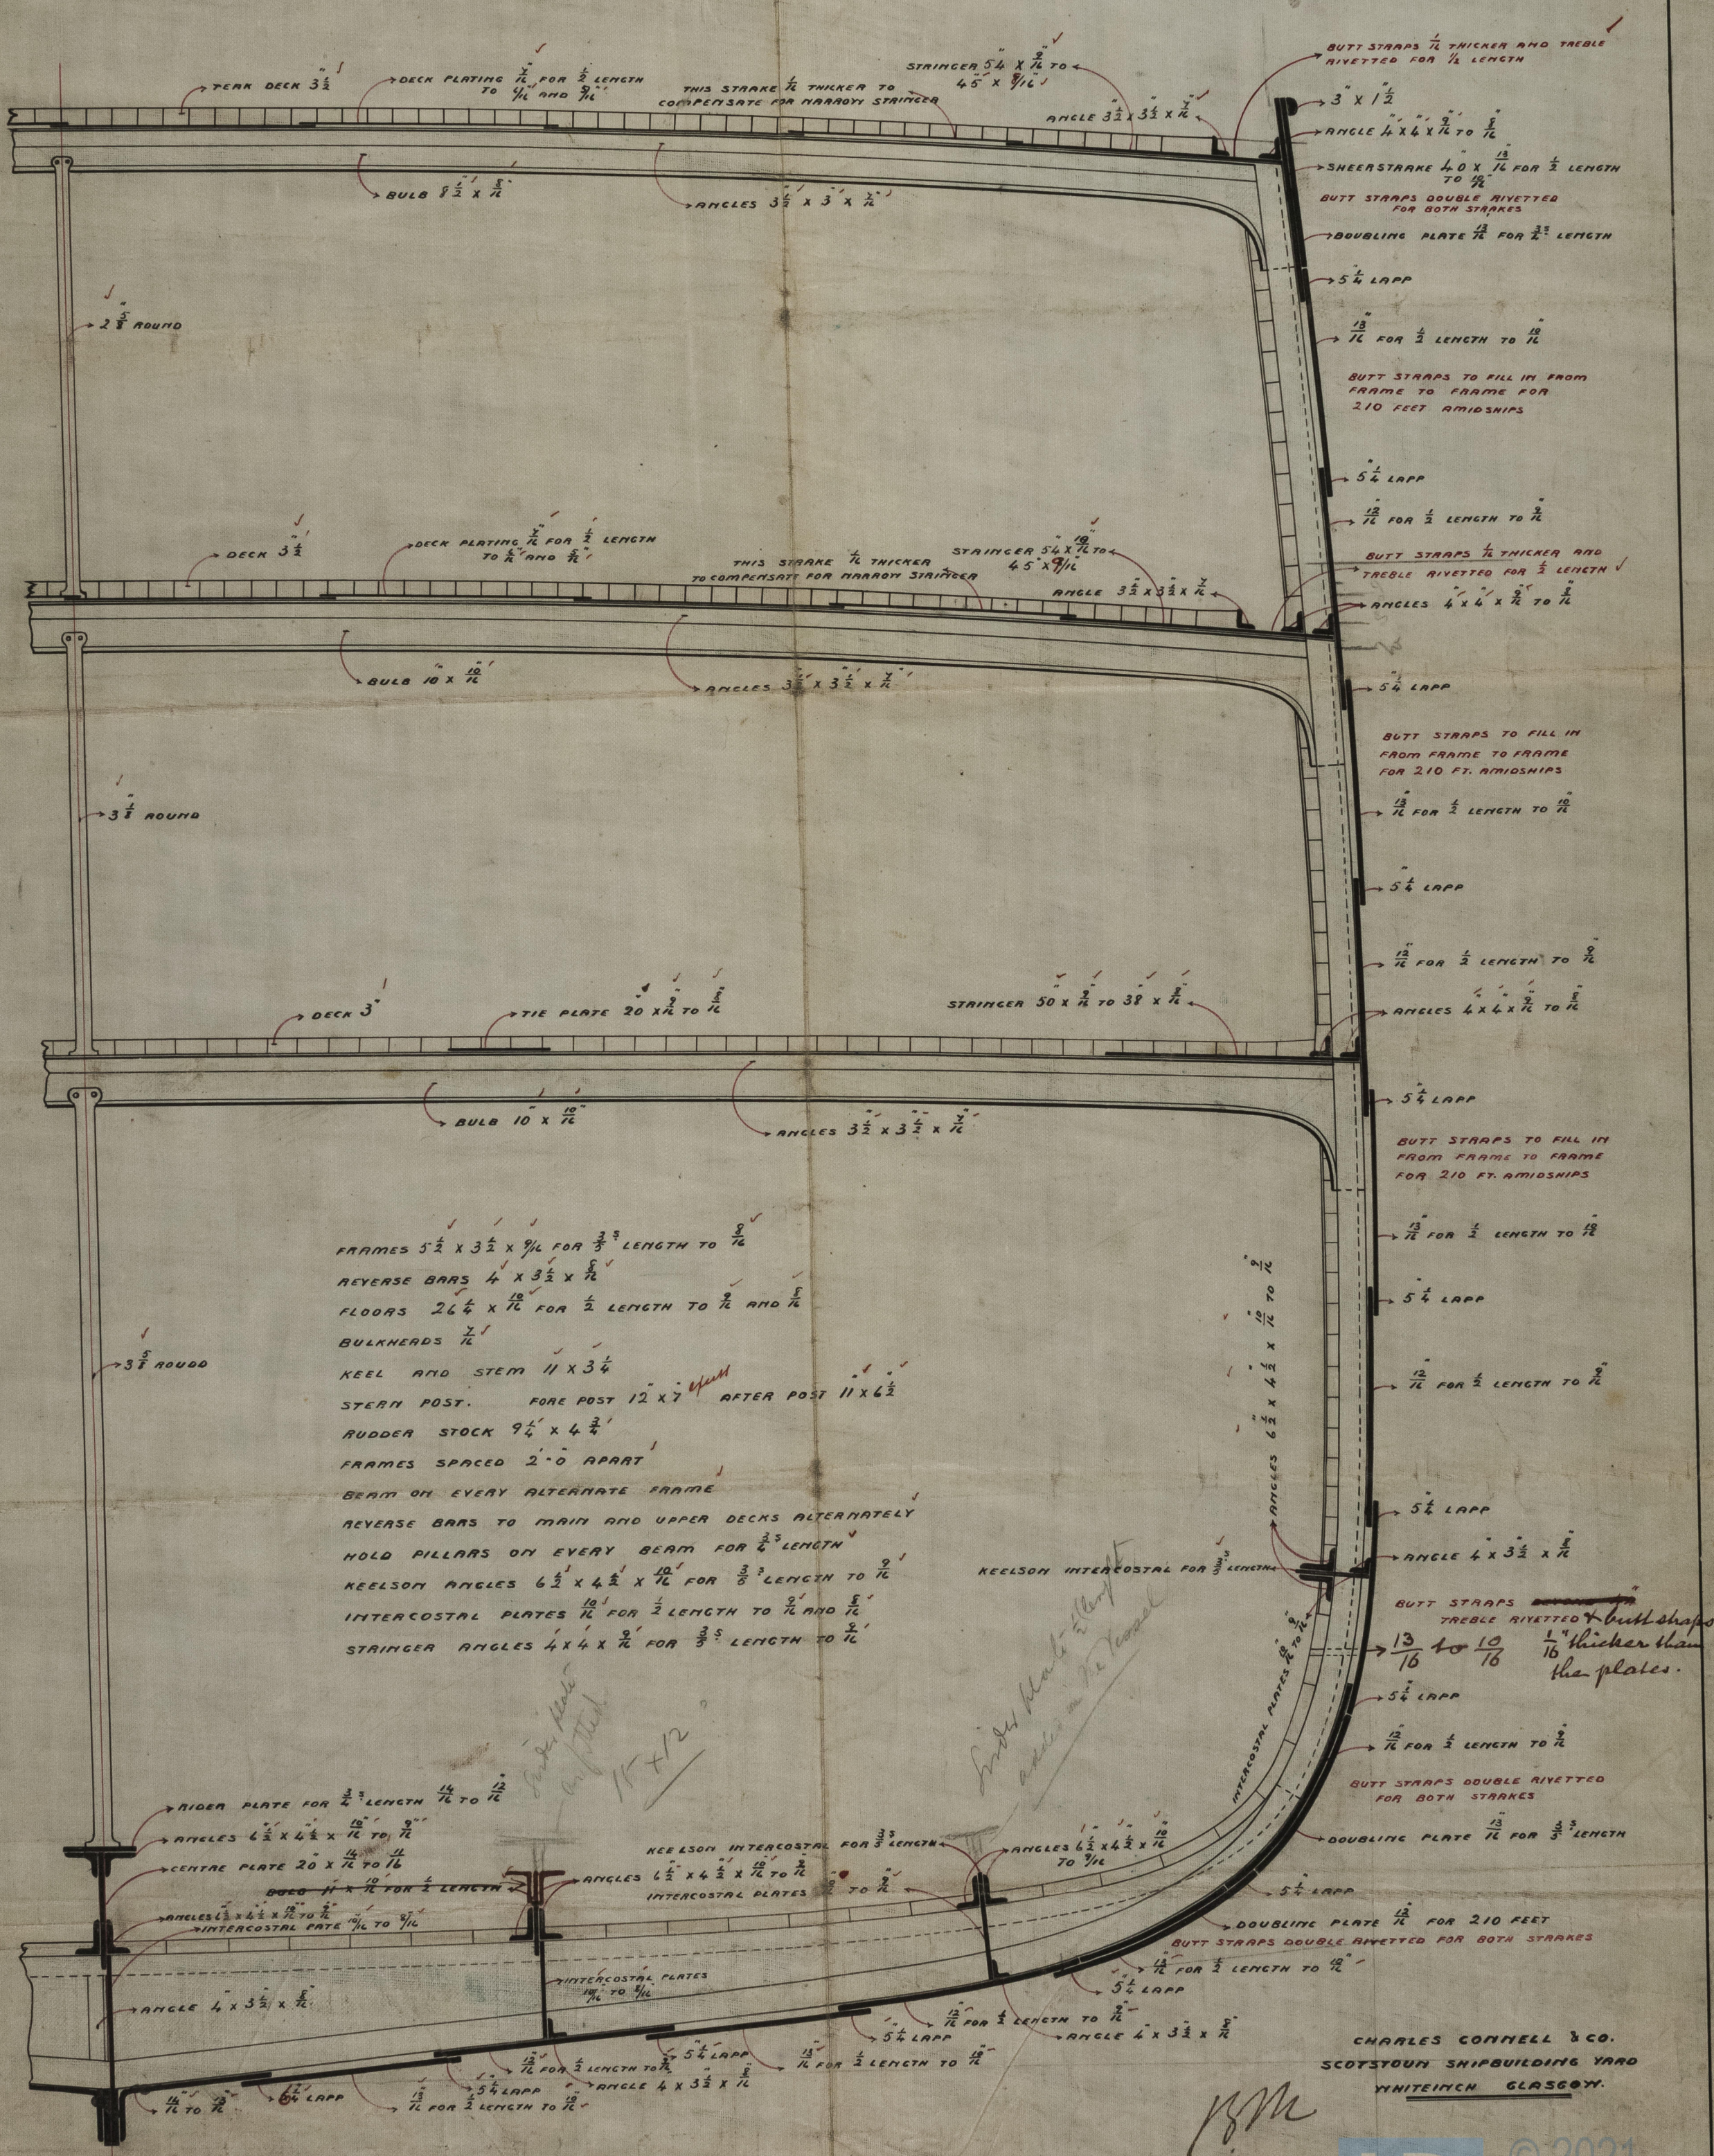

CHARLES CONNELL & CO.  
 SCOTSTOWN SHIPBUILDING YARD  
 WHITEHALL GLASGOW.