




Lat: 54.0
19/6/83.
35/6/83

NO 40
Steel Masts & Yards
Plates marked $\frac{1}{16}$ Iron & $\frac{1}{32}$ Steel
Scale $\frac{1}{4}$ = One Foot
12/6/83

Birrell, Stenhouse & Co.
Shipbuilders,
Dumbarton.

Ship "Benvenue"
Glasgow Report
No 6444.

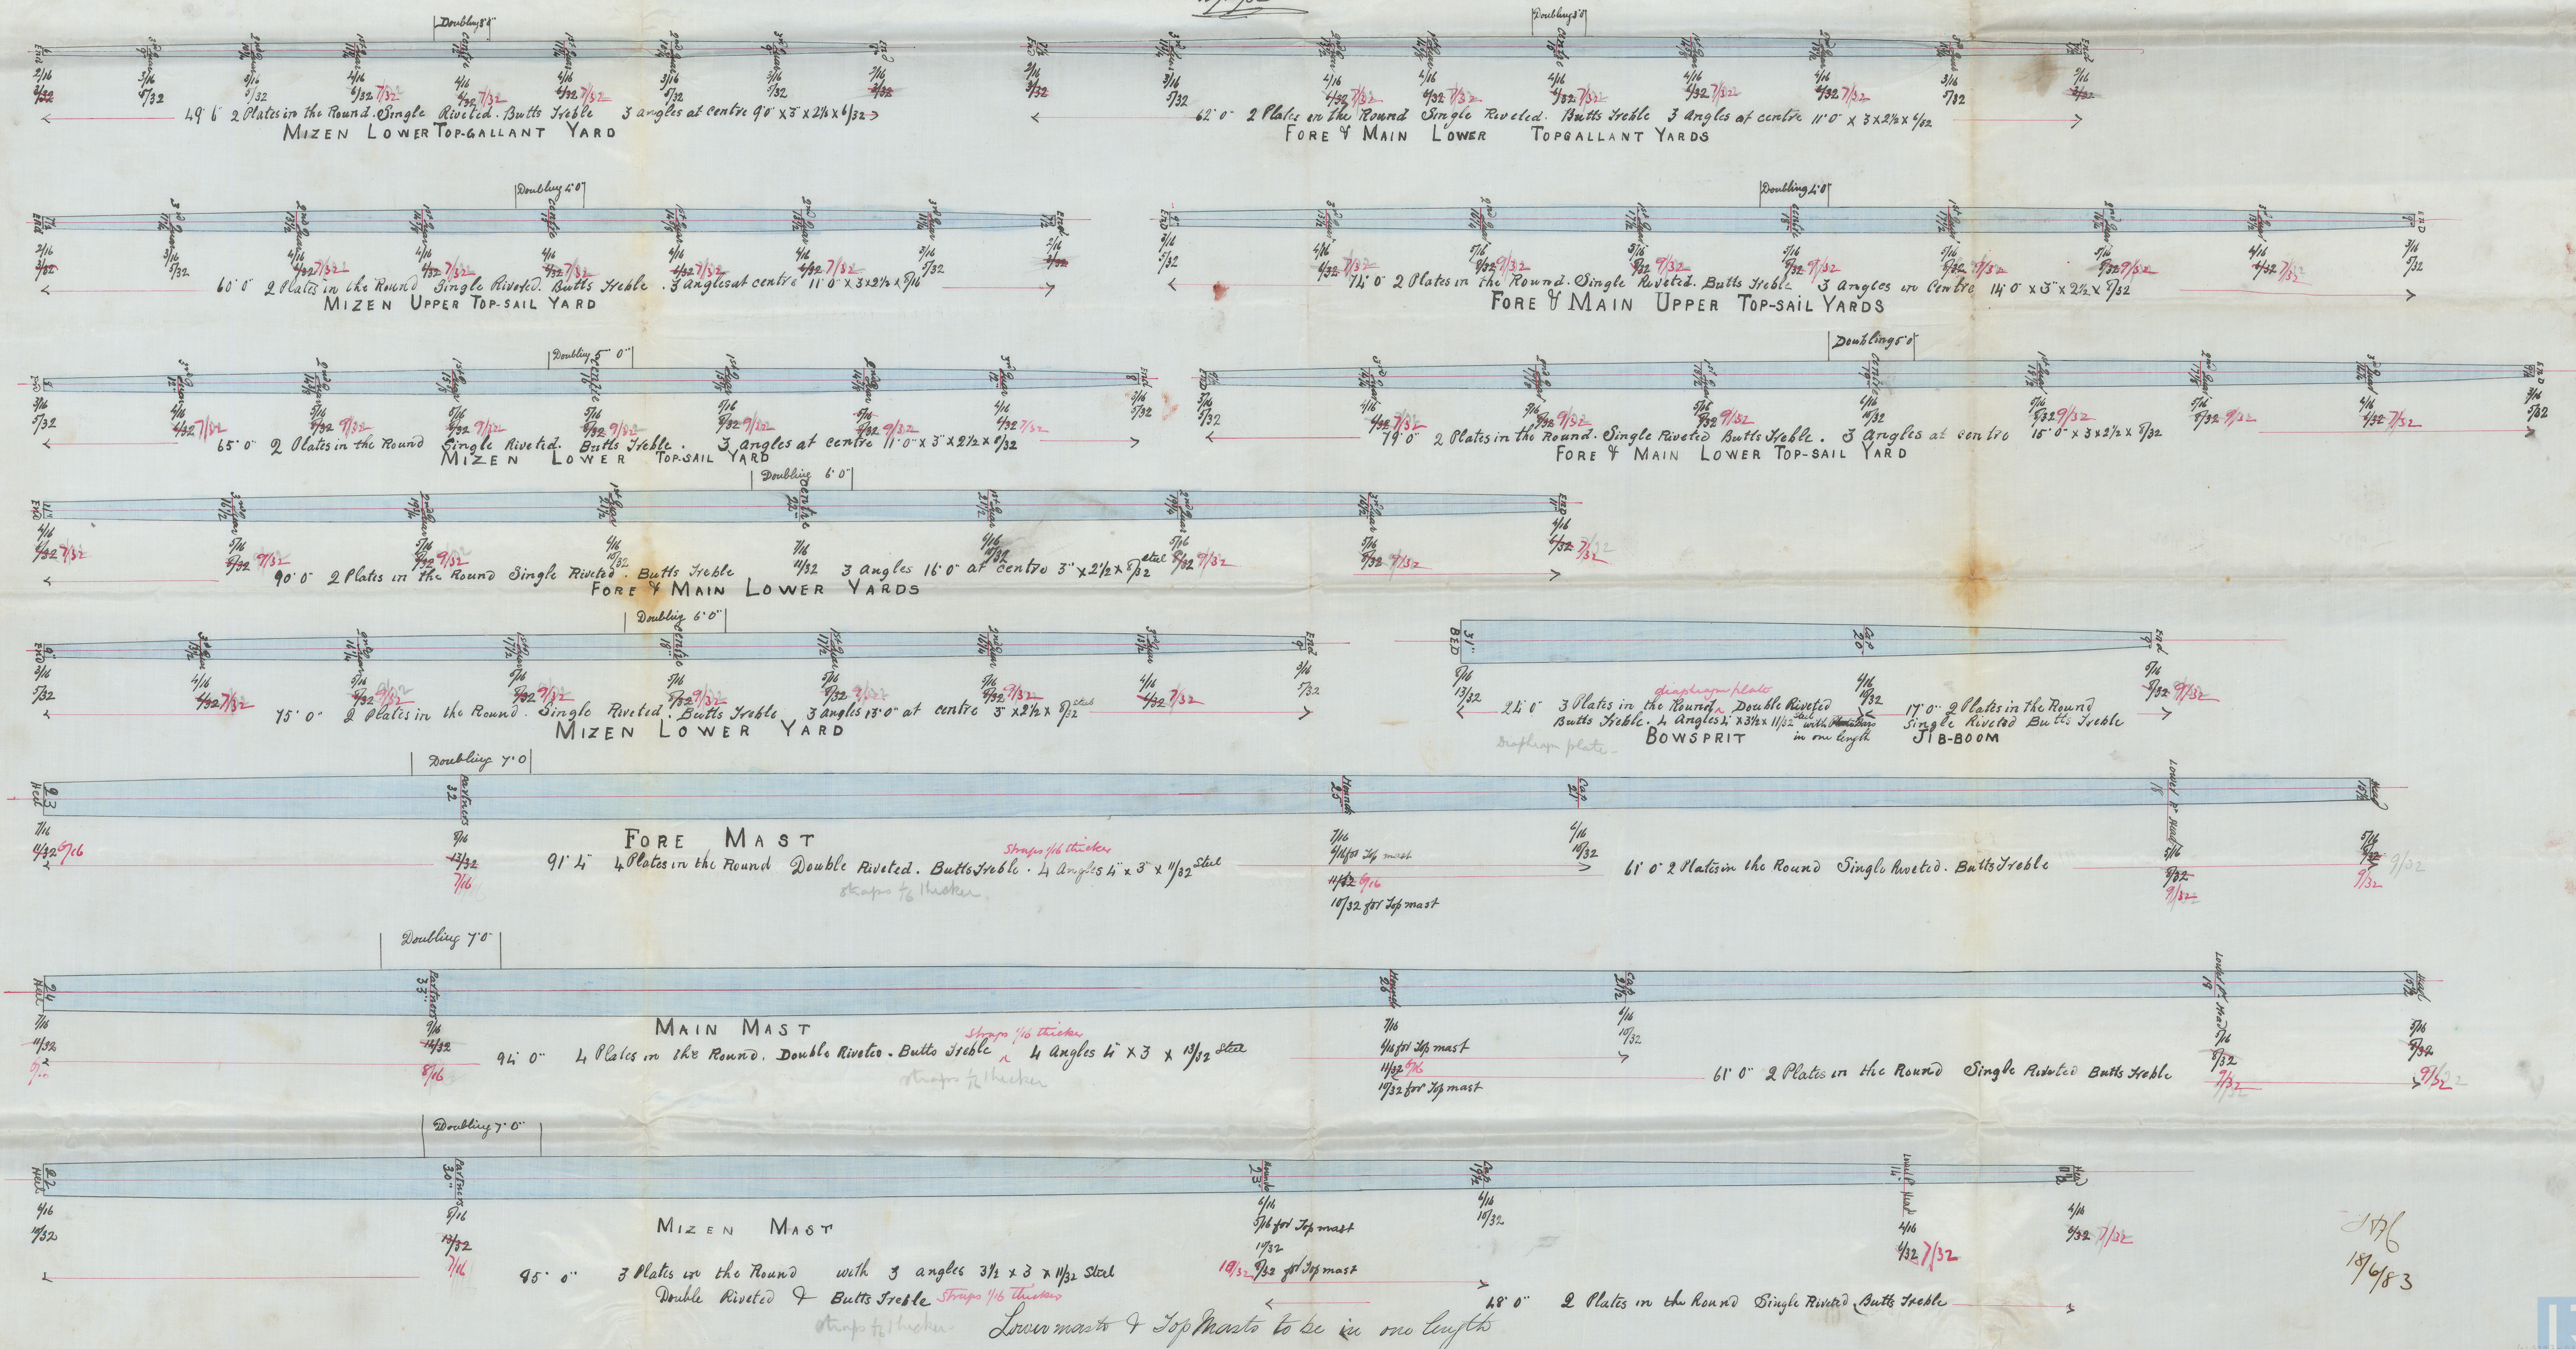

2176
19/6/83