



25 JAN 84
 19 MAR 84
 23/1/84
 19/3/84


Raised Quarterdecks

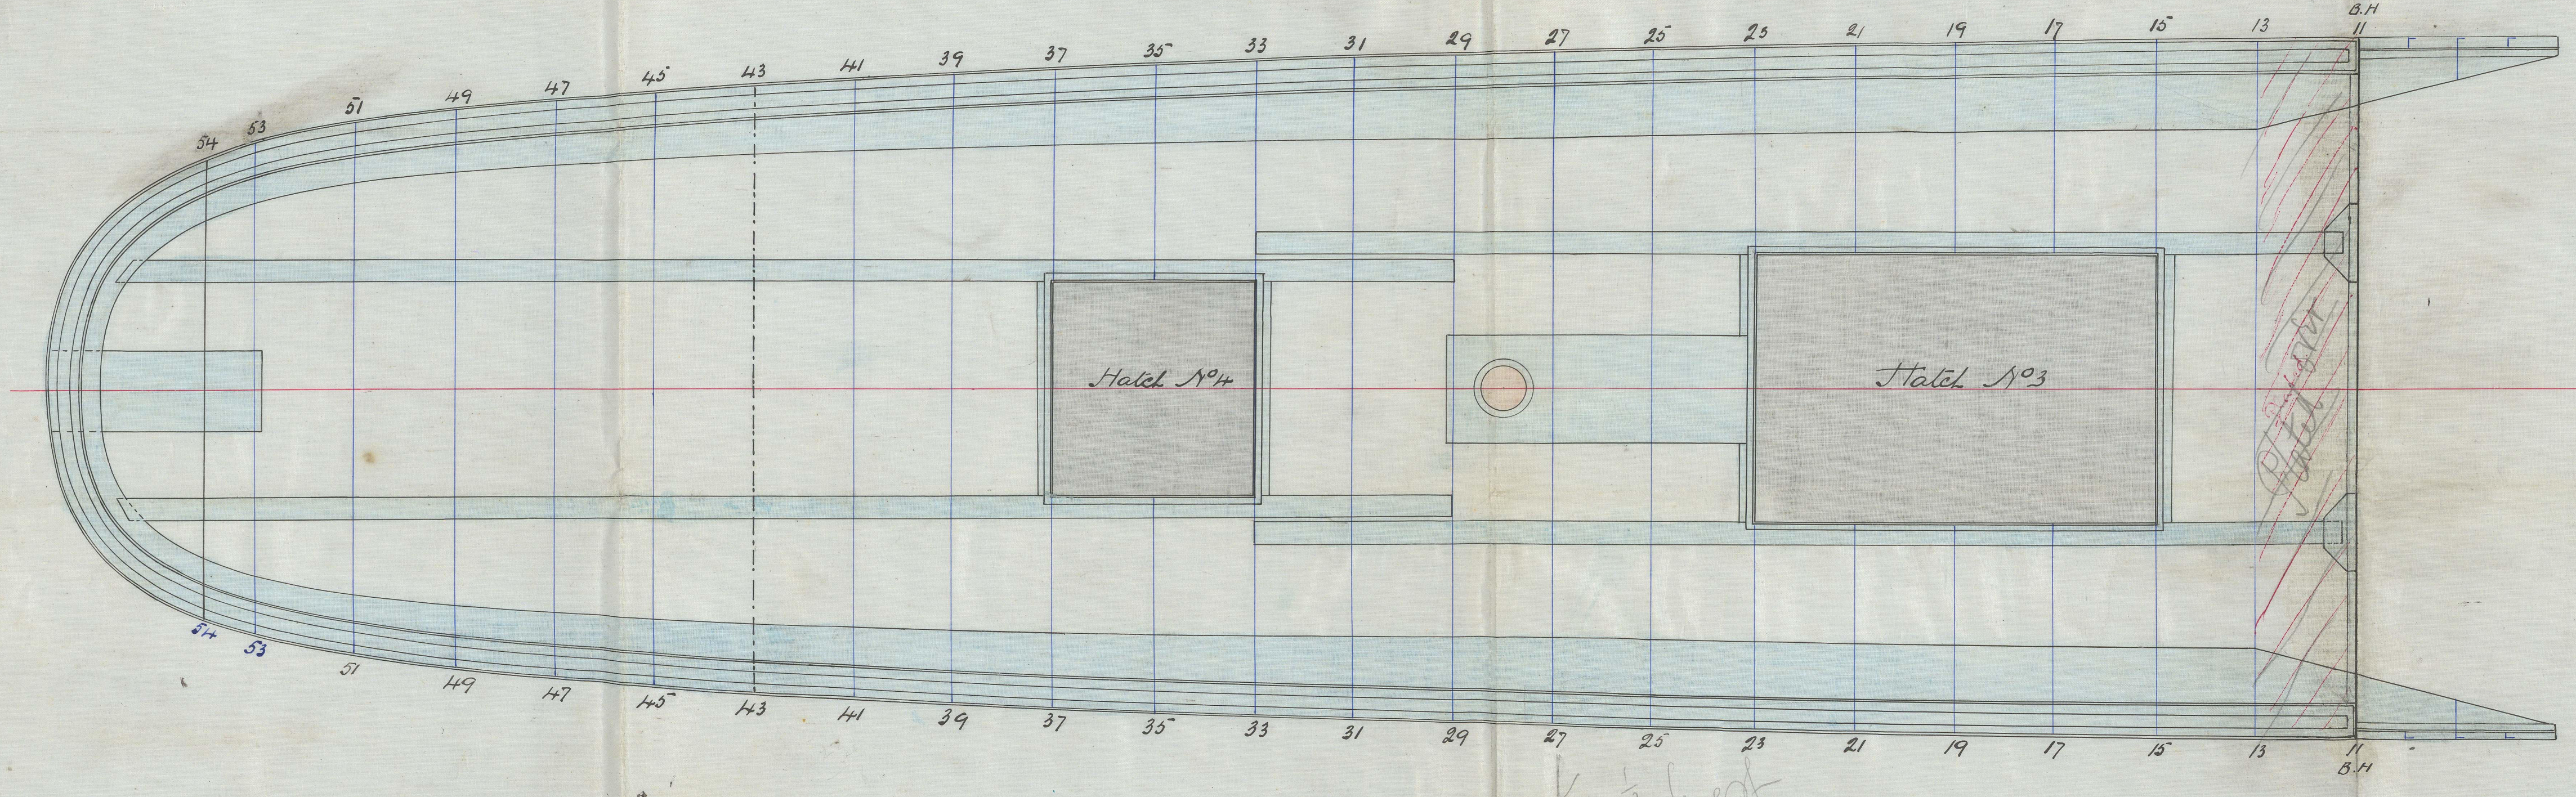

PLANS OF IRON DECKS & STRINGERS S.S. N° 133

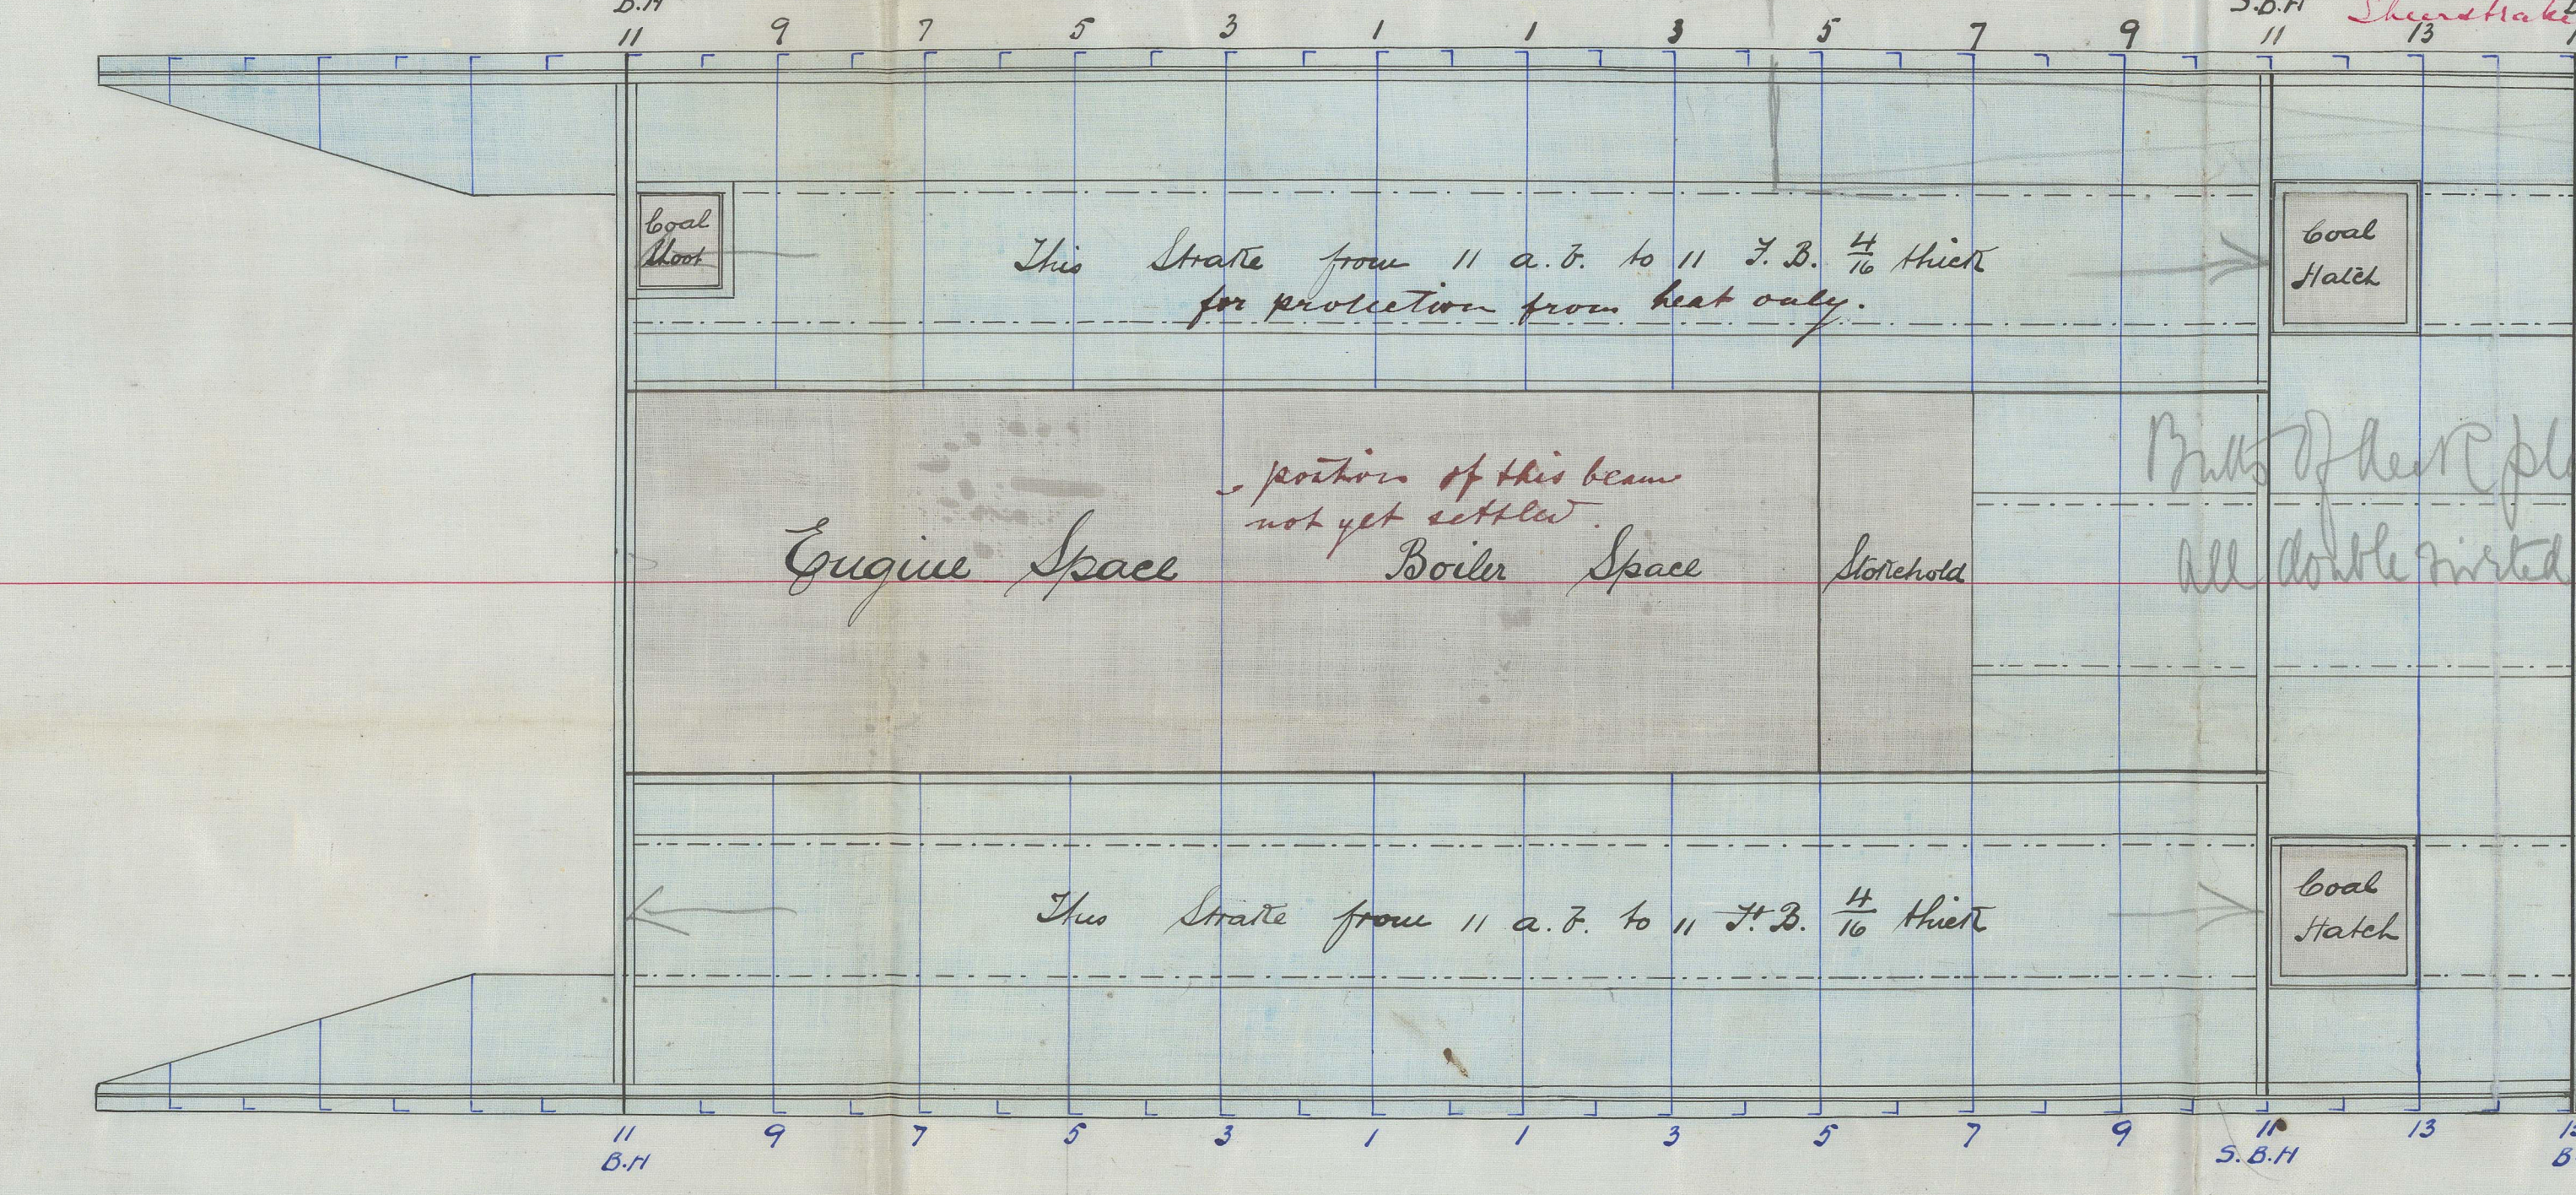



Main Deck

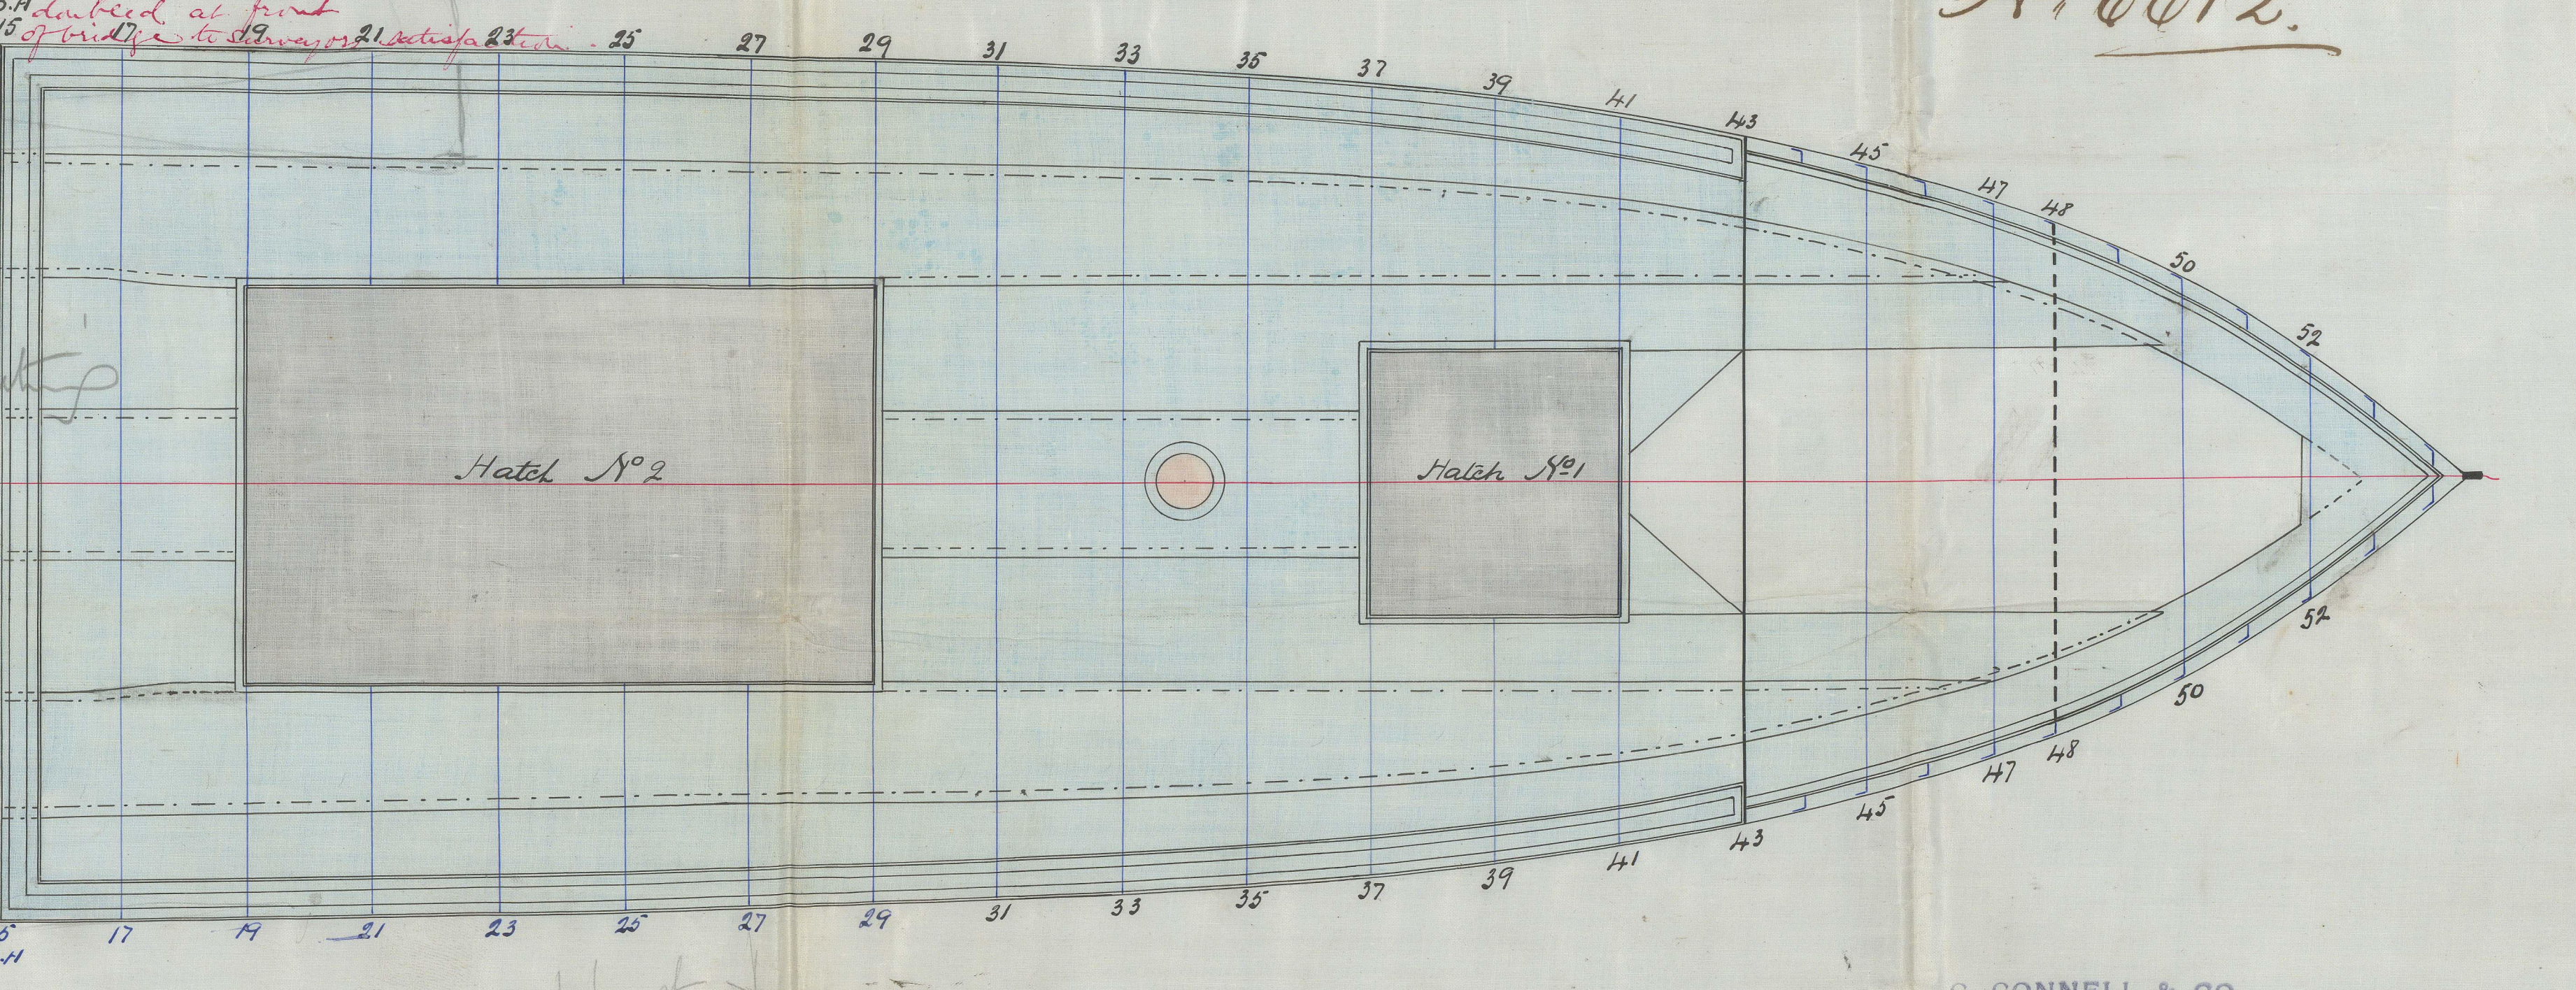

S.S. "Charles Moorand"
 Glasgow Report
 N° 6612.

C. CONNELL & CO.,
 Shipbuilders,
 GLASGOW.
 21/1/84

Hold Stringers.

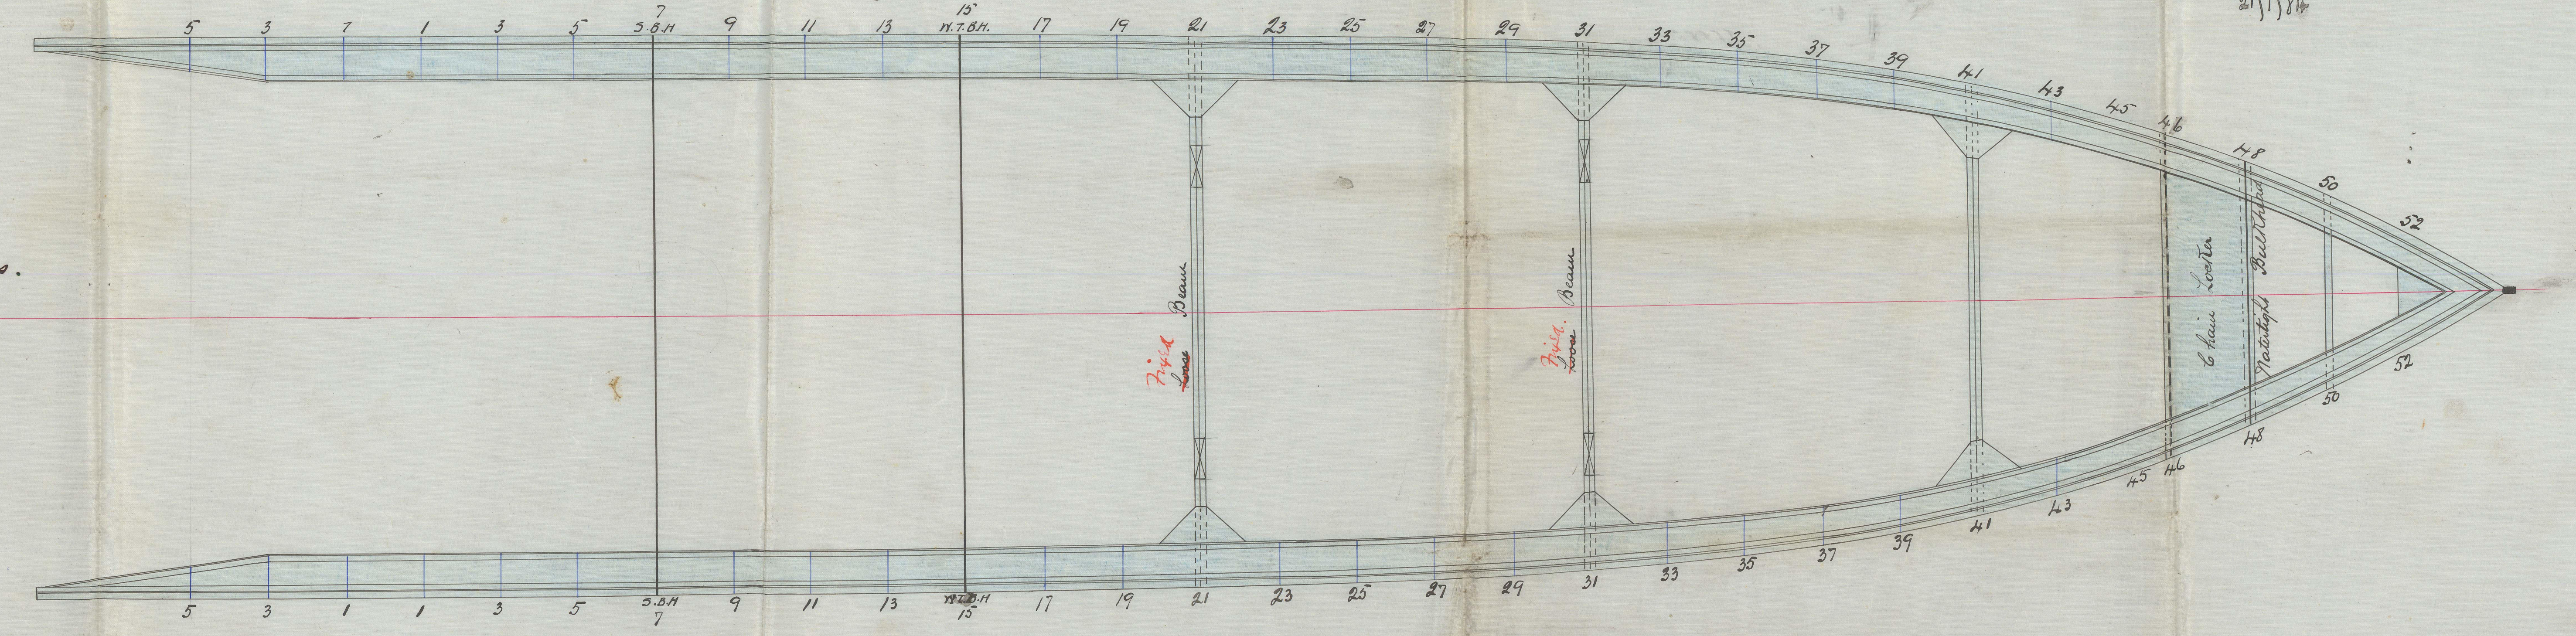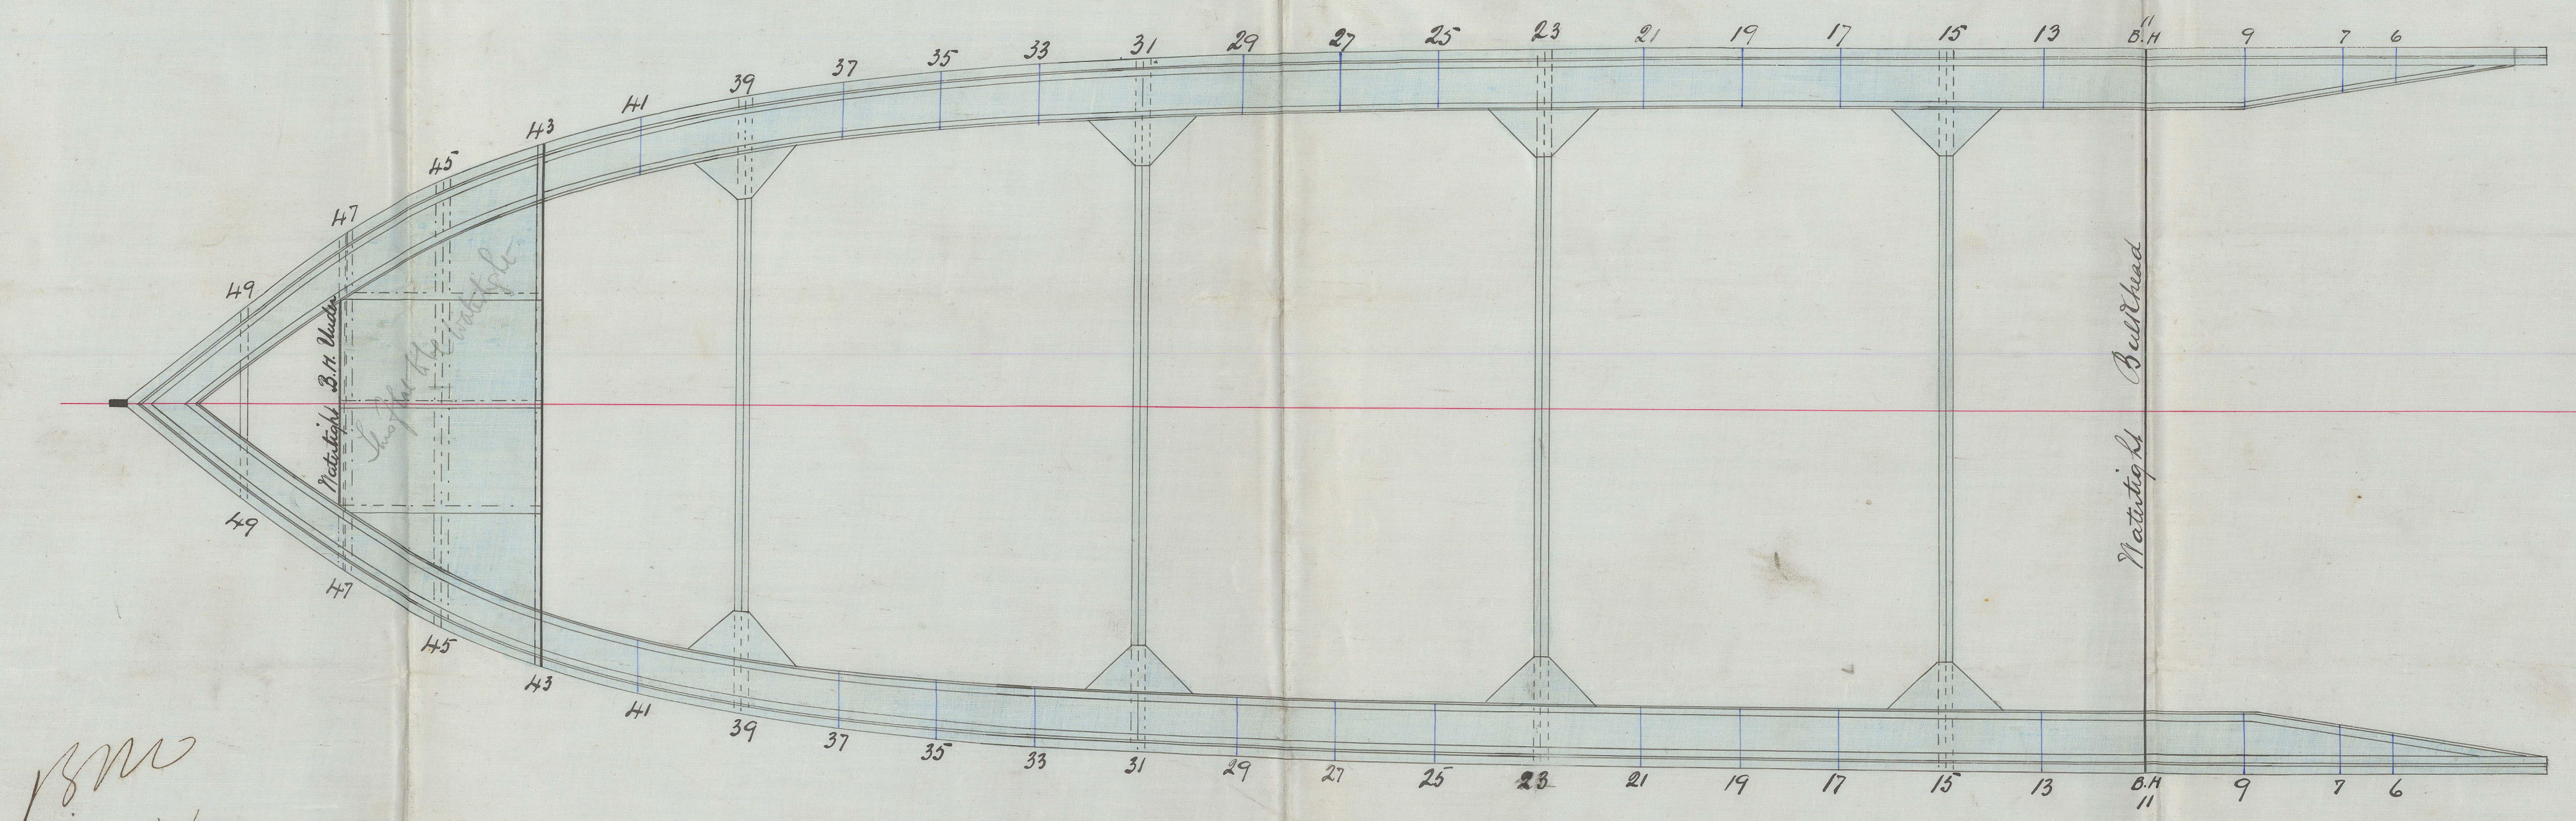

18m
 24/1/84
 19/3/84

Glasgow
 23/1/84