


Ltd Glasgow
23 Apr 184

Arrangement of Pumps S. S. N° 139 "Charles Morand"
Scale $\frac{1}{8}$ in to one foot

C. CONNELL & CO.,
Shipbuilders,
GLASGOW

S. S. Charles Morand
Glasgow Report
N° 6612

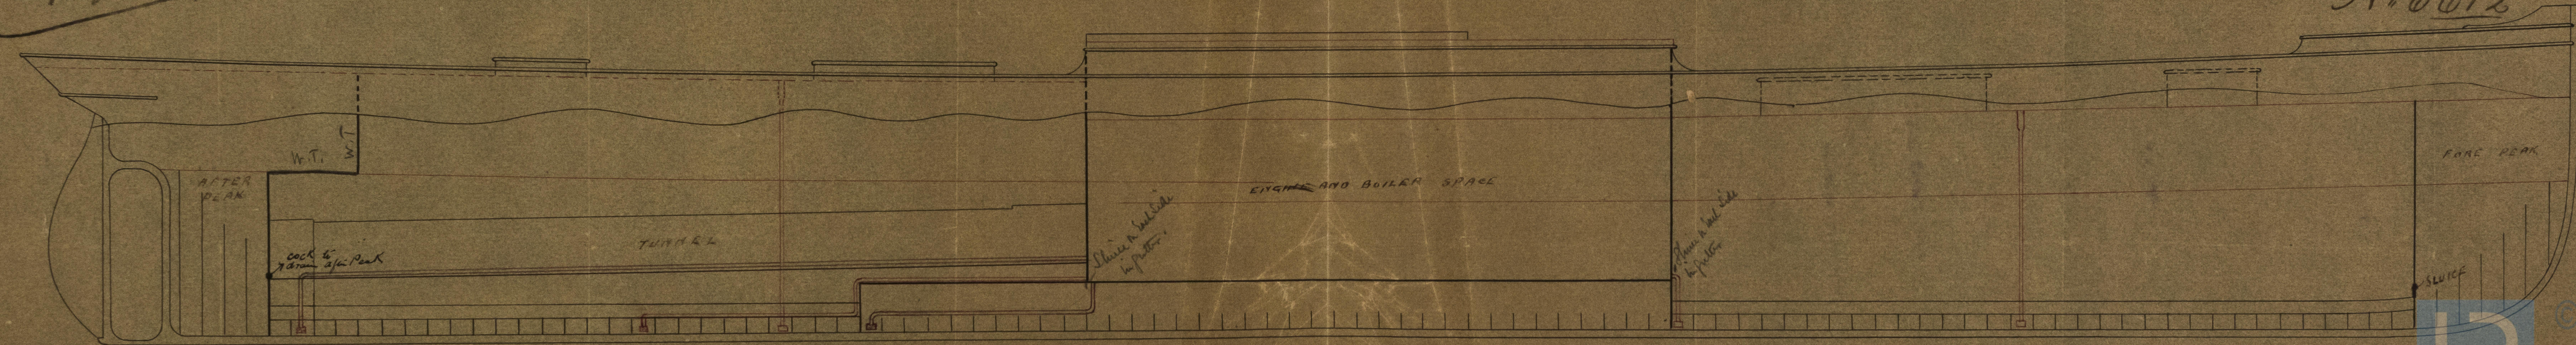

D.S.
23/4/84

Lloyd's Register
Foundation

GLS199-0154