LLOYD'S REGISTER OF SHIPPING
RECEIVED
14 JAN 86
LONDON

14/1/86.

S.S. "Cadiz" Glasgow Report No. 4634.

JM
14/1/86

S S Cadiz

JOHN & JAMES THOMSON
ENGINEERS
FIDDLER'S FERRY & SQUINE WORKS
GLASGOW
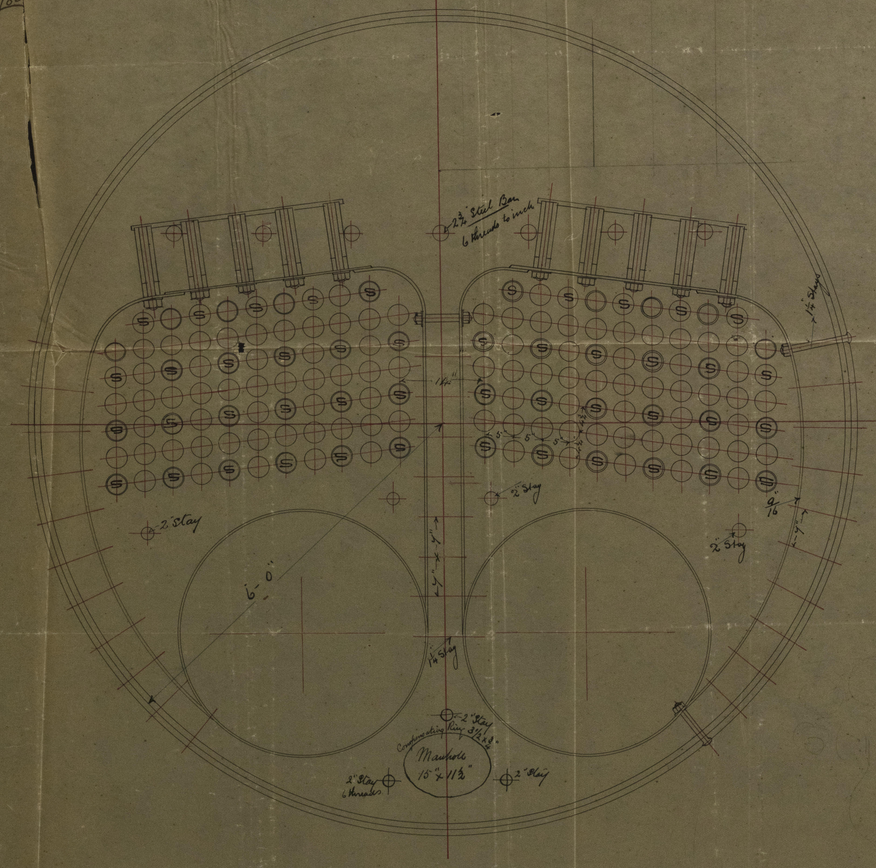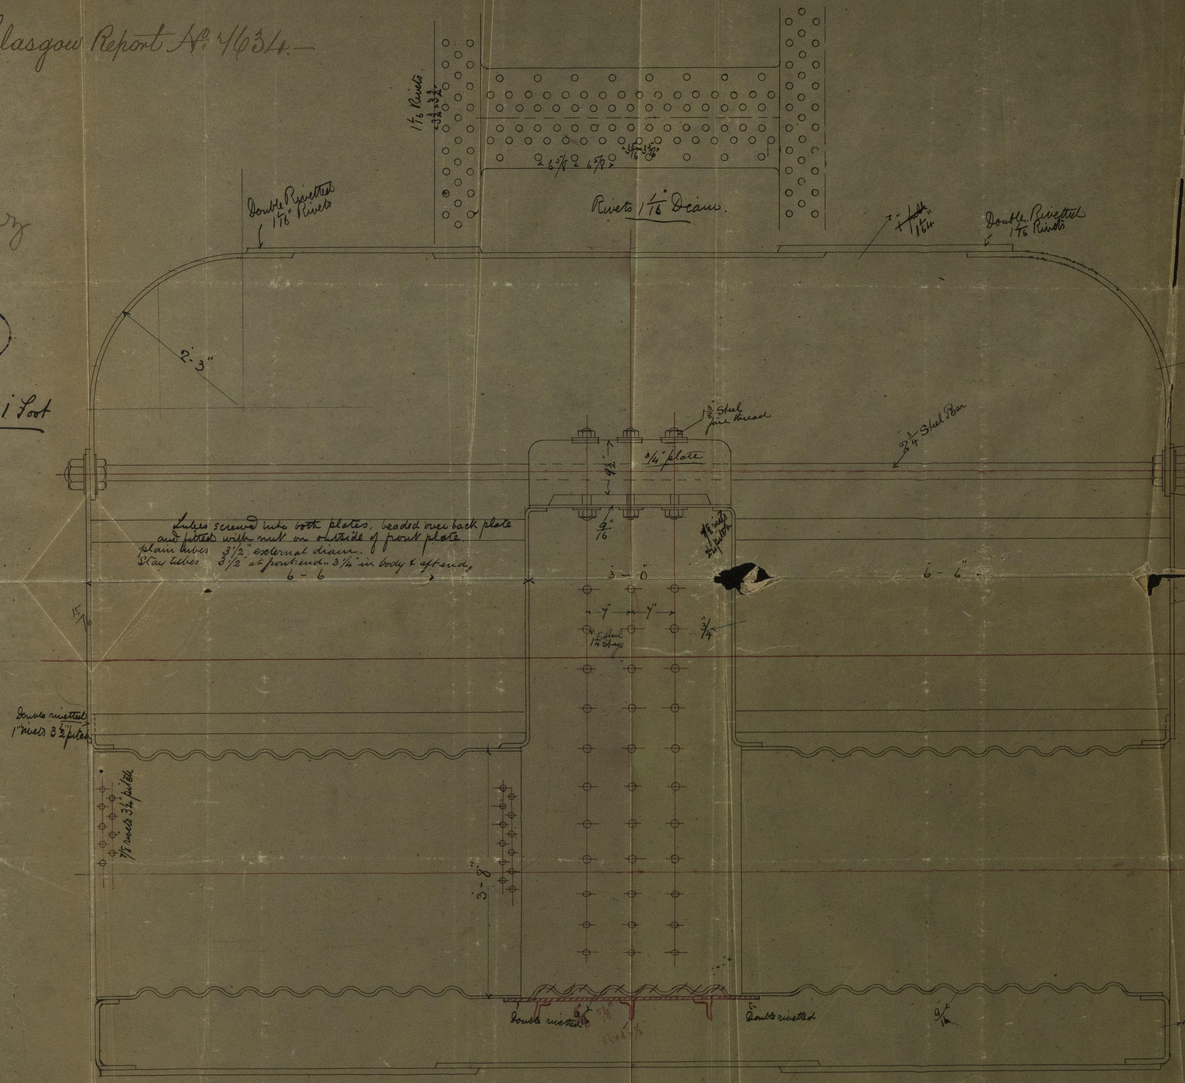
Scale 1 inch = 1 Foot