



S.S. "Vascongada"

3.2.87.
10.2.87.
13.7.87.

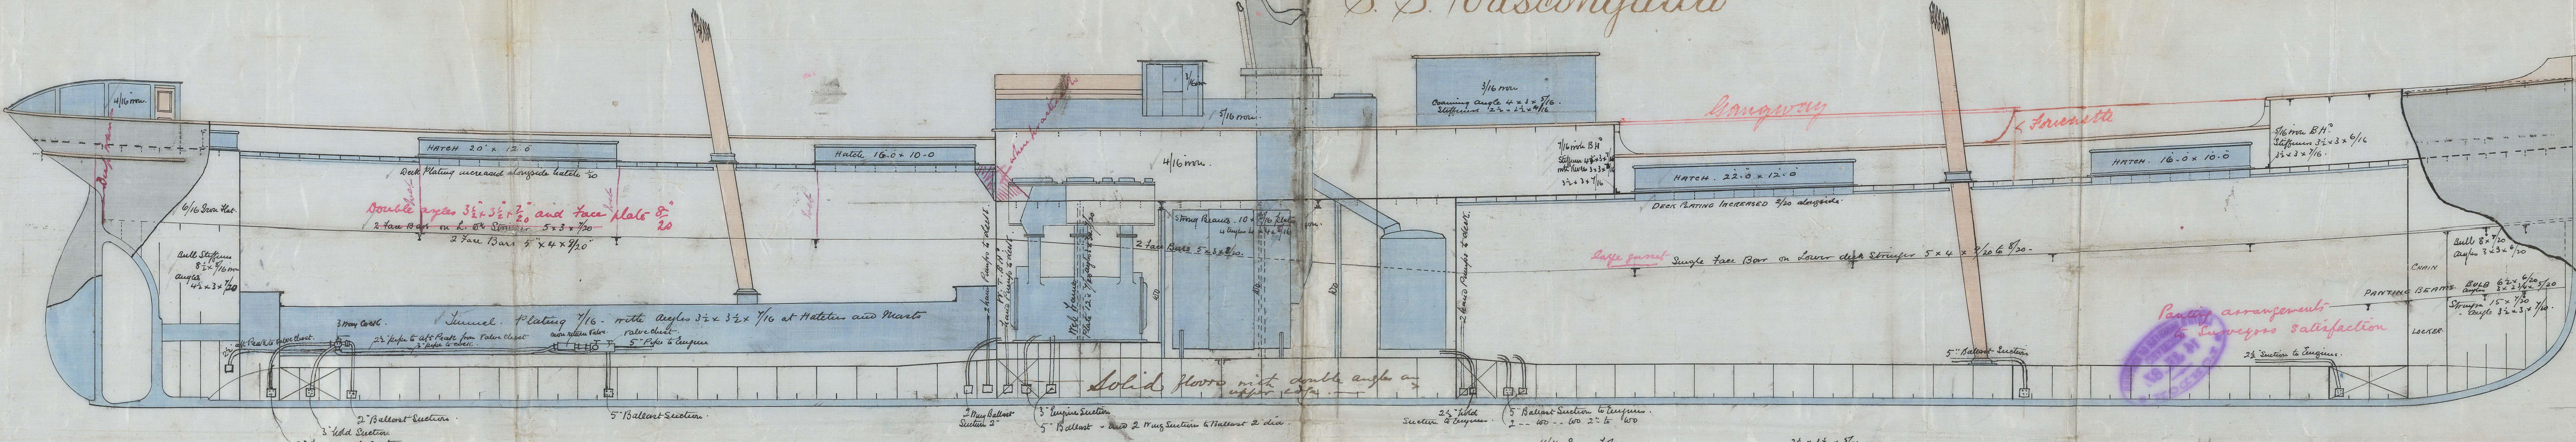

STEEL SCREW STEAMER NO 305, To Class. 100.A.1 at Lloyd's.

SCALE 1/2 INCH TO A FOOT

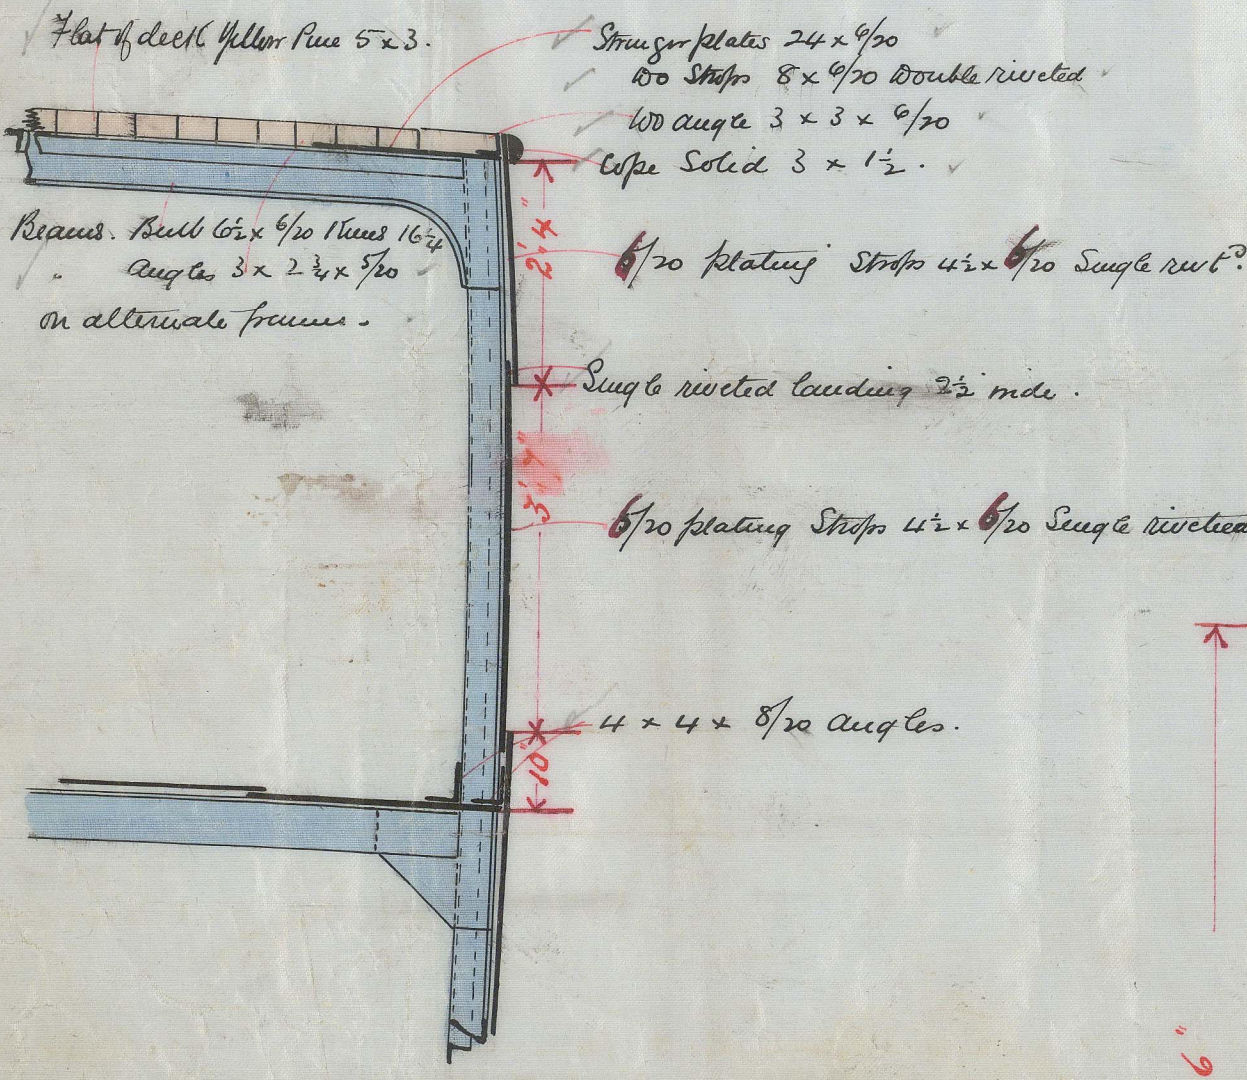

SECTION IN WAY OF FORE-CASTLE.

Dimensions.


Length on fore rule	248.6
Half rounded breadth	17.4
Depth from top of keel	20.04
Half rounded breadth	83.45

Numerals.

17.4 + 0.71	20.04 + 1.18	9.33	45	70.87	17623.25	19231.37

Proportions.

248.6 ÷ 34.8	7.14	rounded breadth
170 ÷ 20.04	12.4	depth to top of keel

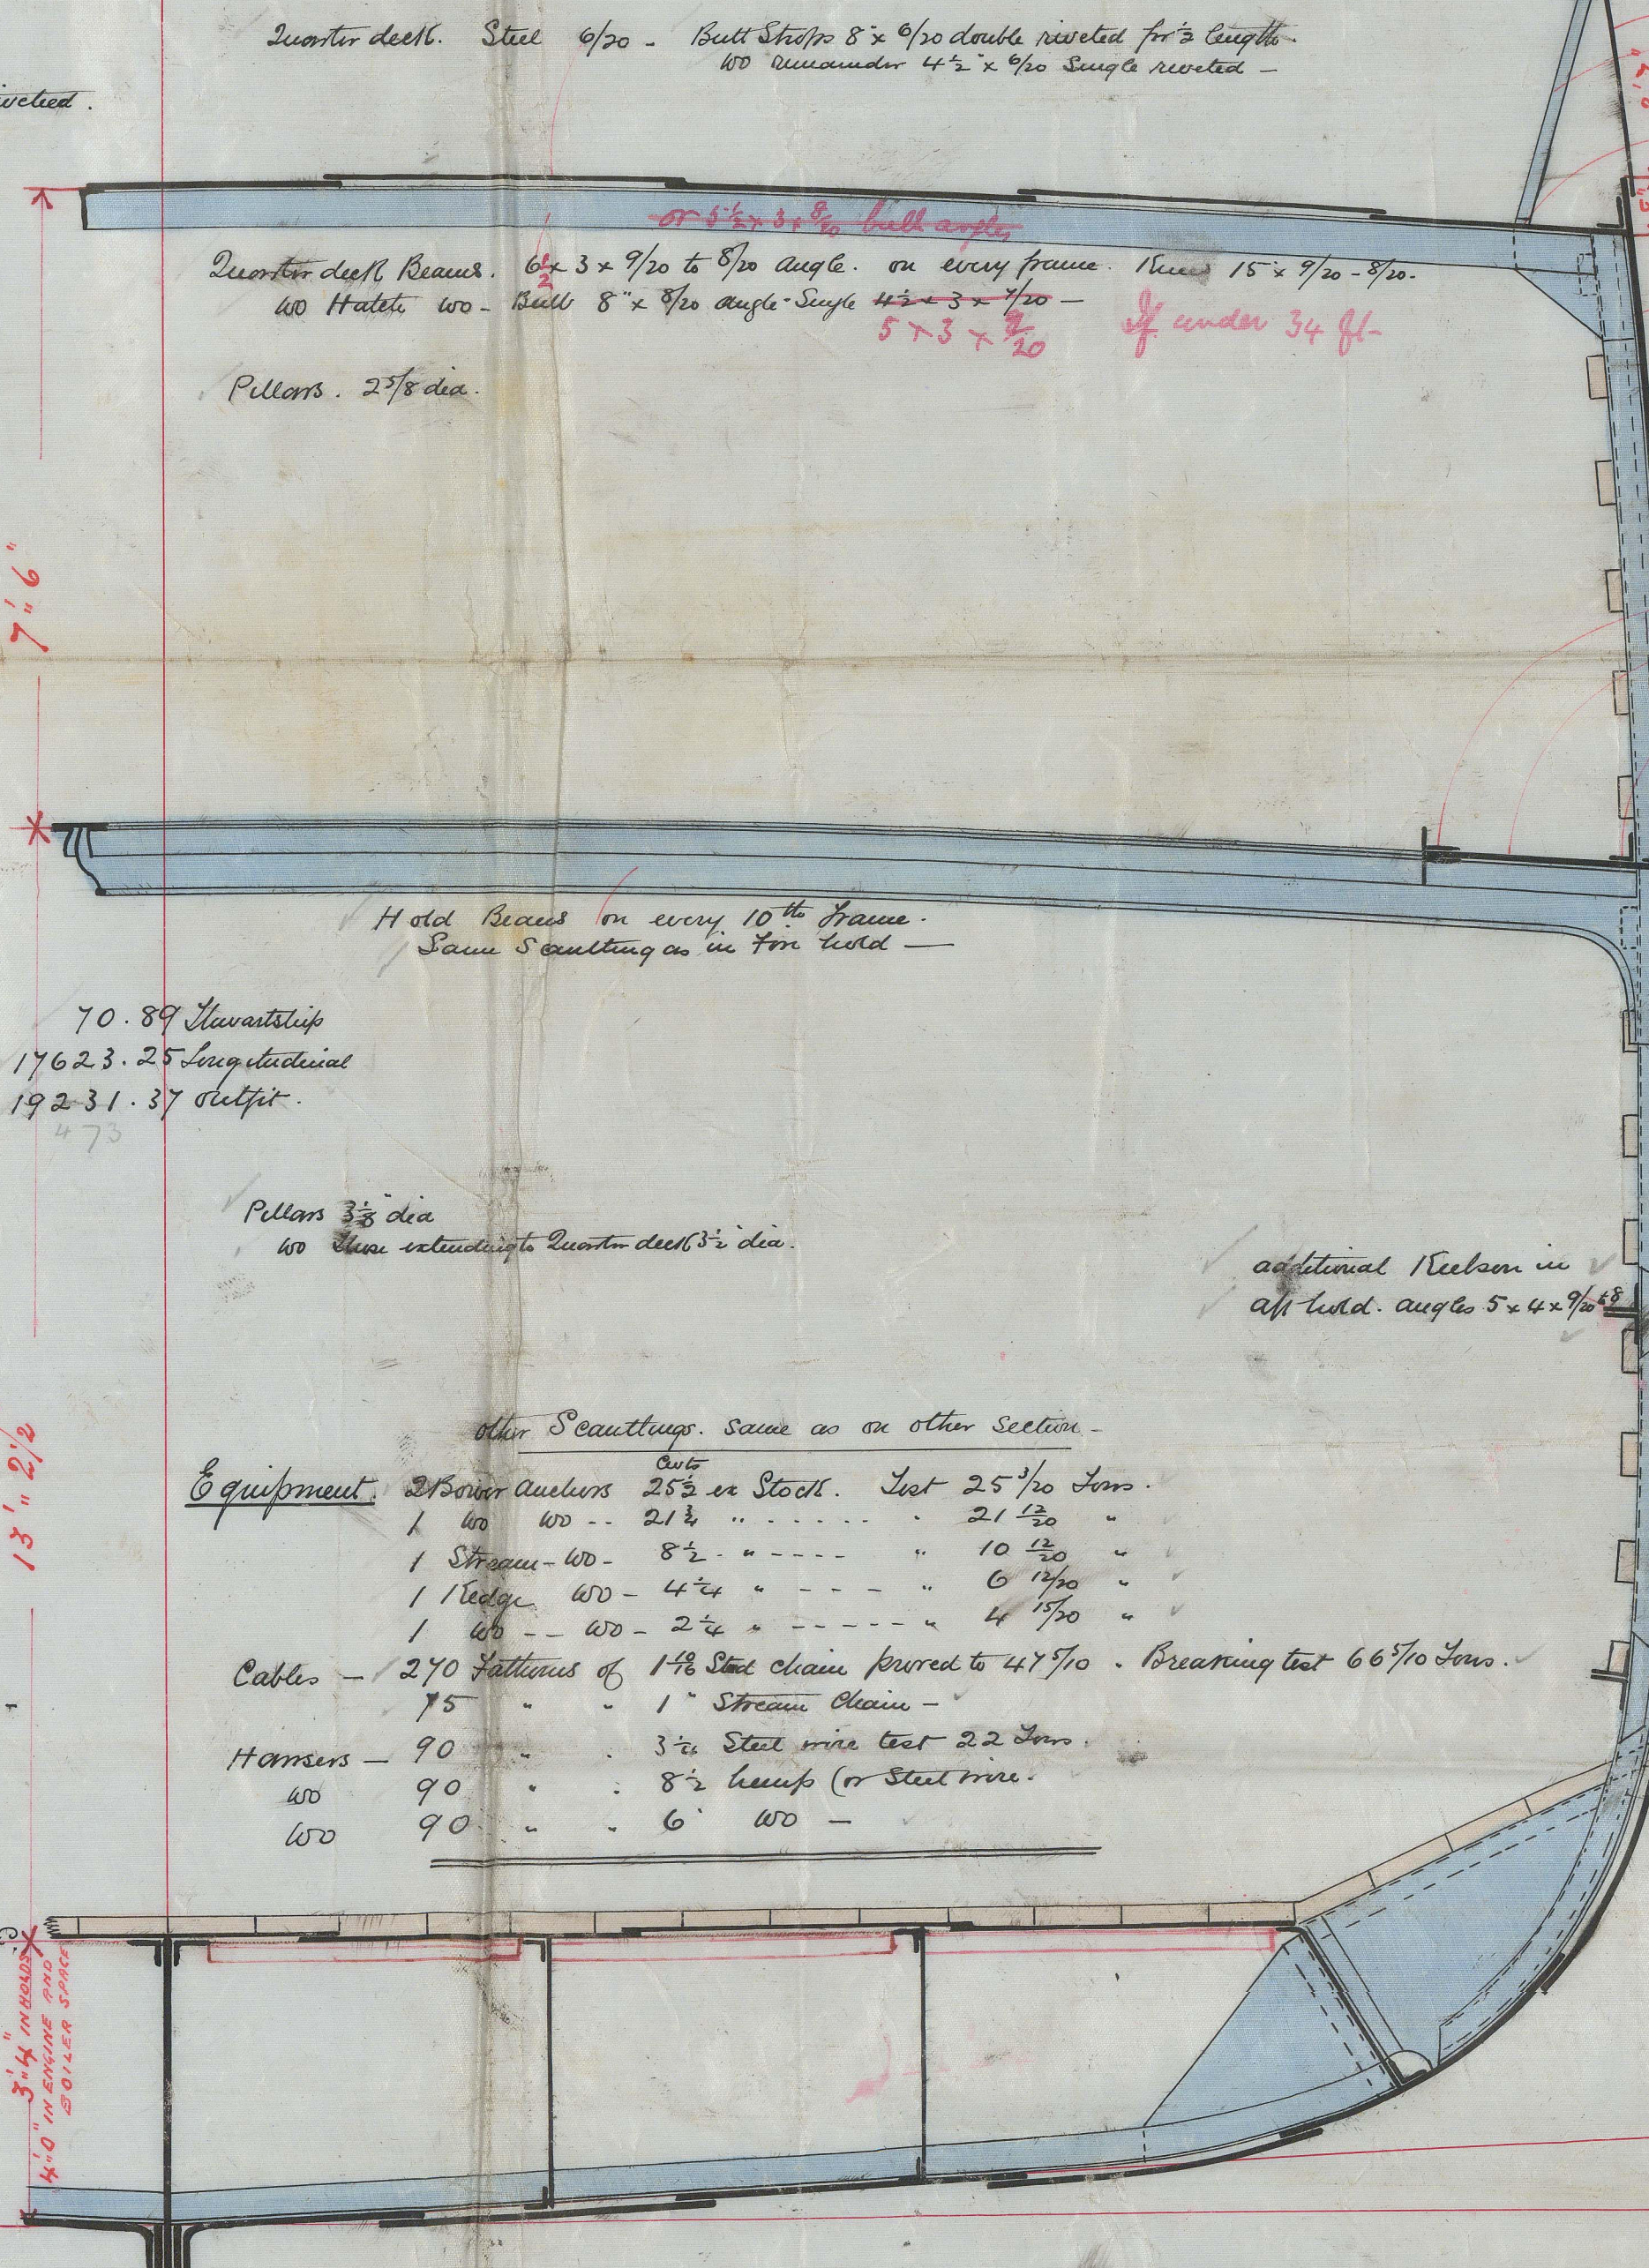

SECTION IN WAY OF QUARTER DECK
SHOWING FRAMES ON WHICH NO BRACKETS ARE FITTED.






Plating.

The Plating covering the hull to be thicker than the struts and cross-plates. Remains of after works of plating from the fore-castle to be of same thickness as the struts and cross-plates. And also the Butt Straps in the fore-castle head of same to be thicker and double riveted.

Alex. Stephen & Sons
SHIPBUILDERS & ENGINEERS
GLASGOW

SCALE 1/2 INCH TO A FOOT

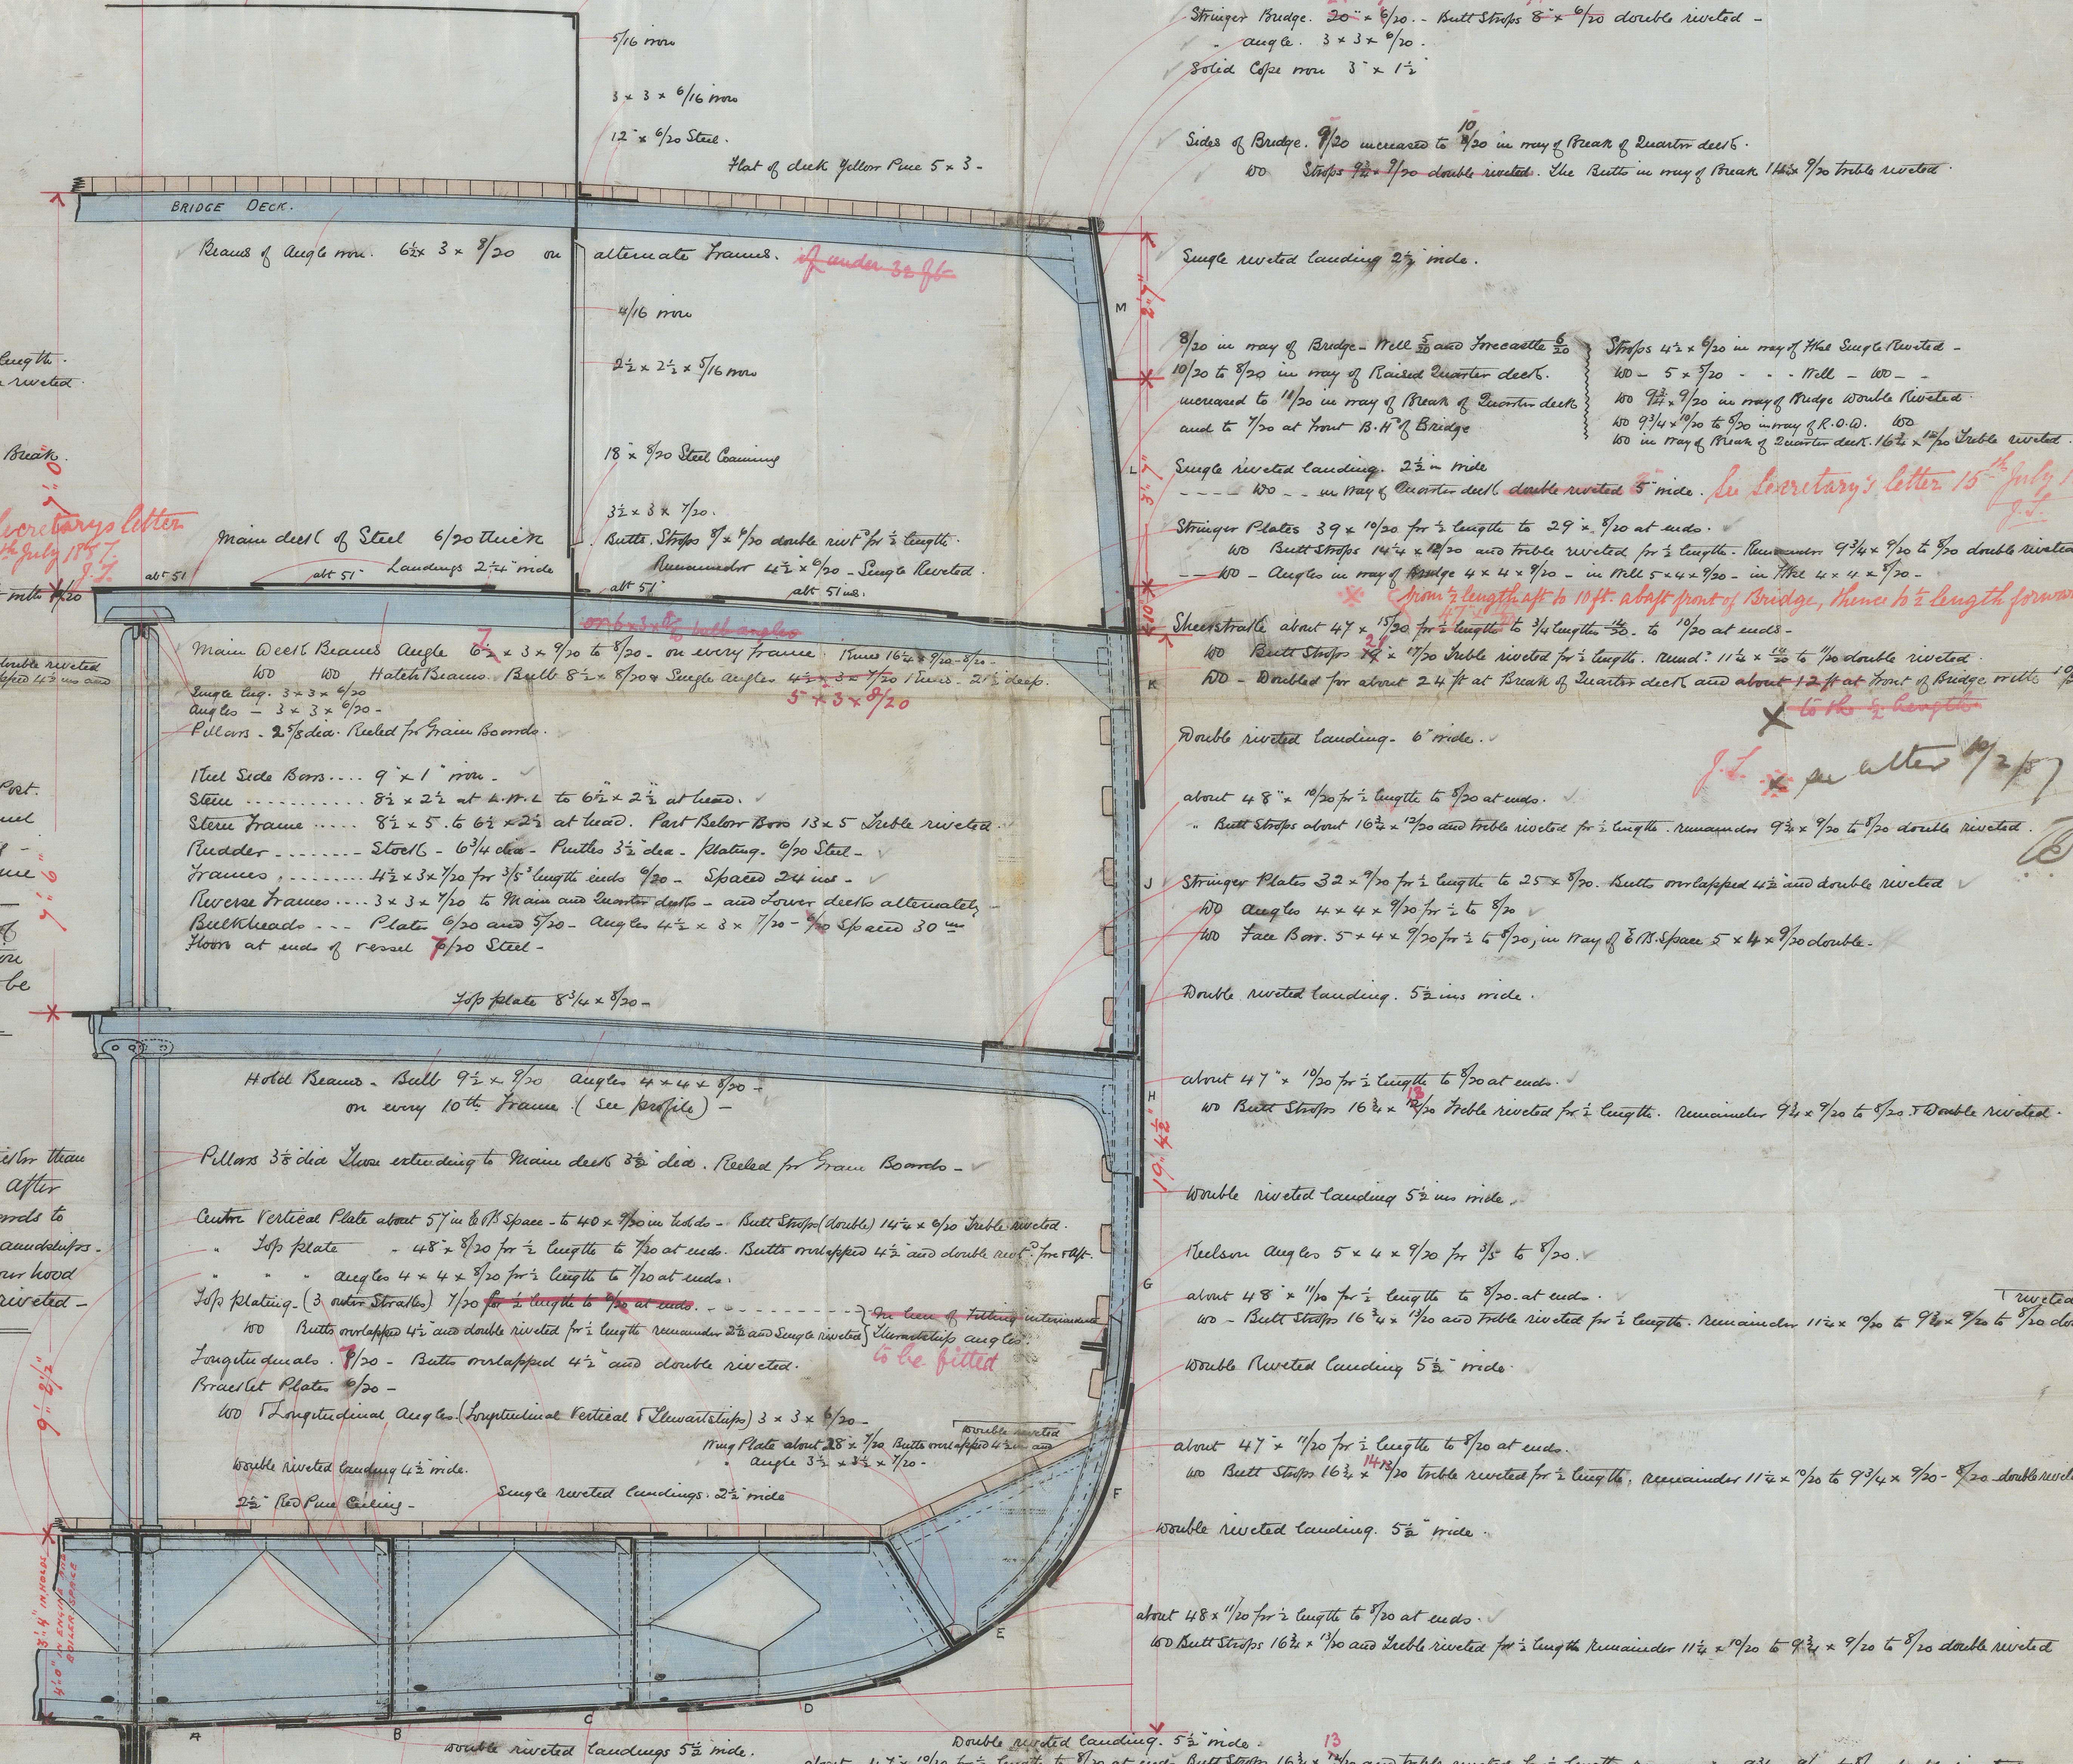




13/10/87
3/2/87
J. L. 1/2/87

"Oden," ex Glenoran, ex Vascongada
Slts. 8165-

