

The words FORGINGS or CASTINGS, IRON or STEEL, should be struck out as may be required.

Lloyd's Register of British and Foreign Shipping.

(Report on Vessel No. 8165 Port Glasgow)
S.S. "Naslongada."

No. 1410 **SHIP FORGINGS OR CASTINGS.**

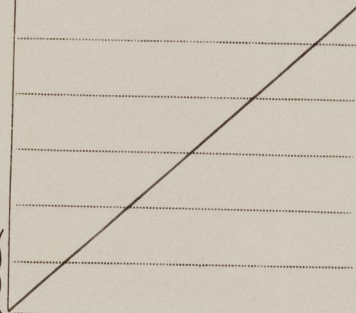
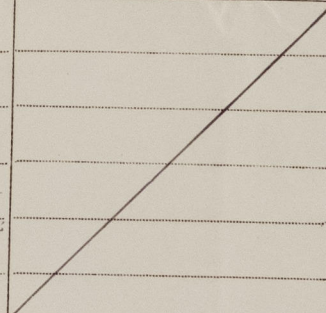
I have to report that the undermentioned Iron ~~or Steel~~ Forgings ~~or Castings~~, manufactured by Messrs A. Stephens & Sons of Glasgow.
for the Vessel No. 305, being built by them,
of _____ have been inspected by me as set forth below, and found
to be, so far as can be seen, sound and efficient.

Mark on Forgings.

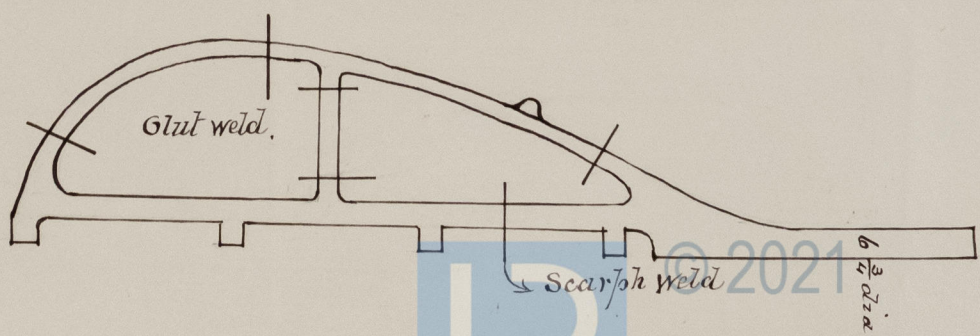
Lloyd's
No. 1410
G. N.

George Newcomb.
Glasgow

14/7/87.

	STERN FRAME.	RUDDER FRAME.	STEM.
Material* - - - -		<u>Scrap iron</u>	
How made - - - -		<u>Forged</u>	
Dimensions - - - -		<u>6 3/4 dia</u>	
Progress on Inspection -		<u>Forging & smithing</u>	
Dates when Inspected {		<u>4/4/87. 2.5.23/5/87.</u> <u>28/6/87. 5.11/7/87.</u>	

SKETCHES OF FRAMES SHEWING POSITION AND DESCRIPTION OF WELDS OF FORGINGS, OR PARTICULARS OF TESTS APPLIED TO CASTINGS.



* If of Iron, state whether scrap or puddled Iron.