

Lloyd's Register of British and Foreign Shipping.

(Report on Vessel No. 8695 Port Glasgow)

S.S. "Aberlay."

No. 1604.

SHIP FORGINGS OR CASTINGS.

I have to report that the undermentioned Iron or ~~Steel~~ Forgings or ~~Castings~~, manufactured by The Portland Forge Co of Kilmarnock, for the Vessel No. 258, being built by Messrs Wm Simons & Co. of Renfrew, have been inspected by me as set forth below, and found to be, so far as can be seen, sound and efficient.

Stem made by Messrs Wm Simons & Co., Renfrew.

The words FORGINGS or CASTINGS, IRON or STEEL, should be struck out as may be required.

Mark on Forgings.

Lloyd's
No. 1604
G.N


George Newcomb.
Glasgow.

21/2/88.

	STERN FRAME.	RUDDER FRAME.	STEM.
Material*	<u>Scrap iron.</u>	/	<u>Scrap iron.</u>
How made	<u>Forged.</u>		<u>Forged.</u>
Dimensions	<u>4 1/4 x 4 3/4</u>		<u>4 1/4 x 2 3/8.</u>
Progress on Inspection	<u>Forging & smithing</u>		<u>Smithing.</u>
Dates when Inspected	<u>26.30/12/87. 10.18.23/1/88.</u> <u>1.4.16.18/2/88.</u>		<u>3.15/2/88.</u>

SKETCHES OF FRAMES SHEWING POSITION AND DESCRIPTION OF WELDS OF FORGINGS, OR PARTICULARS OF TESTS APPLIED TO CASTINGS.

H.J.B.
21/2/88.

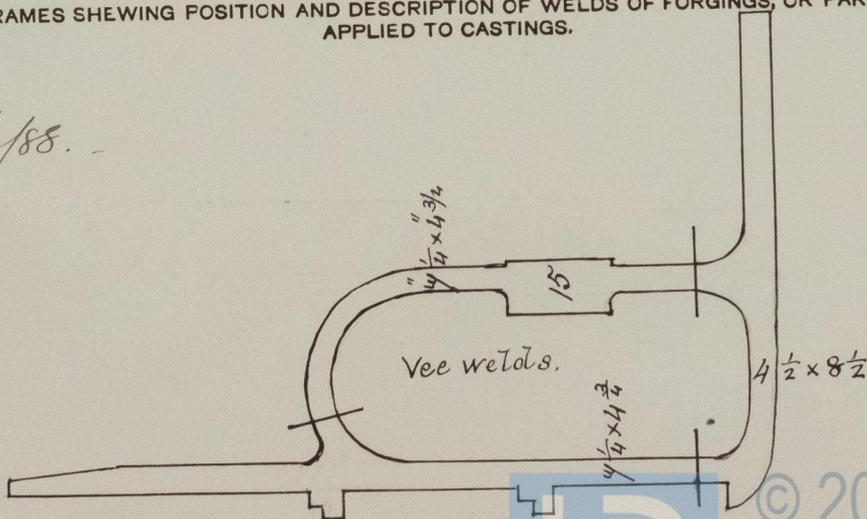

* If of Iron, state whether scrap or puddled iron.