

30.8.88.

Plan Showing Diagonals &c.


For Ship No 355.

Scale 1/8" = Foot.

25 AUG 88

4 masted Ship "Glaucus" Glasgow Report No 90874. —
3 masted " Brablock do " 9254. —

except as regards mast battens
which are for 3 masted ship
in this case

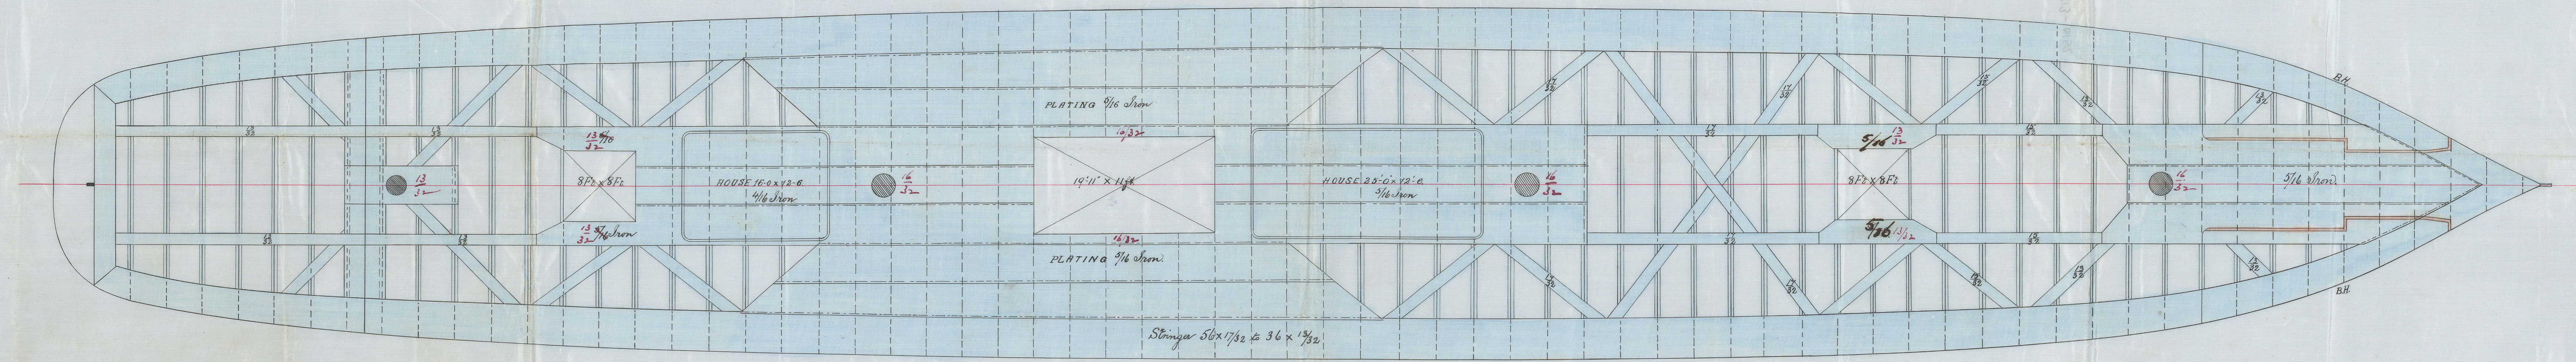

18mo
30/8/88

1/2 length

Centre of length

1/2 length

25 AUG 88

