


642513-0123

30.8.88

Ship "Glaucus" Glasgow Report No. 9084.-
Ship "Brablock" — do — " 9254.-

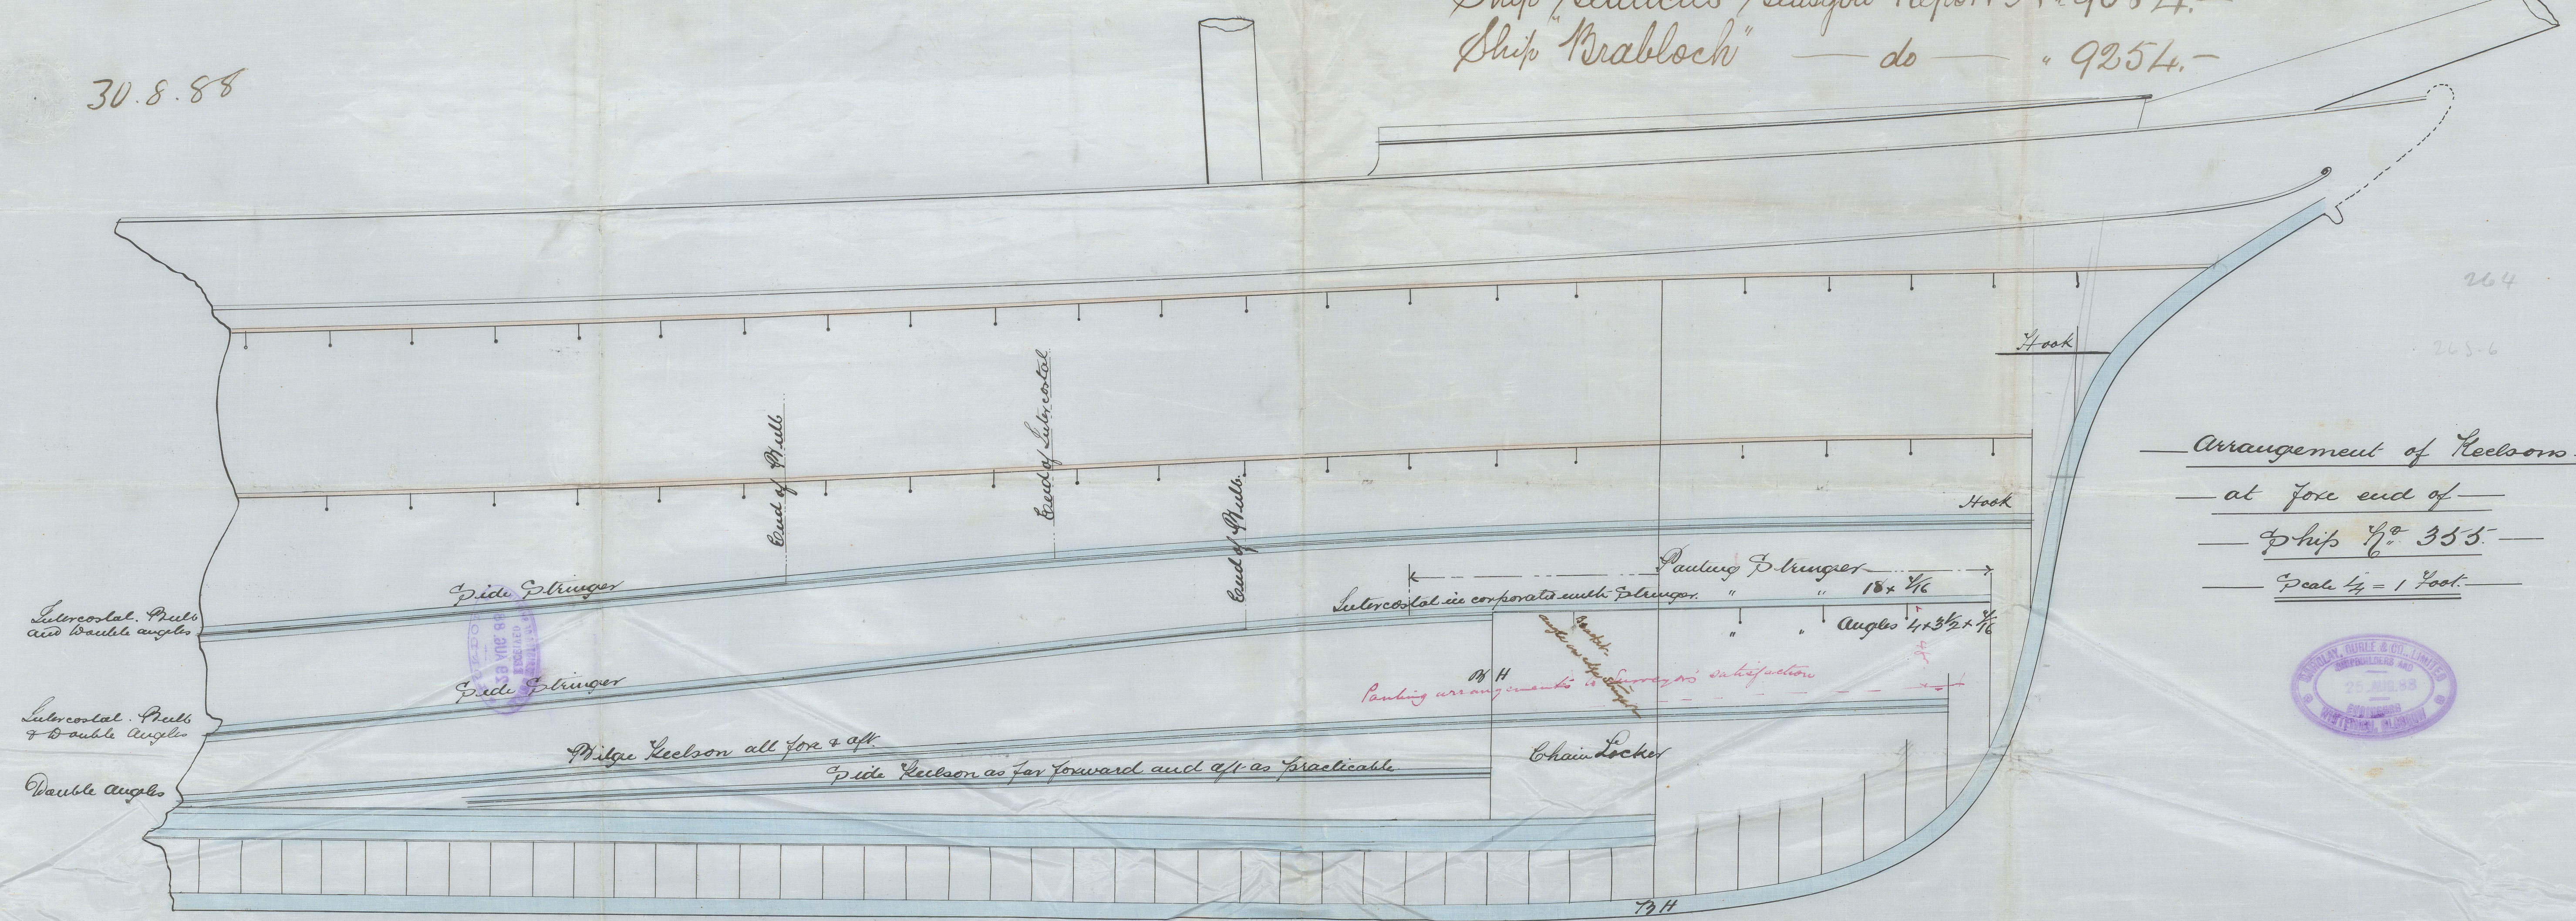

Arrangement of Keelsons
at fore end of
Ship No. 355.
Scale 1/4" = 1 Foot.



Wm J.H.
30/8/88

Ship *Maurel's* *Shanghai* *11/11/88*
Ship *Maurel's* *do*

98054-

28.2.88



Notes on the ship

Ship

RECEIVED
29 AUG. 88
LONDON


