


dt. 2/11/88

# PUMPING ARRANGEMENT


S. S. N° 414.

SCALE  $\frac{1}{8}$  INCH = 1 FOOT.

Note: All M.L. Pumps, also arranged to be worked by winches.

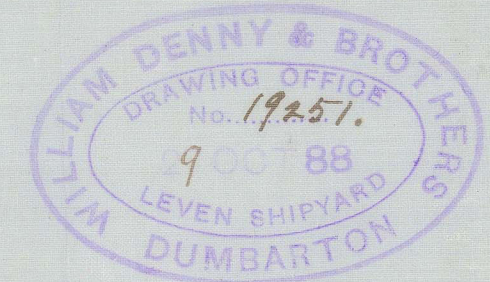


S. S. "Pegu" Glasgow Report N° 9124.

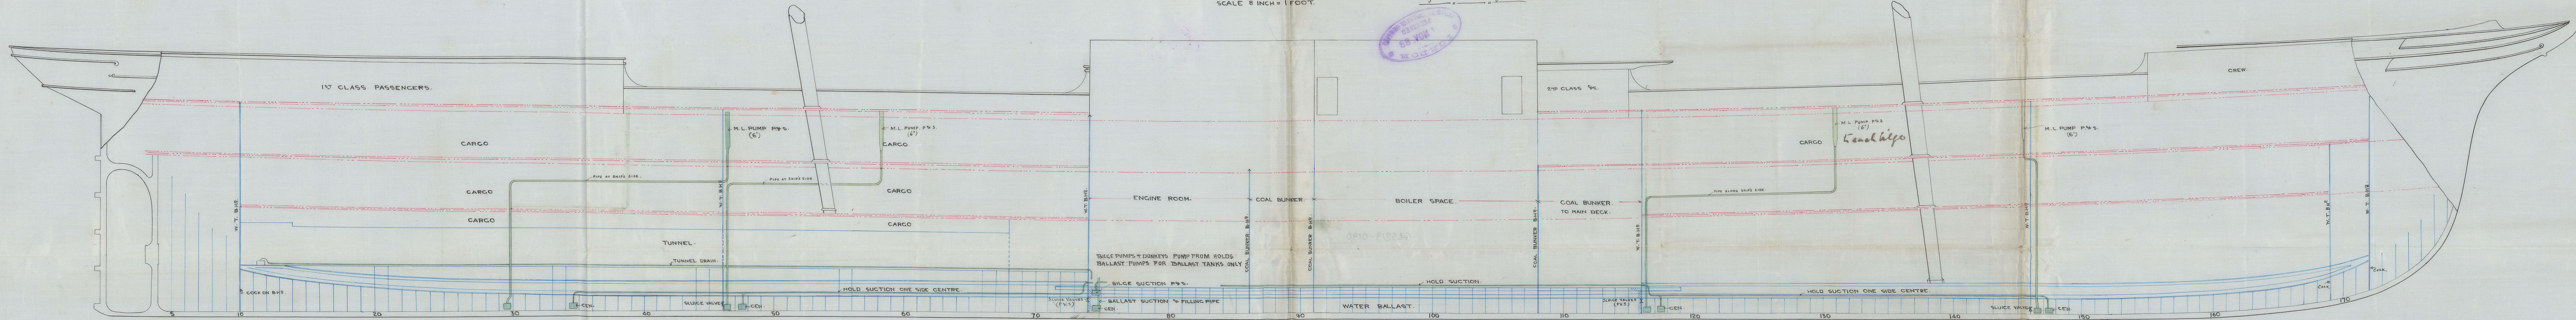

Alt  
1. 11. 88.





*Q. D. "Regin" Glasgow Report A. 1127*

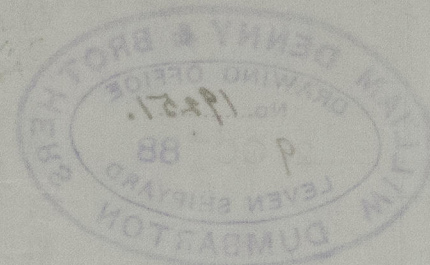

INCEMENT PUMP

S.S. N. S.

Note: All M.L.P. pumps also arranged to be worked by winches.

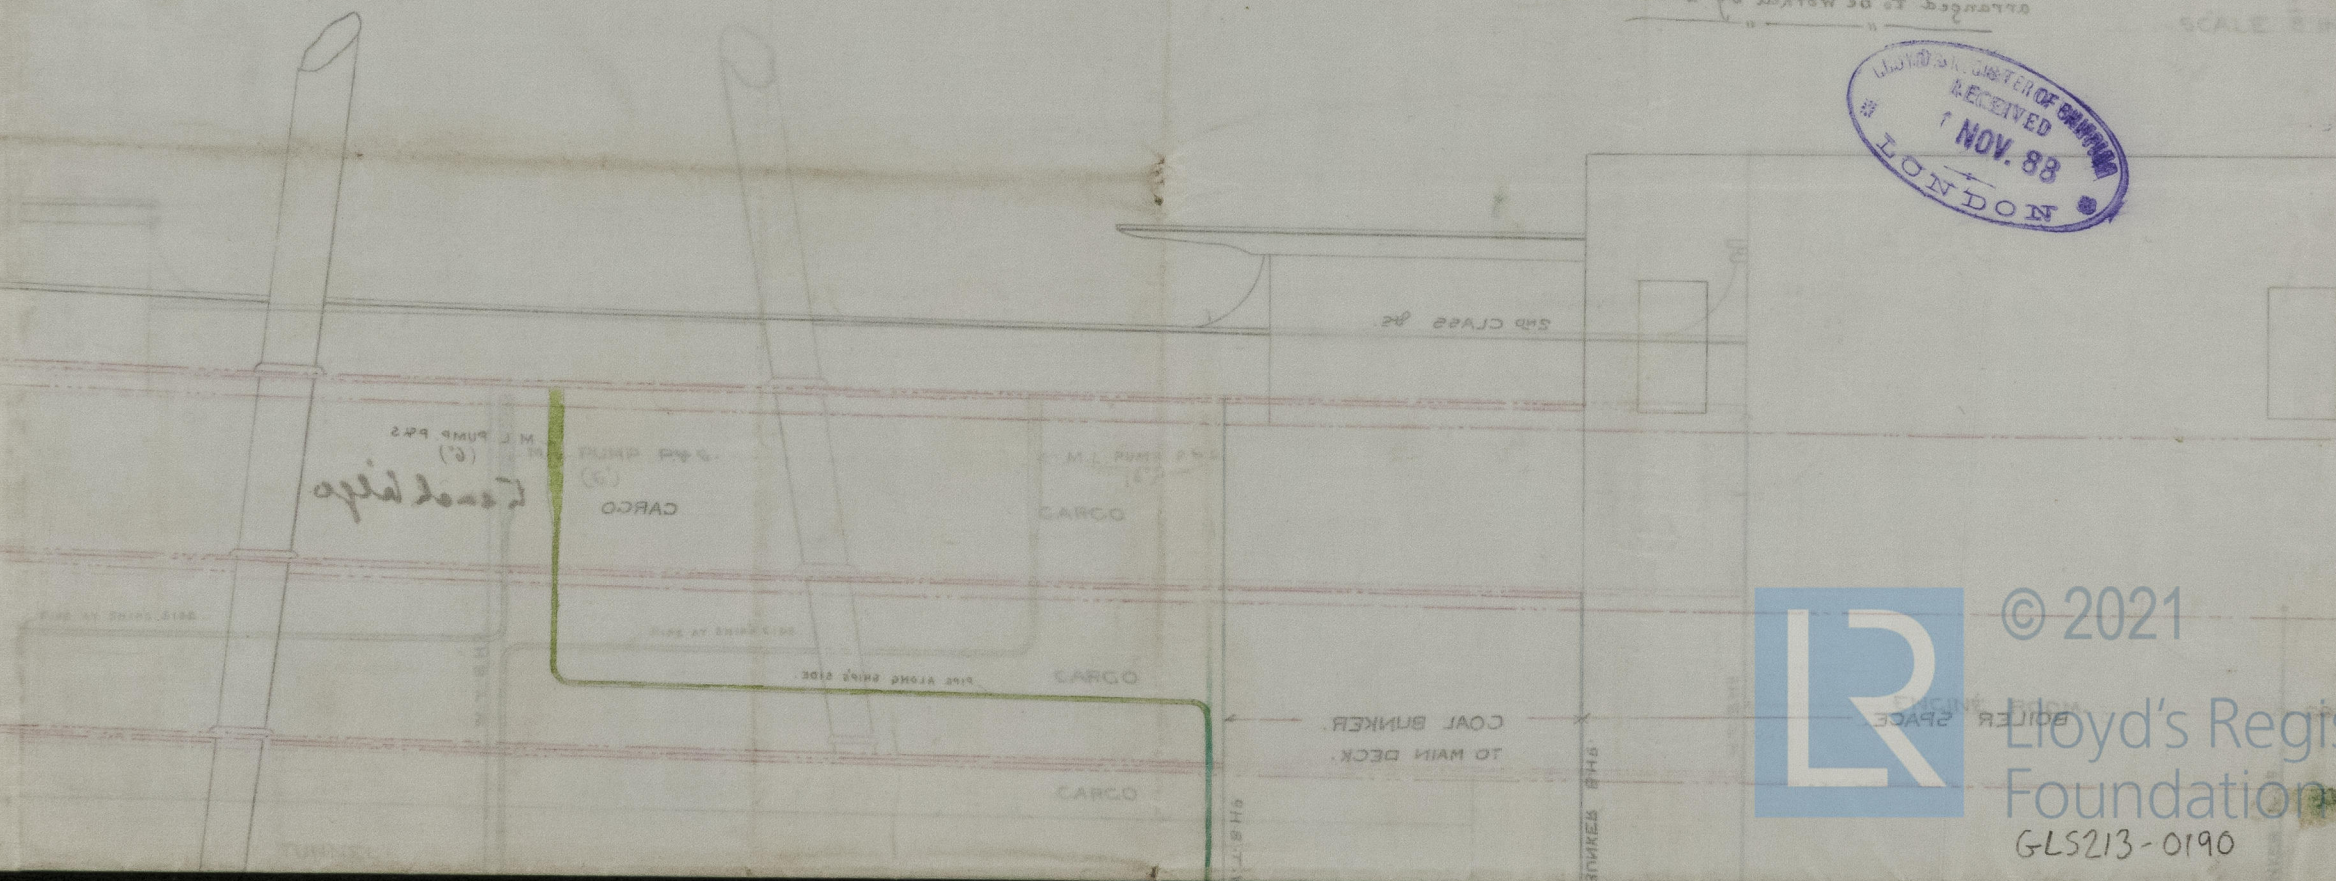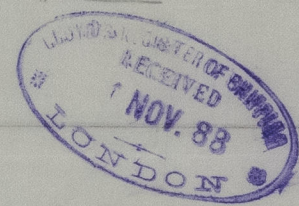

© 2021  
Lloyd's Register  
Foundation  
GLS213-0190