

Lloyd's Register of British and Foreign Shipping.

(Report on Vessel No. *9940* Port *Glasgow*)*S. S. "Alkestis."*No. *2126*

SHIP FORGINGS OR CASTINGS.

The words FORGINGS or CASTINGS, IRON or STEEL, should be struck out as may be required.

I have to report that the undermentioned Iron ~~or Steel~~ Forgings ~~or Castings~~, manufactured by *The Portland Forge Co* of *Kilmarnock* for the Vessel No. *9*, being built by *Messrs Mackie & Thomson* of *Glasgow* have been inspected by me as set forth below, and found to be, so far as can be seen, *Sound & efficient*


Mark on Forgings.

Lloyd's
No. *2126*
W. H.

William Hamilton
Glasgow
10/4/90

	STERN FRAME.	RUDDER FRAME.	STEM.
Material* - - - -	/	<i>Scrap iron</i>	/
How made - - - -		<i>Forged</i>	
Dimensions - - - -		<i>6 1/4 to 3 1/4</i>	
Progress on Inspection -		<i>Forging & smithing</i>	
Dates when Inspected		<i>7.13. 28/3/90. 2.8. 10/4/90</i>	

SKETCHES OF FRAMES SHEWING POSITION AND DESCRIPTION OF WELDS OF FORGINGS, OR PARTICULARS OF TESTS APPLIED TO CASTINGS.

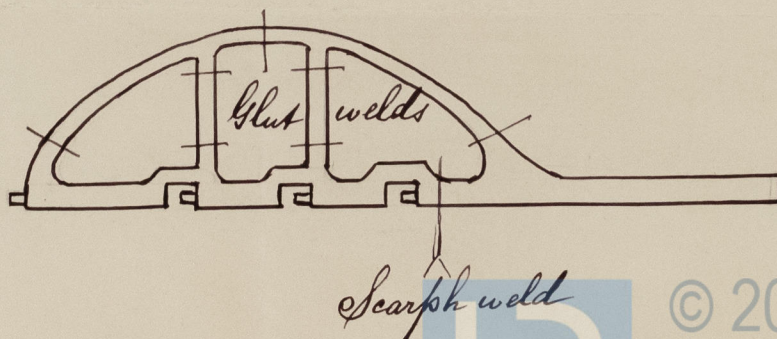

© 2021

Lloyd's Register
Foundation