



Dr: to Gls 16:10:91

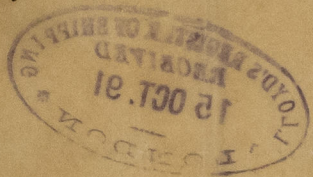

Kemp Emp.
89.



Pumping Plan
S.S. N° 92
Scale $\frac{1}{8}$ " = One Foot

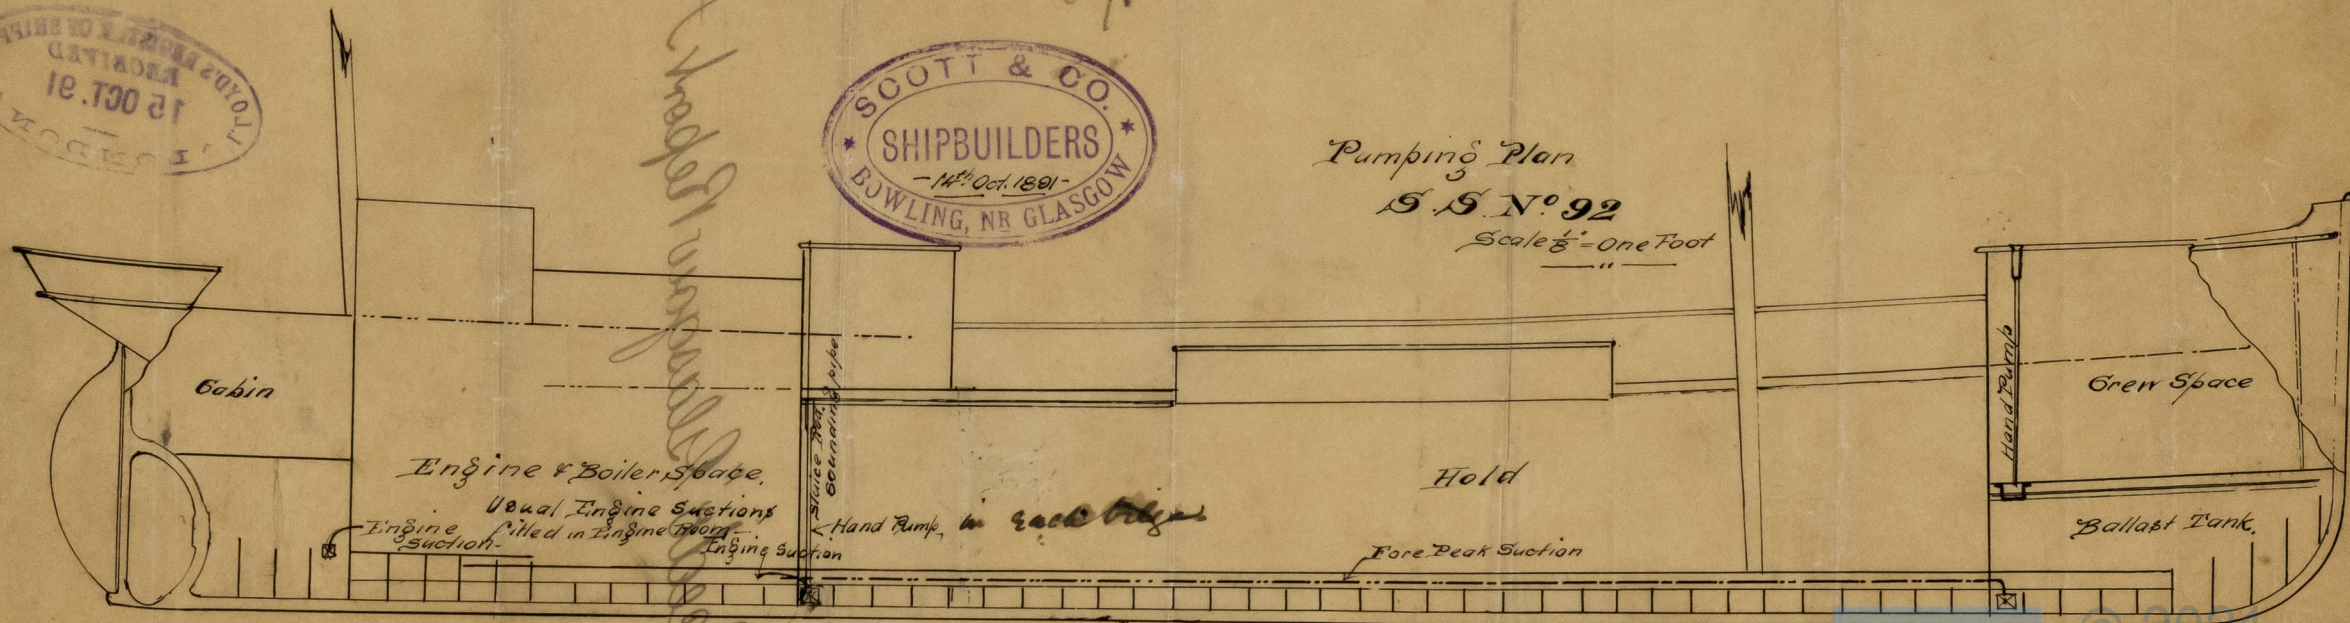

4300-1055817

1001147 propeller under way

Sluice accessible

J.M.
16/10/91



© 2021
Lloyd's Register
Foundation

GLS226A-0034

1861/12/11

Chinaman


S. S. ¹³ Alcedo Glasgow Report N^o 11204.

GLS226A-0034

15 OCT. 91
LLOYD'S REGISTER

100

100

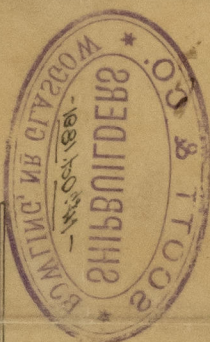


104

1701

187

[illegible]

vidio

