

S.S. "Glen" Robert & Co.


9.7.91
16.10.91



S.S. N° 92
Scale $\frac{1}{2}$ " = One Foot

Classed 100A special Survey.
Framework Iron
Shell Plating Steel


Kemp 89

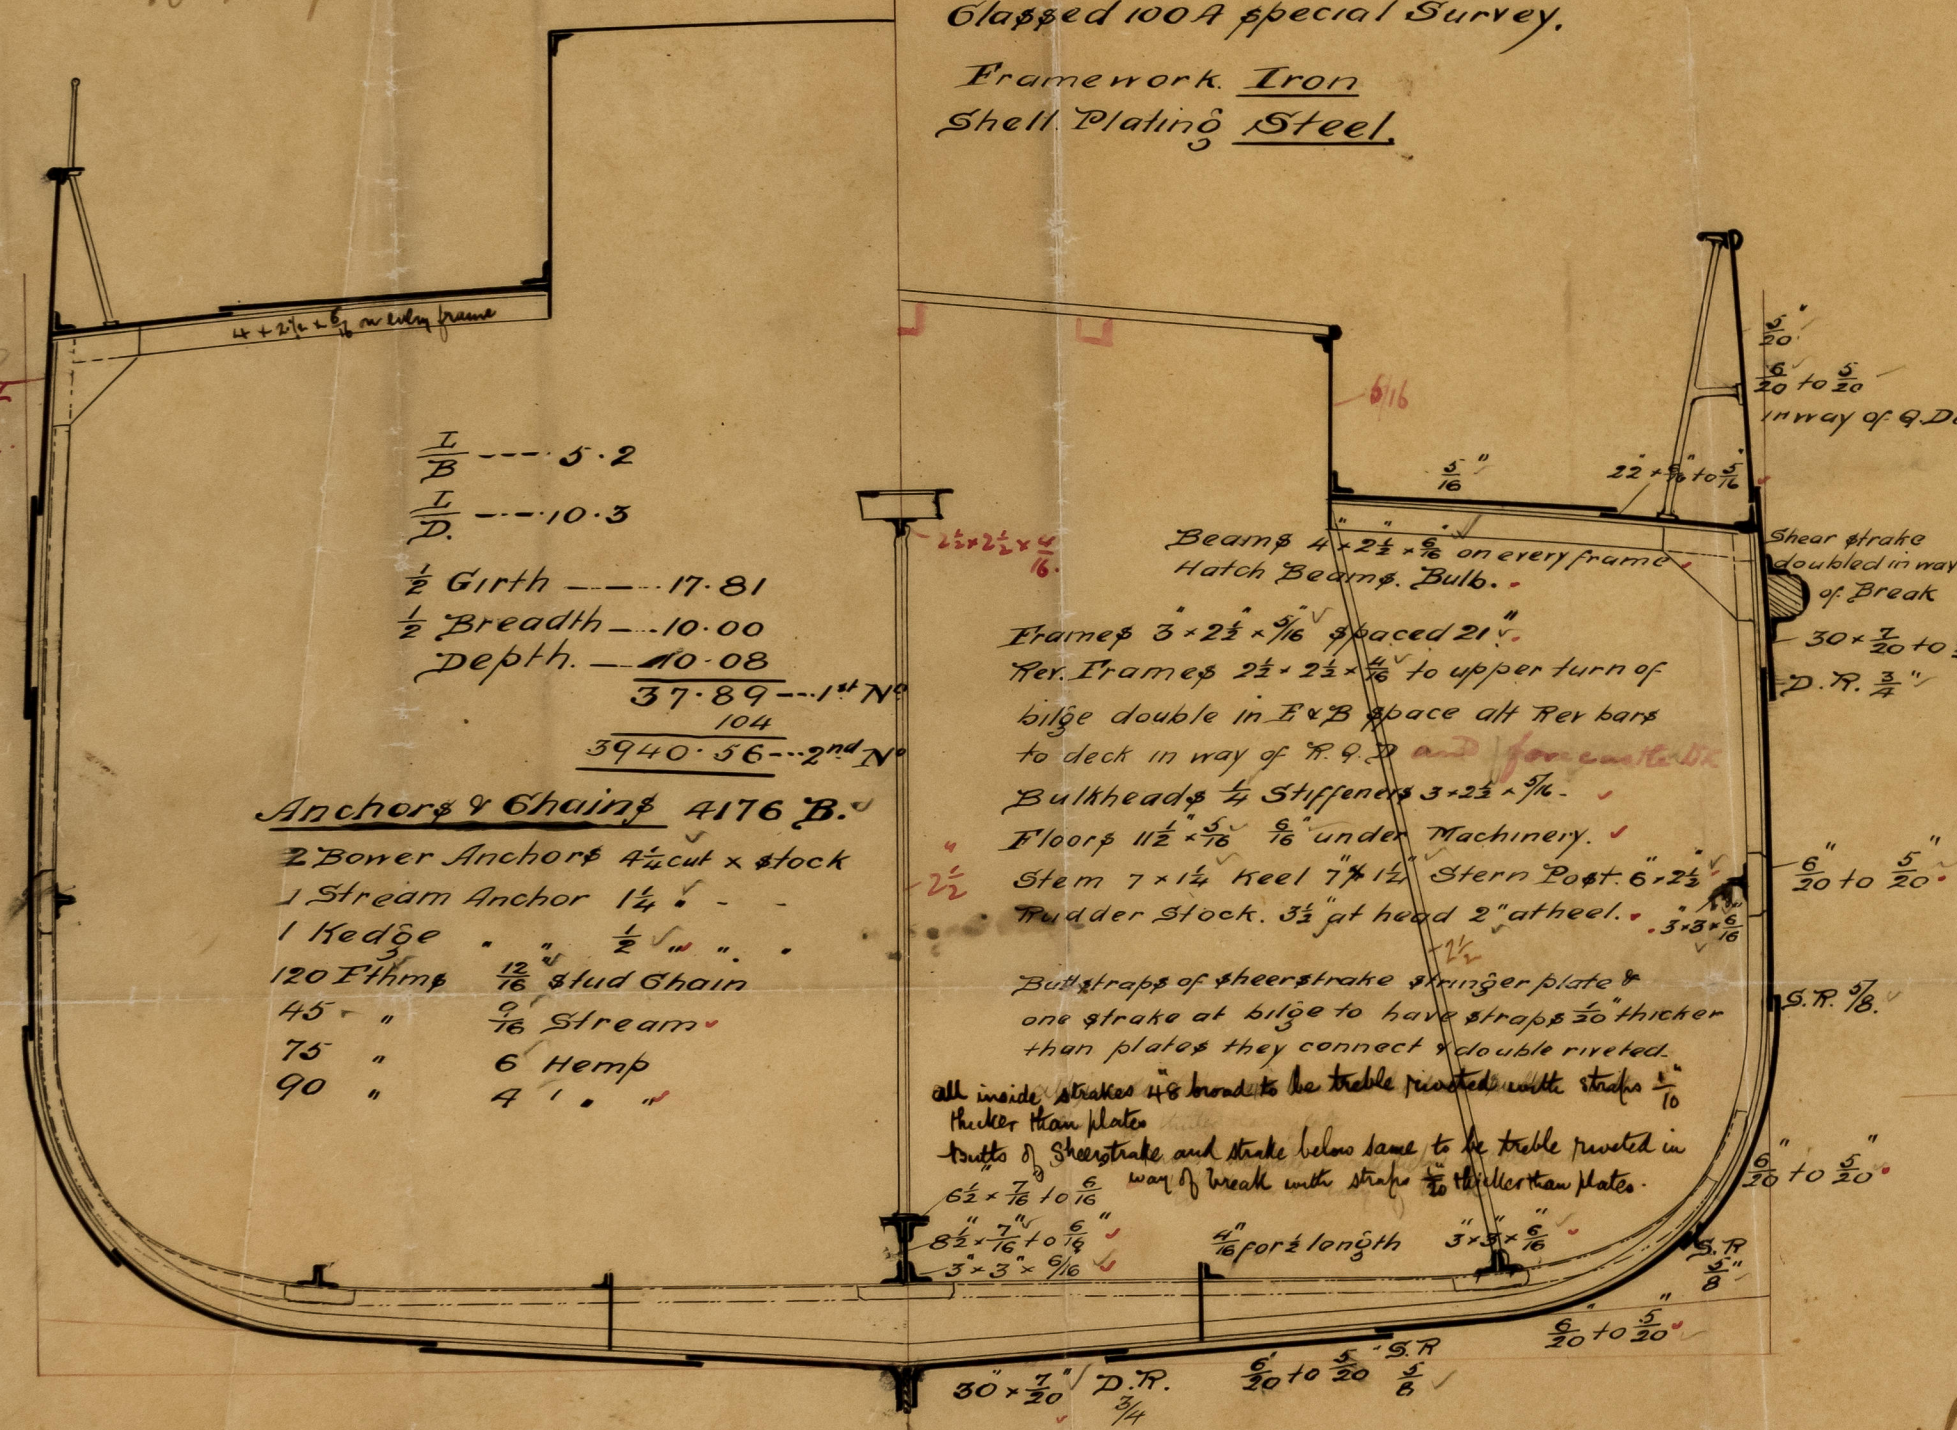


$\frac{L}{B}$ --- 5.2
 $\frac{L}{D}$ --- 10.3
 $\frac{1}{2}$ Girth --- 17.81
 $\frac{1}{2}$ Breadth --- 10.00
Depth --- 10.08
37.89 --- 1st N°
104
59.40 --- 2nd N°

Anchors & Chains 4176 B.
2 Bower Anchors $4\frac{1}{2}$ cut x stock
1 Stream Anchor $1\frac{1}{4}$ " "
1 Kedg " $\frac{1}{2}$ " "
120 Fthms $\frac{1}{16}$ Stud Chain
45 " $\frac{9}{16}$ Stream
75 " 6 Hemp
90 " 4 " "

Frames $3 \times 2\frac{1}{2} \times \frac{5}{16}$ spaced 21"
Per. Frames $2\frac{1}{2} \times 2\frac{1}{2} \times \frac{5}{16}$ to upper turn of
bilge double in E & B space alt Per bars
to deck in way of R & D and fore & aft
Bulkheads $\frac{1}{2}$ Stiffeners $3 \times 2\frac{1}{2} \times \frac{5}{16}$
Floors $11\frac{1}{2} \times \frac{5}{16}$ $\frac{5}{16}$ under Machinery
Stern $7 \times 1\frac{1}{2}$ Keel $7 \times 1\frac{1}{2}$ Stern Post $6 \times 2\frac{1}{2}$
Rudder Stock $3\frac{1}{2}$ at head 2 at heel $3 \times 3 \times \frac{5}{16}$
Bulldozers of sheerstrake stringer plate
one strake at bilge to have straps $\frac{3}{8}$ thicker
than plates they connect & double riveted.
all inside strakes $1\frac{1}{2}$ broad to be triple riveted with straps $\frac{5}{16}$
thicker than plates
butts of sheerstrake and strake below same to be triple riveted in
way of break with straps $\frac{5}{16}$ thicker than plates.
 $6\frac{1}{2} \times \frac{7}{16} \times \frac{5}{16}$
 $8\frac{1}{2} \times \frac{7}{16} \times \frac{5}{16}$
 $3 \times 3 \times \frac{5}{16}$
 $\frac{1}{4}$ for length $3 \times 3 \times \frac{5}{16}$
 $3 \times 3 \times \frac{5}{16}$

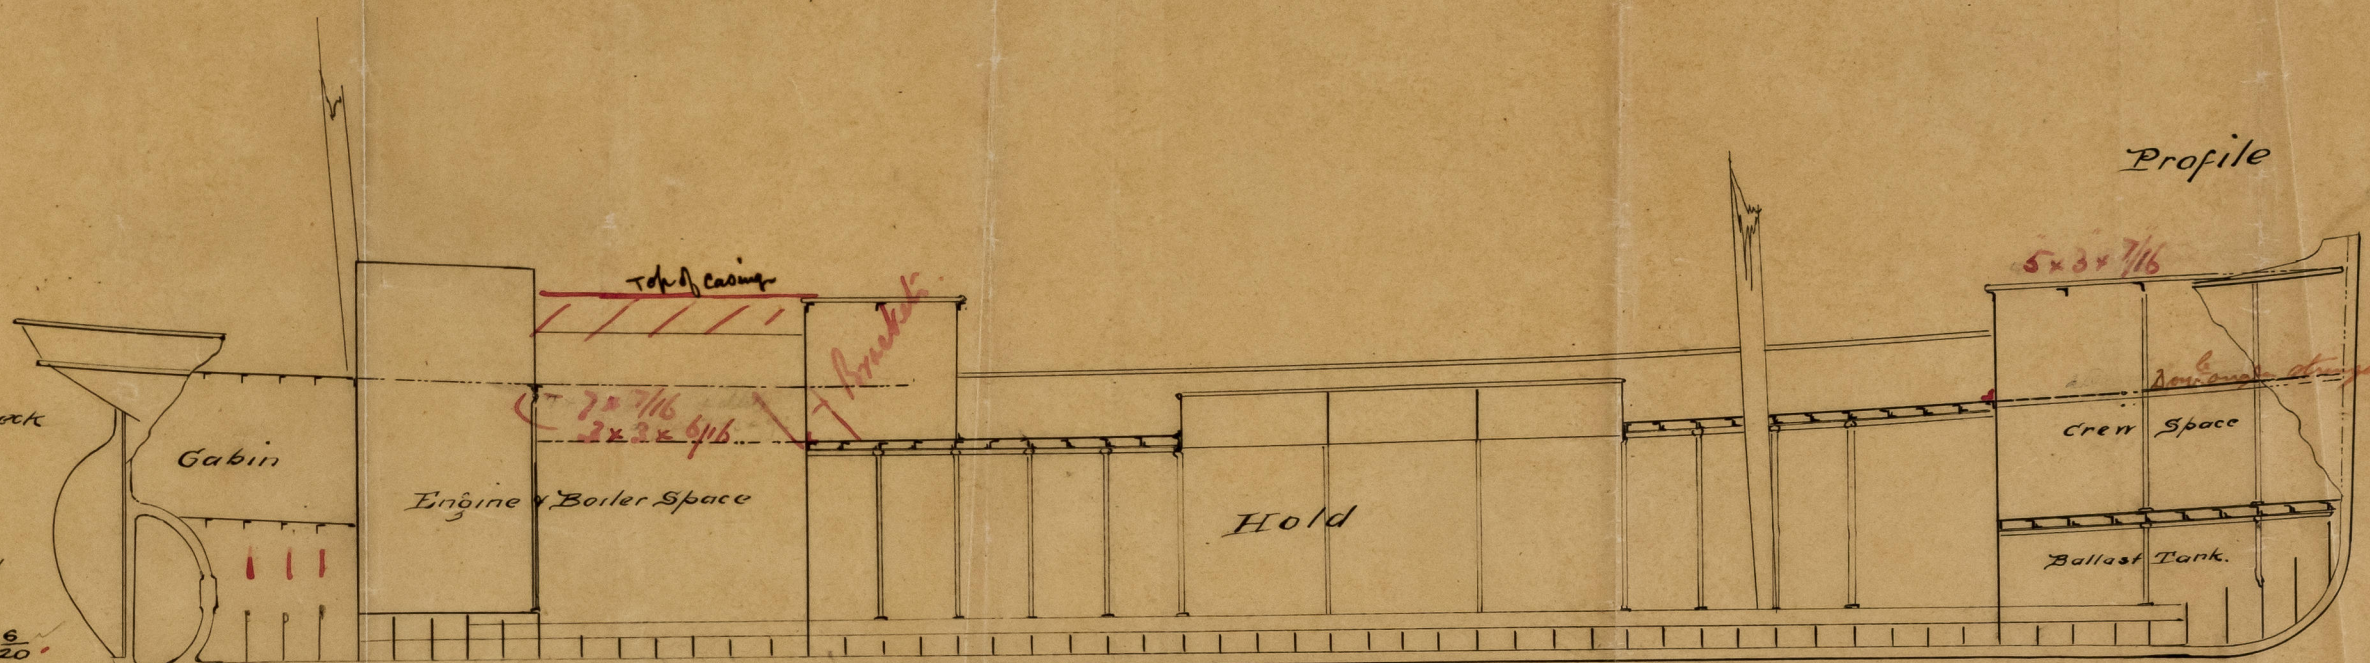

Profile

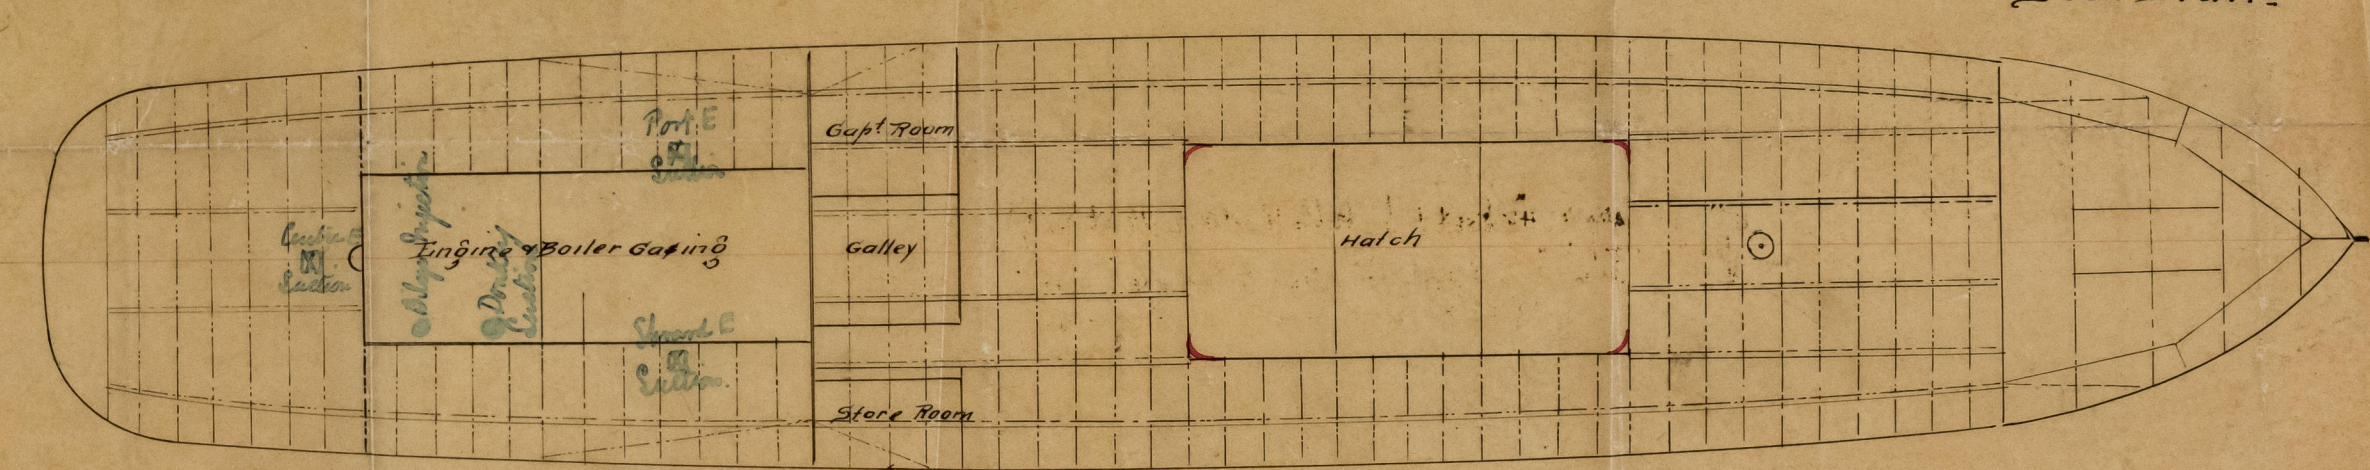

Deck Plan.





2800-1055210

9/7/91

GLS226A-0035



© 2021
Lloyd's Register
Foundation

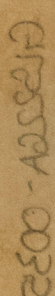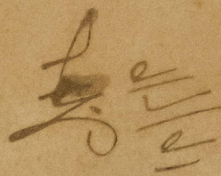





Scale $\frac{1}{2}$ " = one foot

R. S. No. 85