

Lloyd's Register of British and Foreign Shipping.

(Report on Vessel No. 11640 Port Glasgow)

"BK Gedabank"

No. 3499

SHIP FORGINGS OR CASTINGS.

The words FORGINGS or CASTINGS, IRON or STEEL, should be struck out as may be required.

I have to report that the undermentioned Iron or Steel Forgings or Castings, manufactured by The Renfrew Forge & Steel Co. of Renfrew for the Vessel No. 56, being built by Messrs. Mackie & Thomson of Glasgow have been inspected by me as set forth below, and found to be, so far as can be seen, Sound.


Mark on Forgings.

Lloyd's
No. 3499
FC

Frank Cook
Glasgow 1/6/92

	STERN FRAME.	RUDDER FRAME.	STEM.
Material* - - - -	/	Scrap Iron.	/
How made - - - -		Forged.	
Dimensions - - - -		7 1/2 to 4 in	
Progress on Inspection -		Forging & Smithing	
Dates when Inspected		25.10.18. 31/3/92. 5.13.19 27/4/92. 5.13.27/5/92. 1/6/92	

SKETCHES OF FRAMES SHEWING POSITION AND DESCRIPTION OF WELDS OF FORGINGS, OR PARTICULARS OF TESTS APPLIED TO CASTINGS.

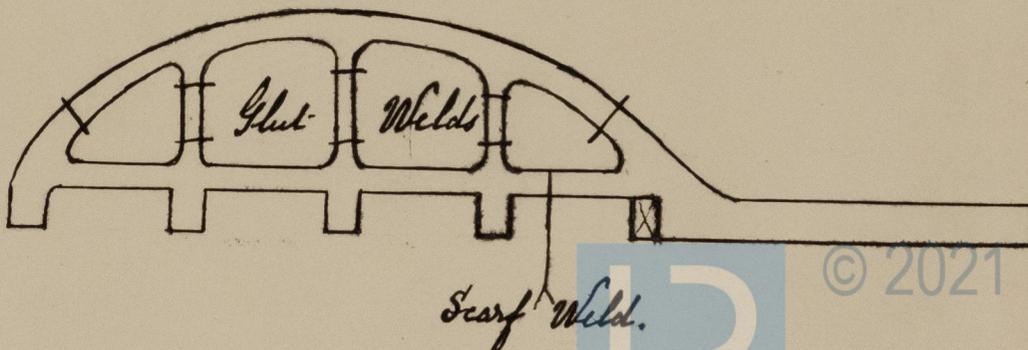

* If of Iron, state whether scrap or puddled Iron.

