

Lloyd's Register of British and Foreign Shipping.

(Report on Vessel No. 12198 Port Glasgow)

No. 3973

SHIP FORGINGS OR CASTINGS.

The words FORGINGS or CASTINGS, IRON or STEEL, should be struck out as may be required.

I have to report that the undermentioned Iron or Steel Forgings or Castings, manufactured by Messrs Robt Kerr & Sons of Irving for the Vessel No. 40, being built by The Ailsa S B Coy of Groon have been inspected by me as set forth below, and found to be, so far as can be seen, Sound & efficient

Mark on Forgings.

Lloyd's
No. 3973
W.H.


William Hamilton

Glasgow

10/2/93

	STERN FRAME.	RUDDER FRAME.	STEM & Keel bars
Material*	<u>Scrap iron</u>	/	<u>Scrap iron</u>
How made	<u>Forged</u>		<u>Forged</u>
Dimensions	<u>19 x 2 1/2</u>		<u>6 3/4 x 2 1/2 top x 2 1/2 to 9 1/2 x 2 1/2</u>
Progress on Inspection	<u>Forging & smithing</u>		<u>Forging</u>
Dates when Inspected	<u>26. 31/1/93. 6. 10/2/93</u>		<u>10. 12. 17. 26. 31/1/93. 6. 10/2/93</u>

SKETCHES OF FRAMES SHEWING POSITION AND DESCRIPTION OF WELDS OF FORGINGS, OR PARTICULARS OF TESTS APPLIED TO CASTINGS.

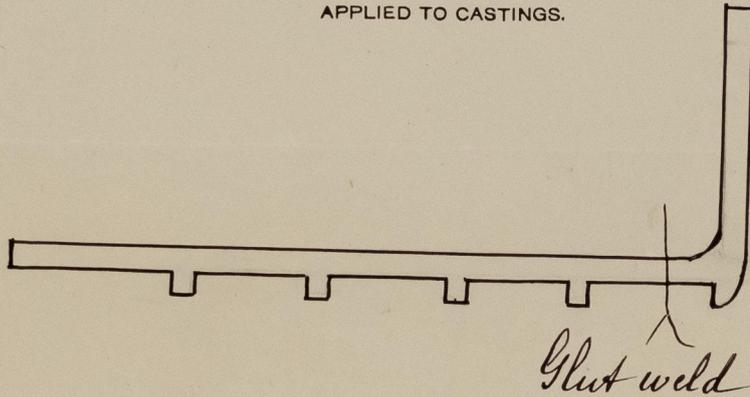

© 2021

Lloyd's Register
Foundation

