


Ref 2710.93

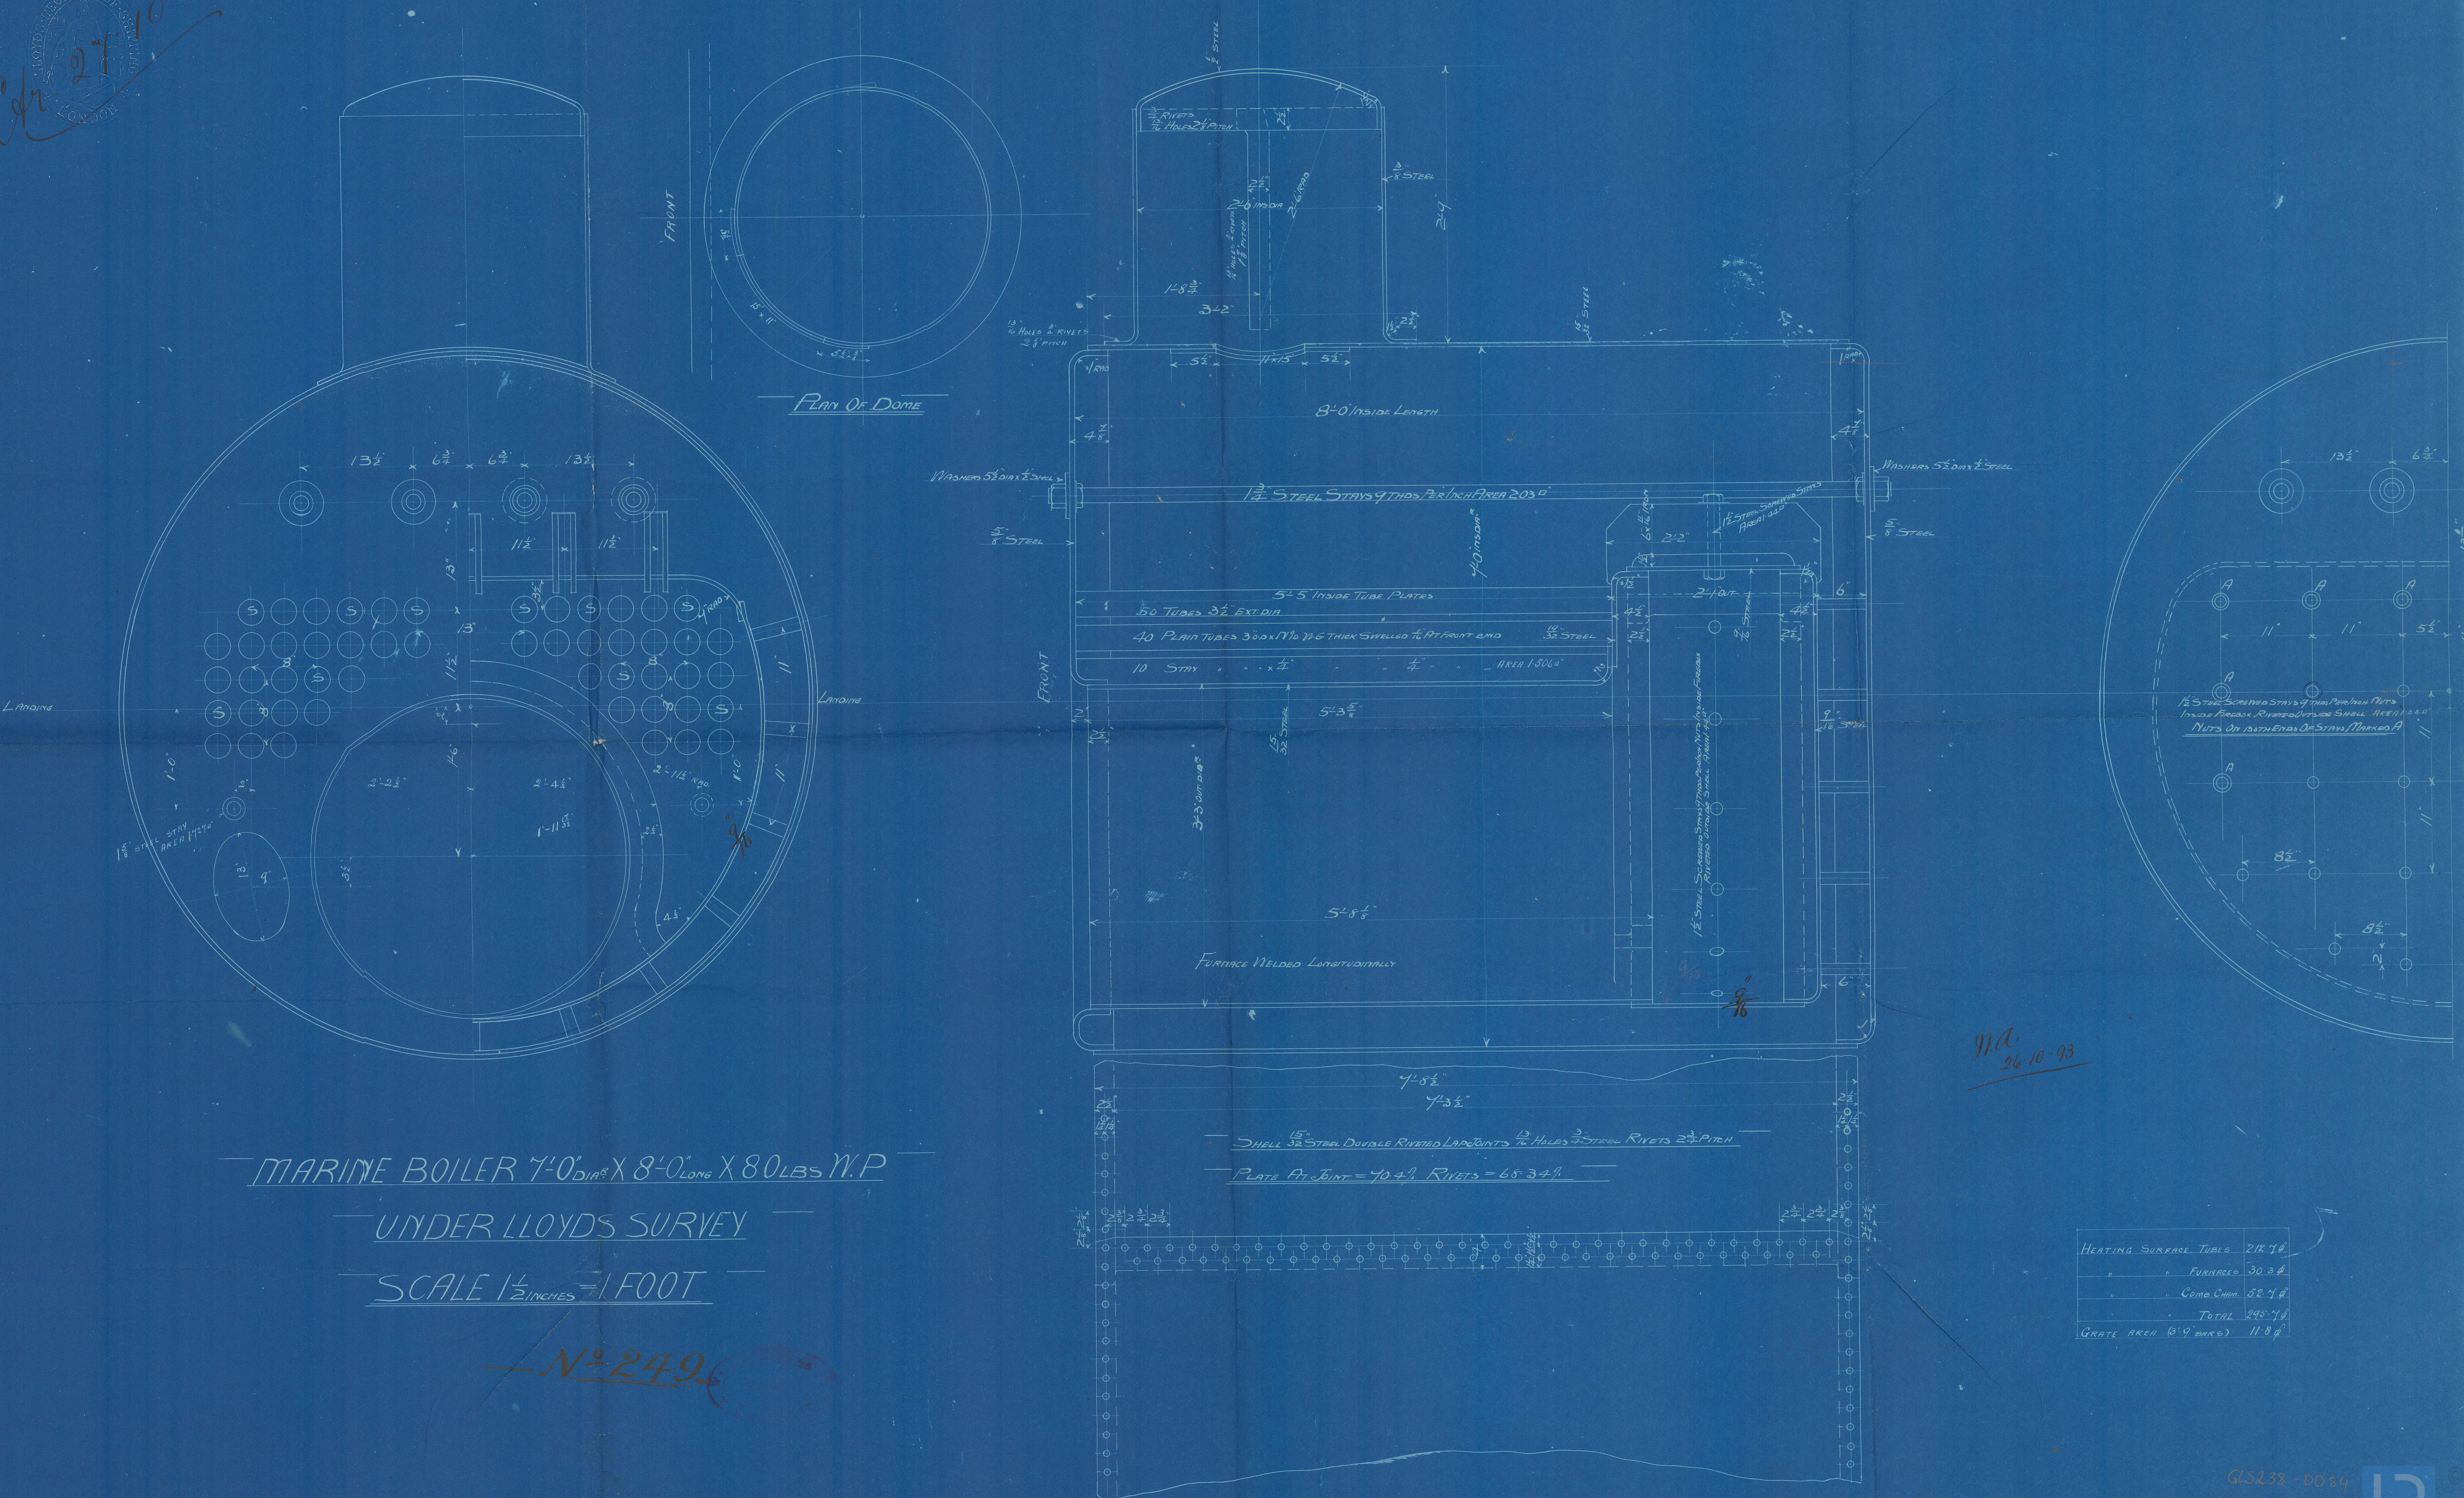

MARINE BOILER 7'-0" DIA X 8'-0" LONG X 80 LBS W.P.

UNDER LLOYDS SURVEY

SCALE 1 1/2" = 1 FOOT

N^o 249

HEATING SURFACE TUBES	218.74
" FURNACE	30.34
" COMB. CHAM.	52.44
TOTAL	298.74
GRATE AREA (6' 9" WIDE)	11.84

GLS233-0034

Lindsay Burnet-
Boiler No 326
To the order of
Walker Wyndham & Co
S.S. "Lock & Live"



Glasgow Report No. 12646

GLS238-0084



© 2021

Lloyd's Register
Foundation