
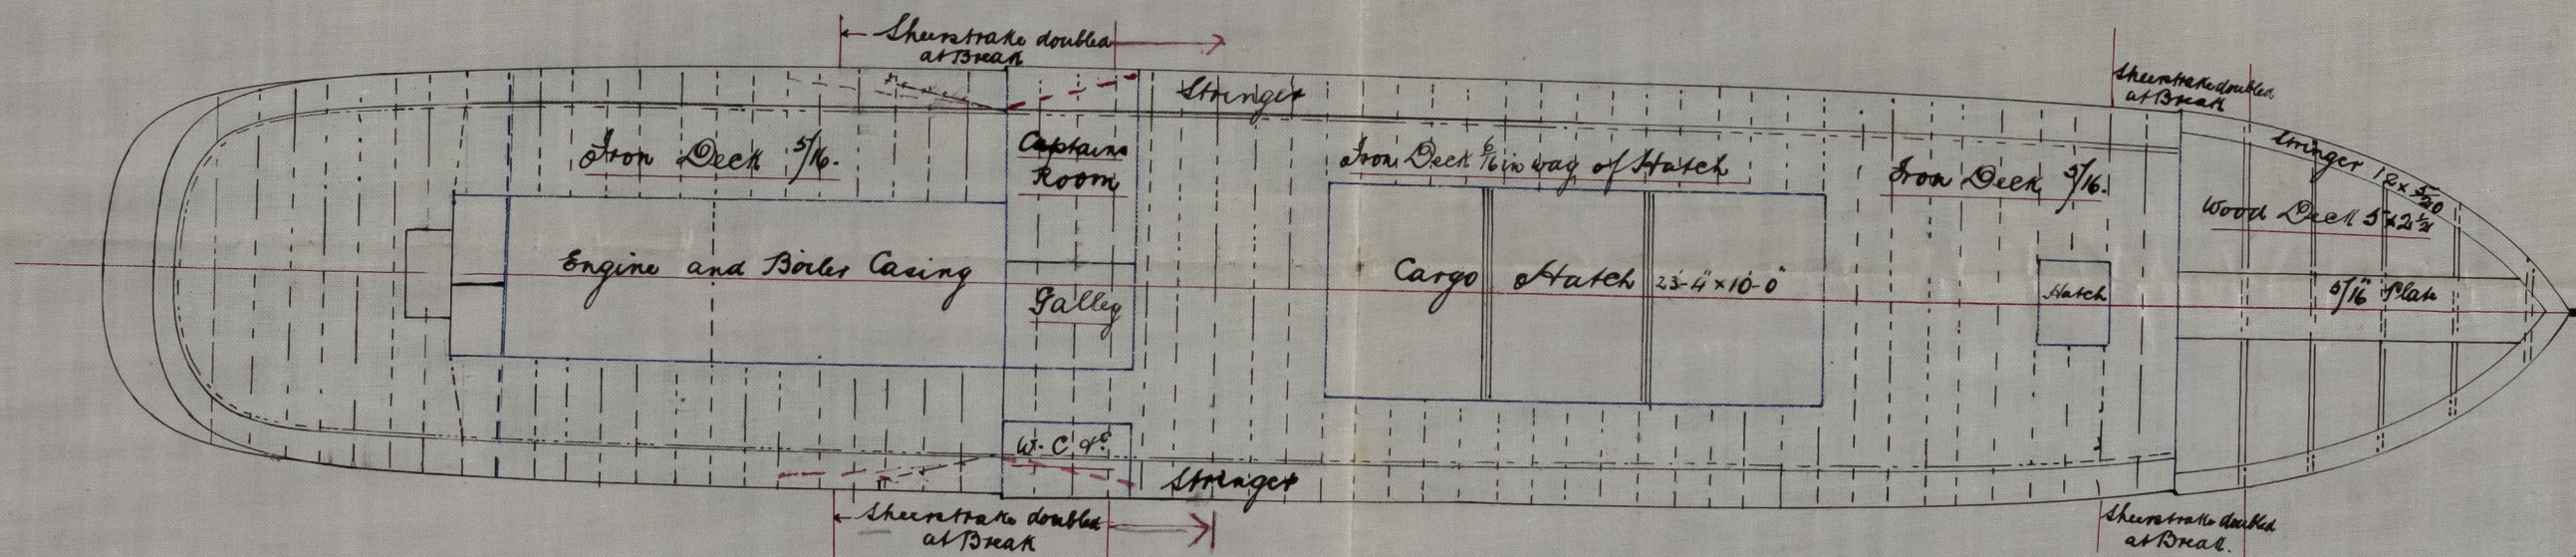


28.2.94.

— Profile and Deck Plan —  
 — No 2078 —  
 — Scale  $\frac{1}{8}$  inch = 1 foot. —

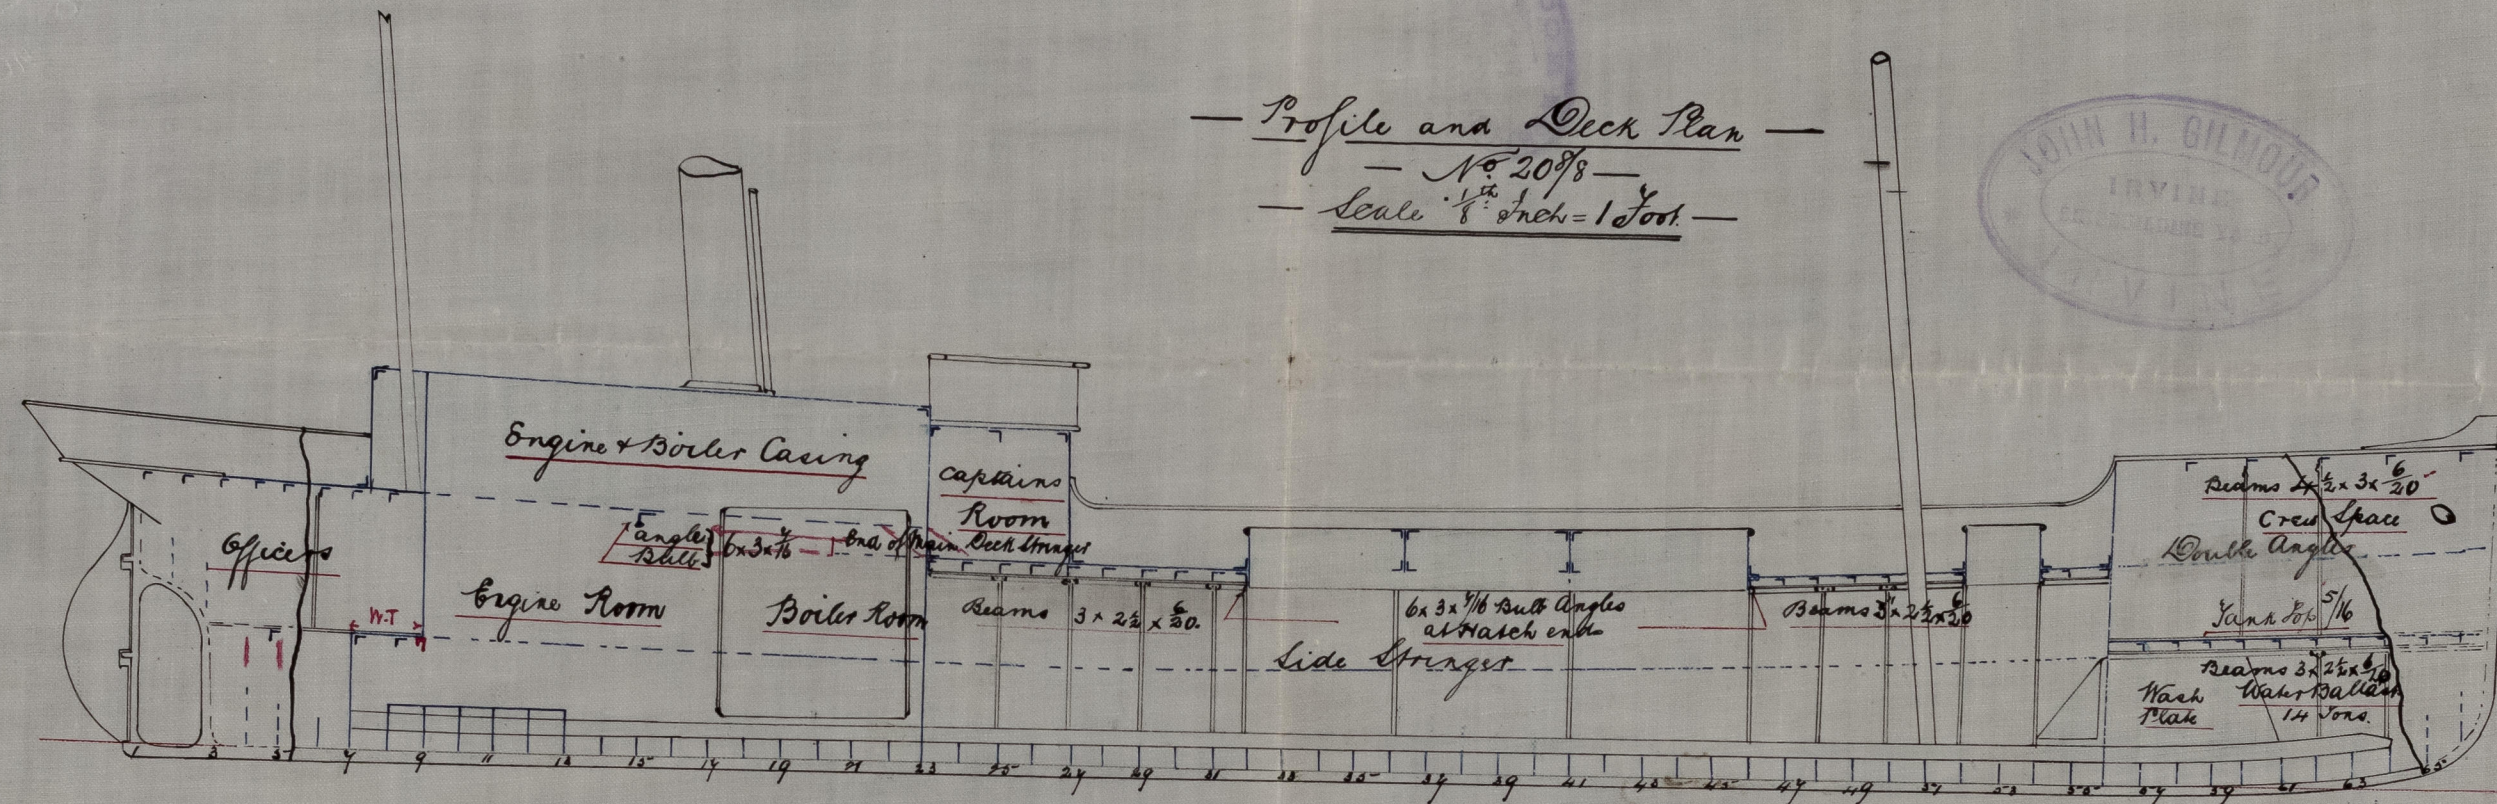

C.E.  
 23/2/94

18/1  
 28/2/94



© 2021


Lloyd's Register  
 Foundation

GLS242-0081



"  
S.S. Scotsman" Glasgow Report 13092. —

28. 2. 94.

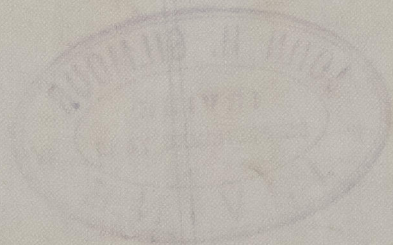

© 2021

Lloyd's Register  
Foundation

GLS 242-0081

