

## Lloyd's Register of British and Foreign Shipping.

(Report on Vessel No. 13092, Port Glasgow  
Scotsman.)No. 4528 SHIP FORGINGS ~~OR CASTINGS~~.

I have to report that the undermentioned, Iron ~~or Steel~~ Forgings ~~or Castings~~,  
 manufactured by Messrs The Irvine Forge Coy  
 of Irvine for the Vessel No. 20, being built  
 by Mr J H Gilmour of Irvine  
 have been inspected by me as set forth below, and found to be, so far as can be seen,

Mark on Forgings.

Lloyd's

No. 4528W.H.


William Hamilton

Glasgow

13/4/94STEM. Nut bars

	STERN FRAME.	RUDDER FRAME.	STEM.
Material*	Scrap, iron		Rolled bar iron
How made	Forged		Rolled
Dimensions	$5\frac{3}{4} \times 2\frac{1}{2}$		$6 \times 1\frac{1}{4}$
Progress on Inspection	Forging & smithing		When machined
Date when Inspected	9. 12. 15. 19. 23. 29/3/94 3. 5. 10. 12/4/94		15/3/94

SKETCHES OF FRAMES SHOWING POSITION AND DESCRIPTION OF WELDS OF FORGINGS, OR PARTICULARS OF  
 TESTS APPLIED TO CASTINGS.

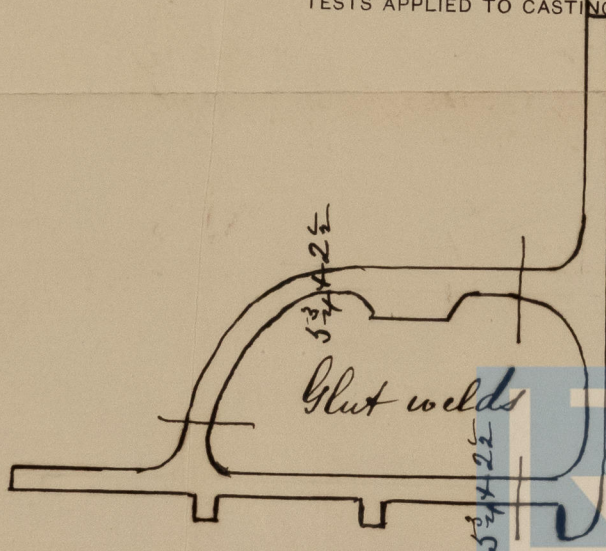

\* If of Iron, state whether scrap or puddled Iron.