

Lloyd's Register of British and Foreign Shipping.

(Report on Vessel No. 13160 Port Glasgow)

Amelia

No. 4565 SHIP FORGINGS ~~OR CASTINGS.~~

The words FORGINGS or CASTINGS, IRON or STEEL, should be struck out as may be required.

I have to report that the undermentioned Iron ~~or Steel~~ Forgings ~~or Castings~~,
manufactured by Messrs Robt Kerr & Sons
of Irvine for the Vessel No. 44, being built
by Messrs S Mc Knight & Co of Ayr
have been inspected by me as set forth below, and found to be, so far as can be seen,
Sound & efficient

Mark on Forgings.

Lloyd's

No.



W.H.

William Hamilton


Glasgow
5/5/94

	STERN FRAME.	RUDDER FRAME.	STEM.
Material* ...	<u>Scrap iron</u>		/
How made ...	<u>Forged</u>		
Dimensions ...	<u>6 1/2 x 3</u>		
Progress on Inspection	<u>Forging & smithing</u>		
Date when Inspected	<u>6. 12. 13. 17. 19. 24/4/94</u> <u>3. 5/5/94</u>		

SKETCHES OF FRAMES SHOWING POSITION AND DESCRIPTION OF WELDS OF FORGINGS, OR PARTICULARS OF TESTS APPLIED TO CASTINGS.

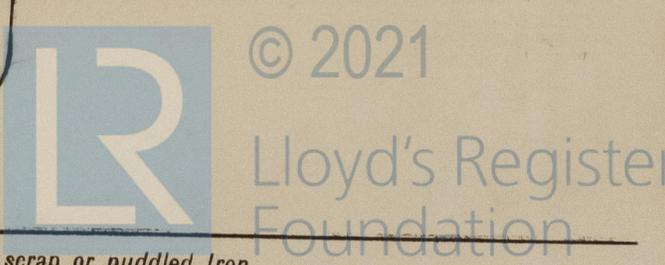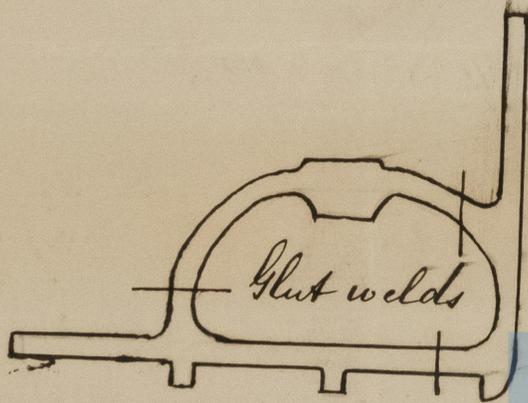

M^c Knight 44

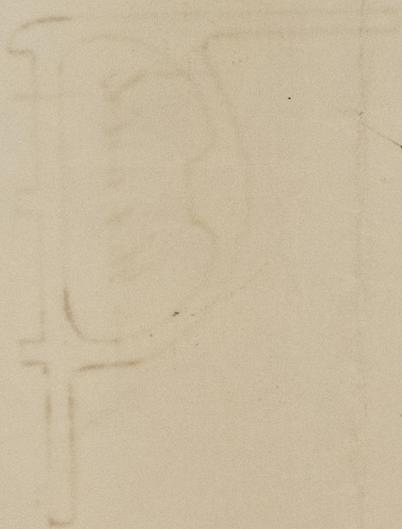

16/11



© 2021

Lloyd's Register
Foundation