

Lloyd's Register of British and Foreign Shipping.

(Report on Vessel No. 13160 Port Glasgow  
"Amelia,")

No. 4565 SHIP FORGINGS OR CASTINGS.

I have to report that the undermentioned Iron or Steel Forgings or Castings,  
 manufactured by Messrs Robt Kerr & Sons  
 of Irvine for the Vessel No. 44, being built  
 by Messrs S Mc Knight & Co of Ayr  
 have been inspected by me as set forth below, and found to be, so far as can be seen,  
Sound & efficient

The words FORGINGS or CASTINGS, IRON or STEEL, should be struck out as may be required.


Mark on Forgings.

Lloyd's  
 No. 4565  
 W. H.

William Hamilton  
Glasgow 2/7/94

	STERN FRAME.	RUDDER FRAME.	STEM.
Material*	/	Scrap iron	/
How made		Forged	
Dimensions		4 1/2 to 2 1/4 dia	
Progress on Inspection		Forging & smithing	
Date when Inspected		7.13.19.27.29/6/94	

SKETCHES OF FRAMES SHOWING POSITION AND DESCRIPTION OF WELDS OF FORGINGS, OR PARTICULARS OF TESTS APPLIED TO CASTINGS.

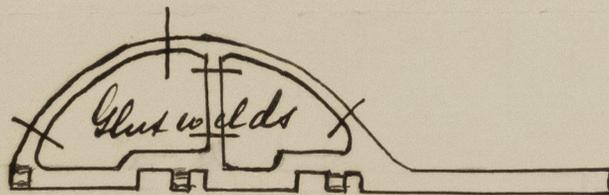

© 2021

Lloyd's Register  
 Foundation