



88. N^o 504.

Scale $\frac{1}{4}'' = 1 \text{ Foot.}$

10. 9. 94
9. 10. 94
12. 10. 94

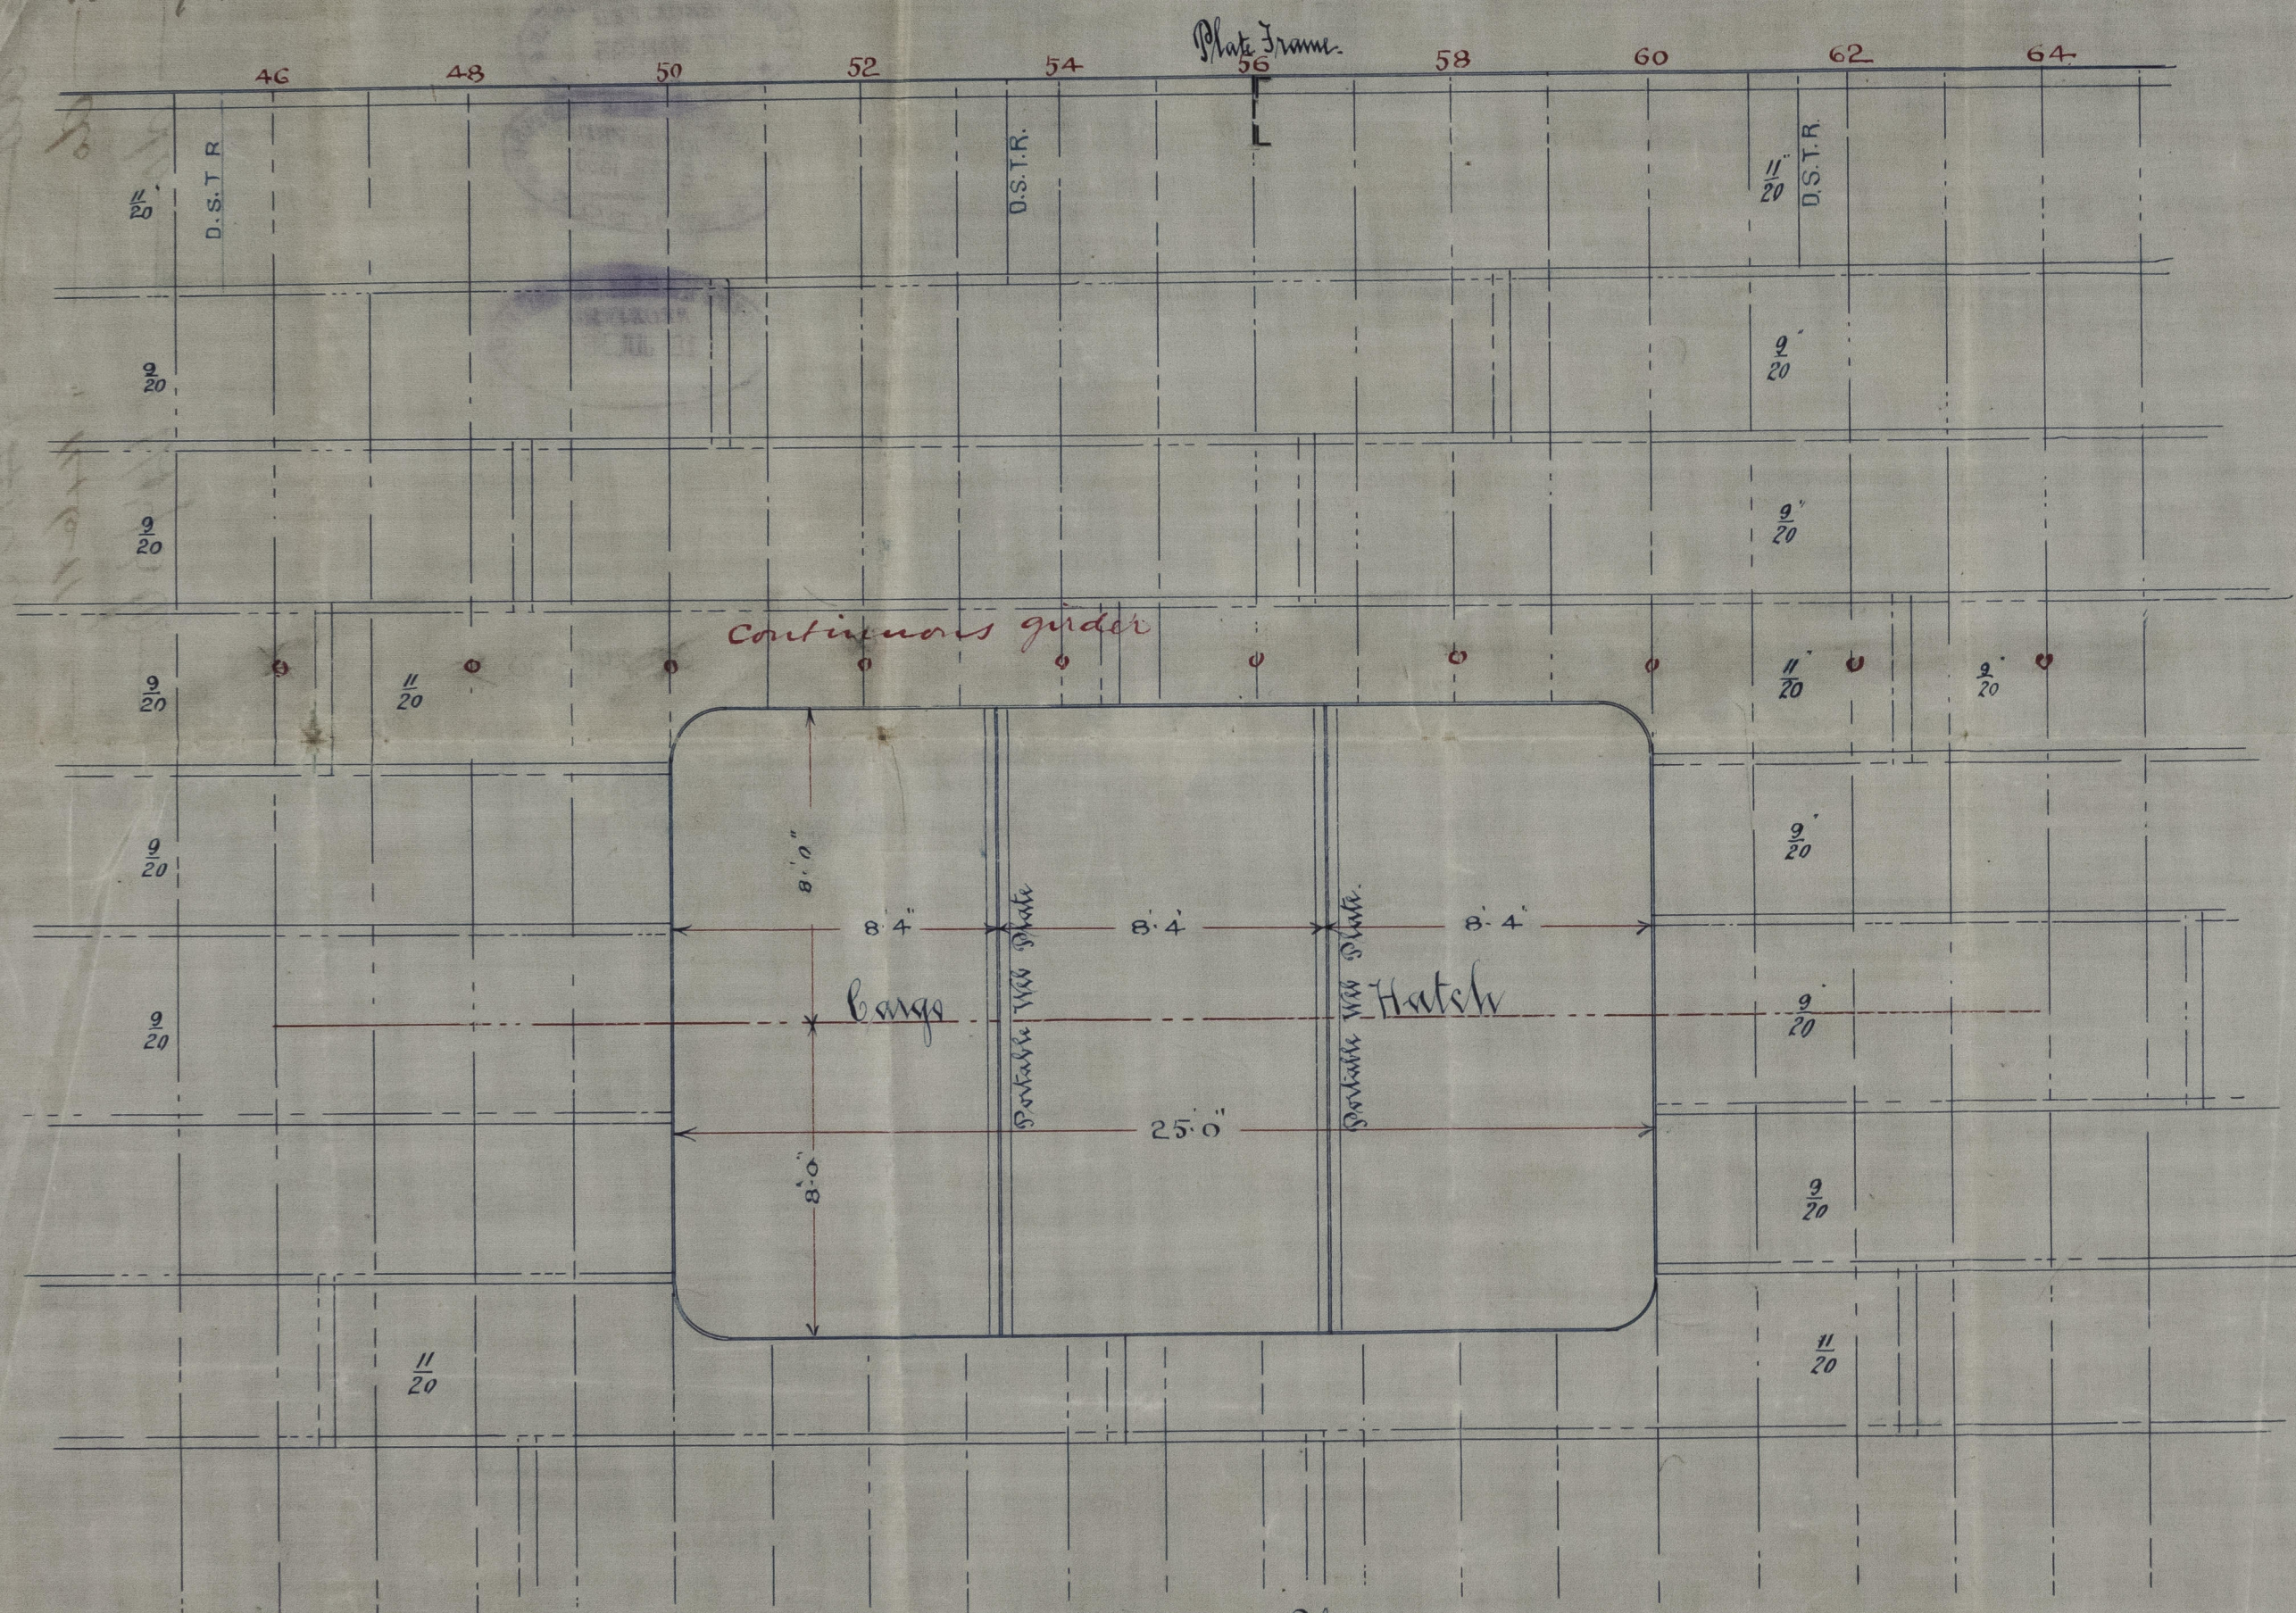





—Upper Deck Plan.—

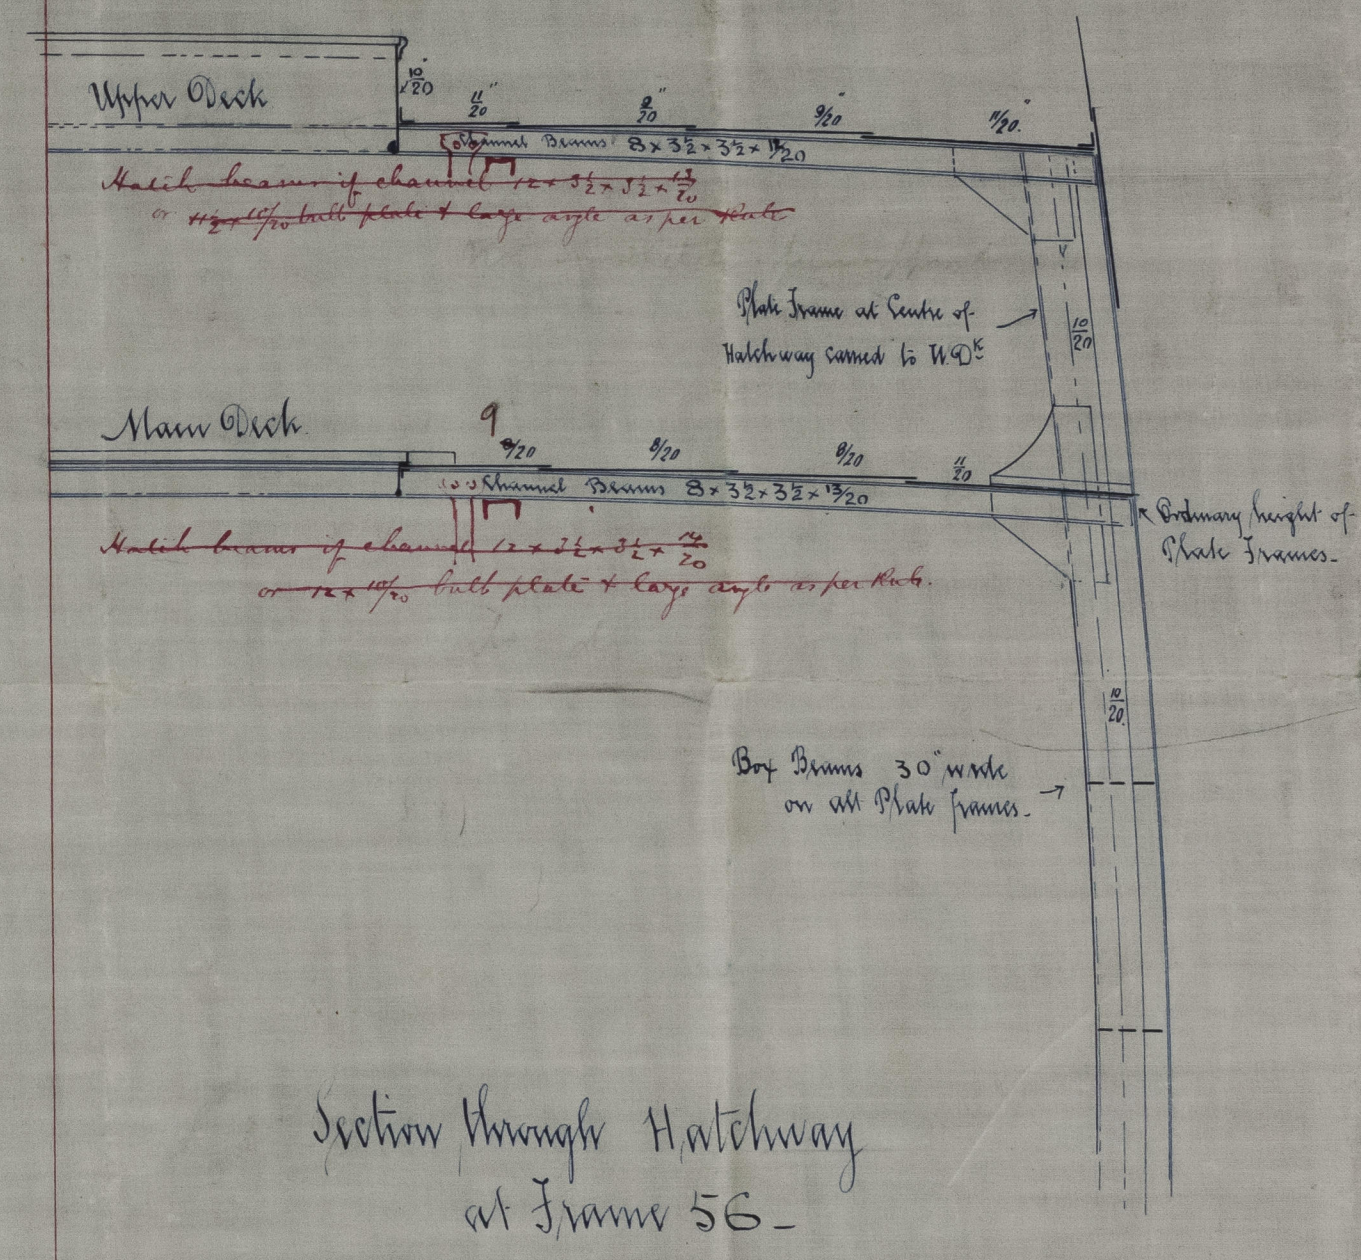

Section through Hatchway
at Frame 56-

J.M.
8/9/94
12/9/94

S.S. "Ekhla" Glasgow Report No 13491.—
 S.S. "Ekara" do " 14103.—
 S.S. "Onipentä" do " 141611.—
 S.S. "Polobaria" do " 141456.—

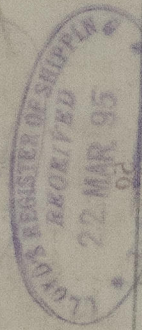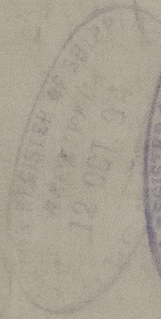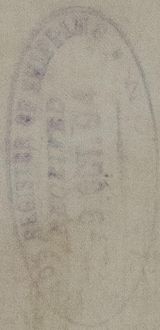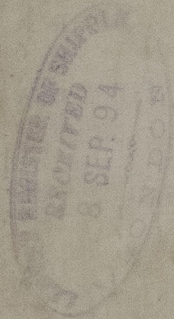

© 2021

Lloyd's Register
Foundation

GLS249-0006