
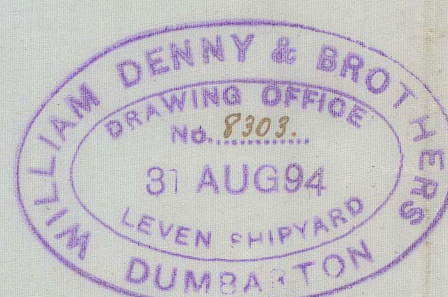
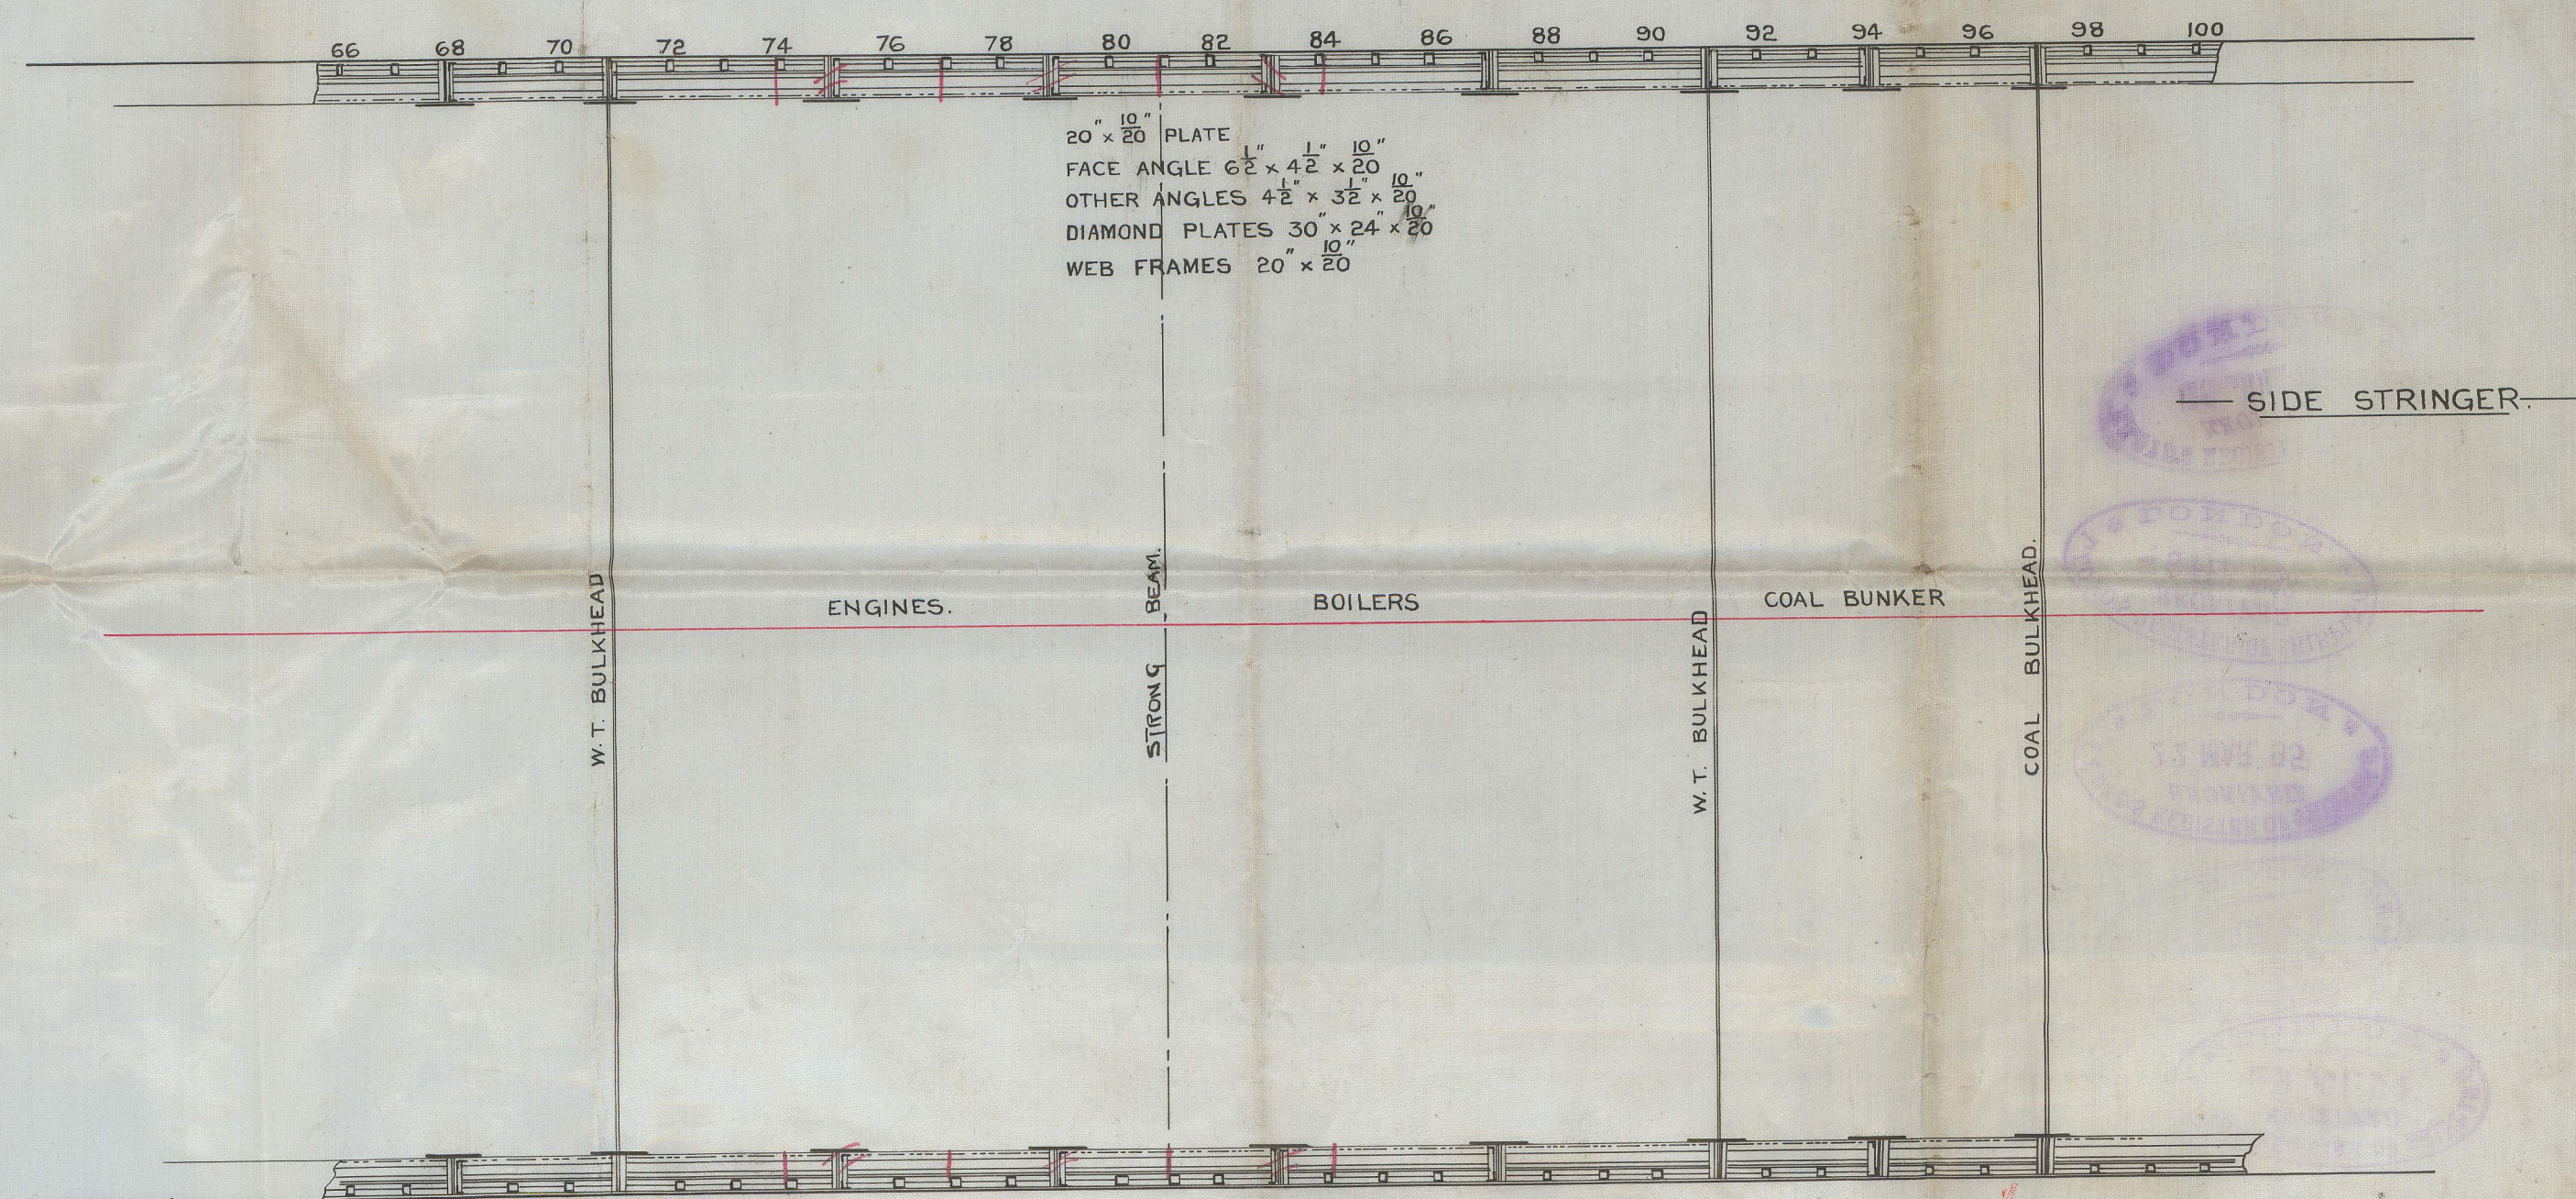
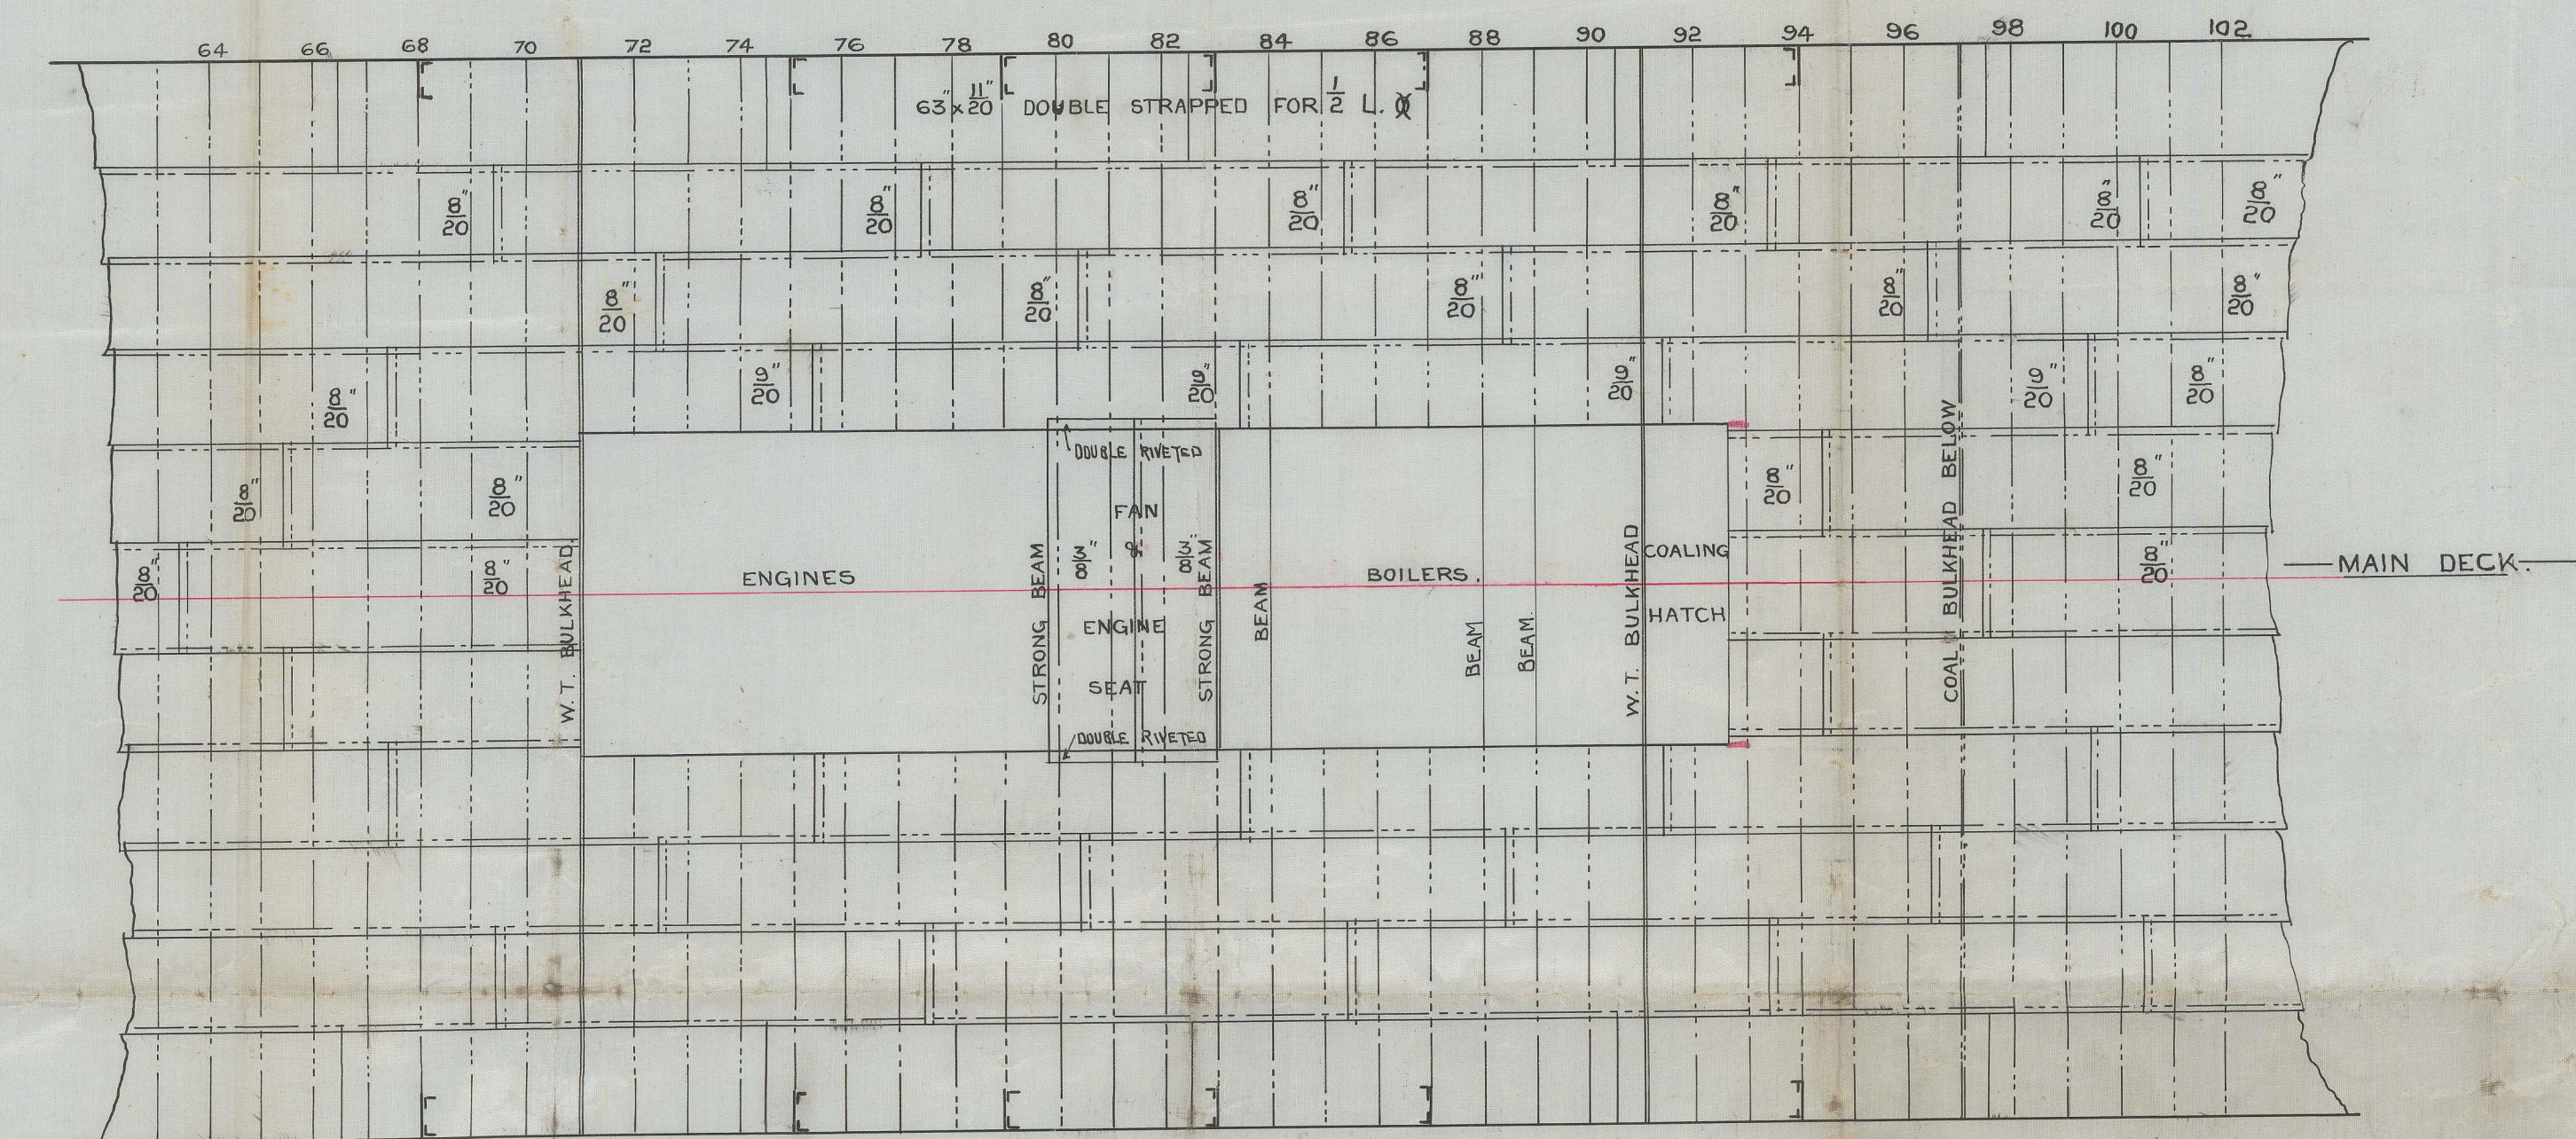
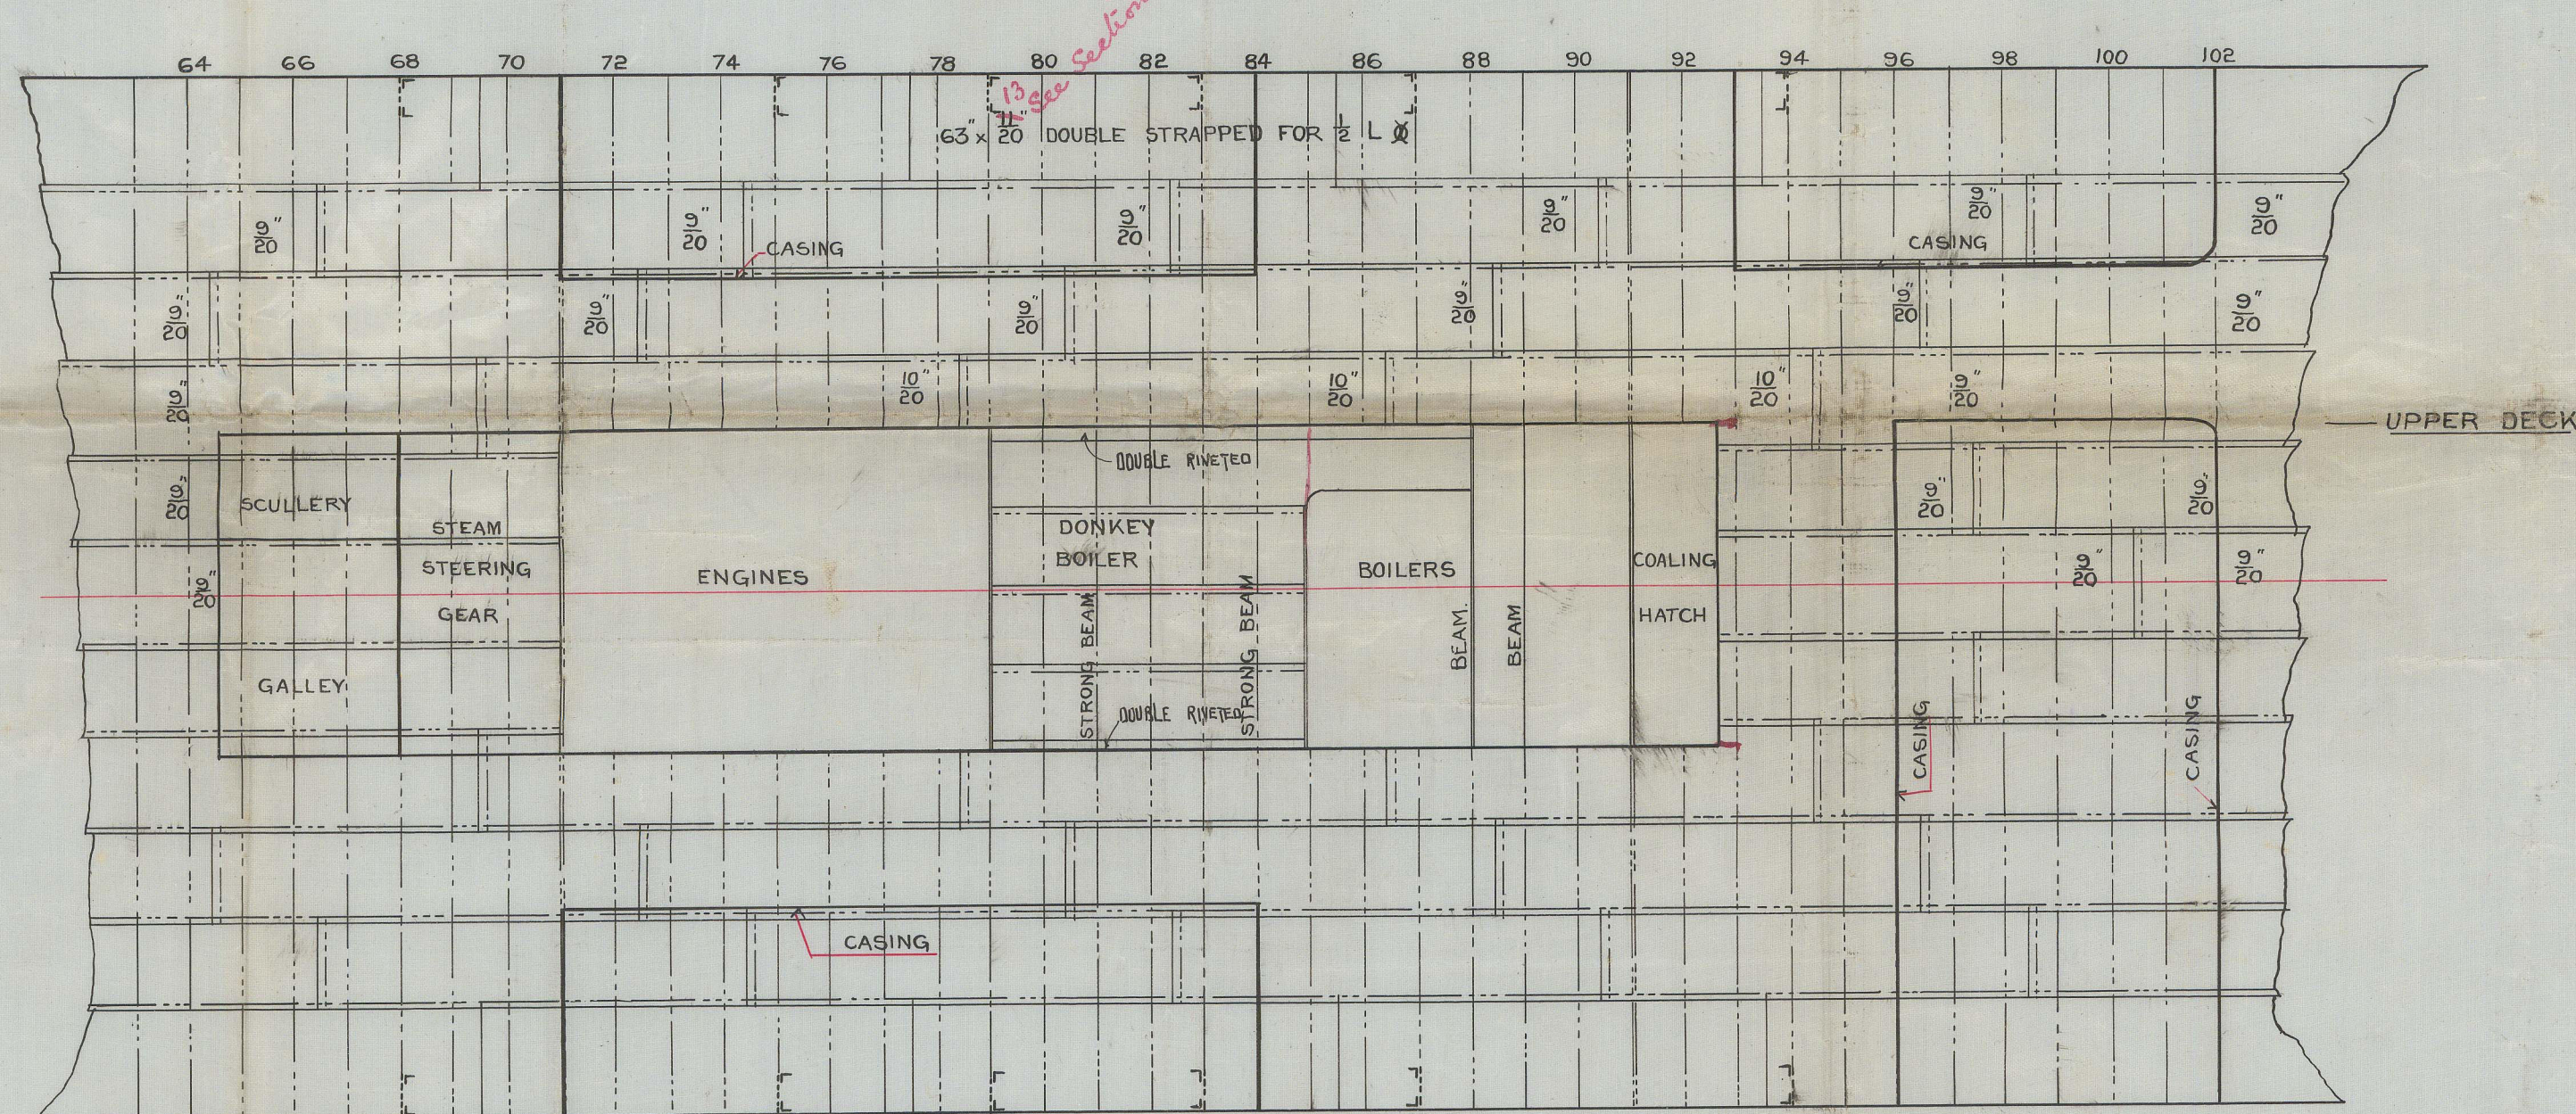
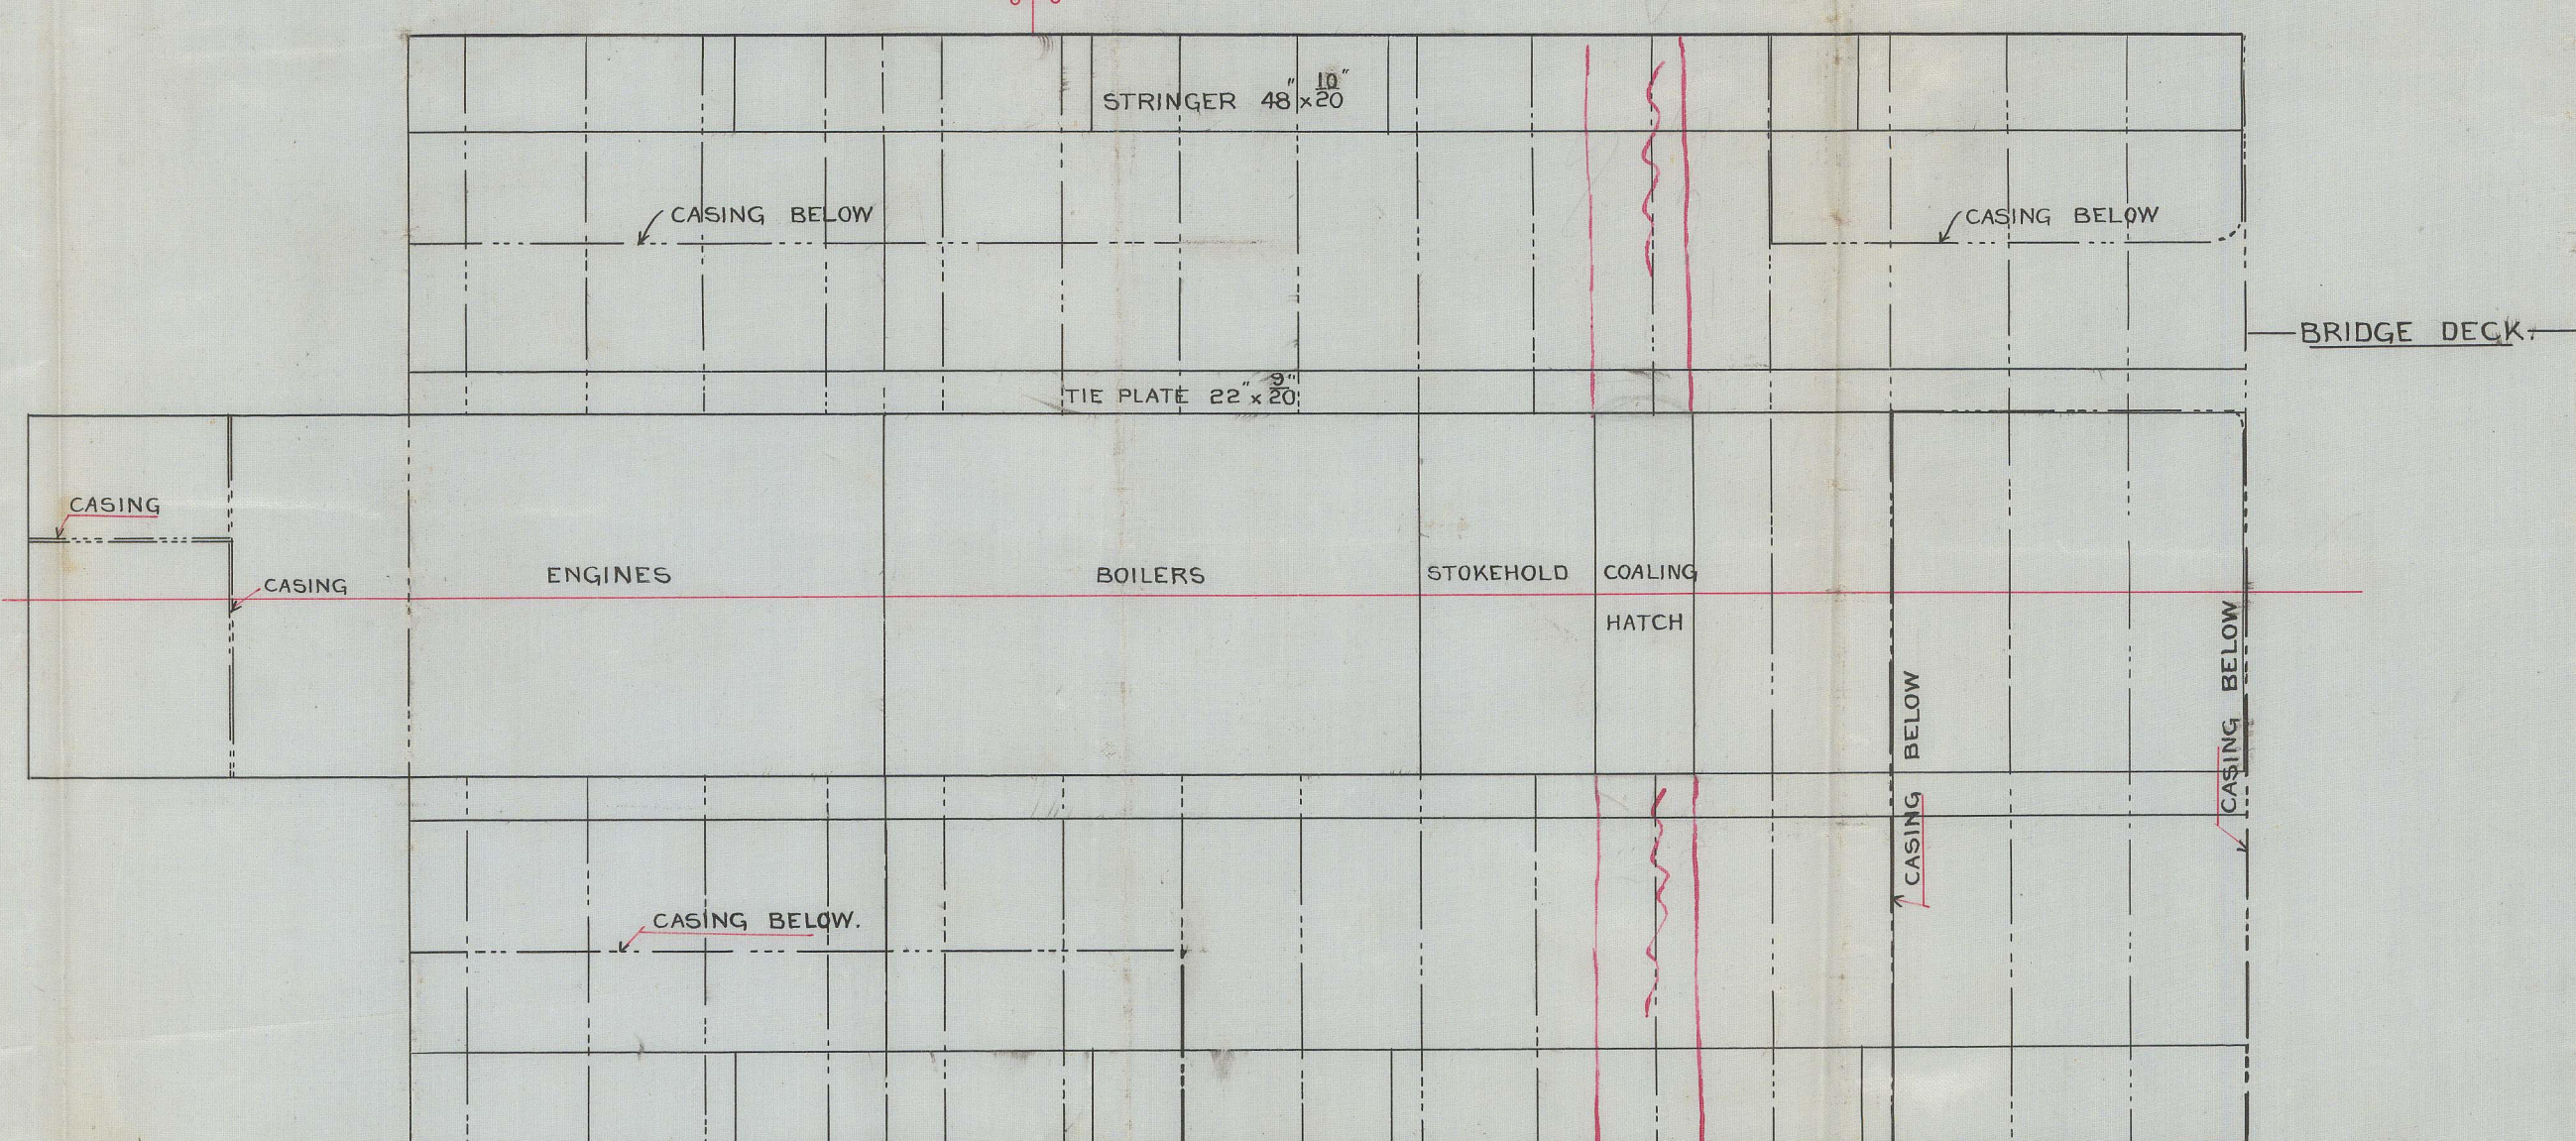


S.S. № 504






SCALE $\frac{1}{8}$ INCH = 1 FOOT.

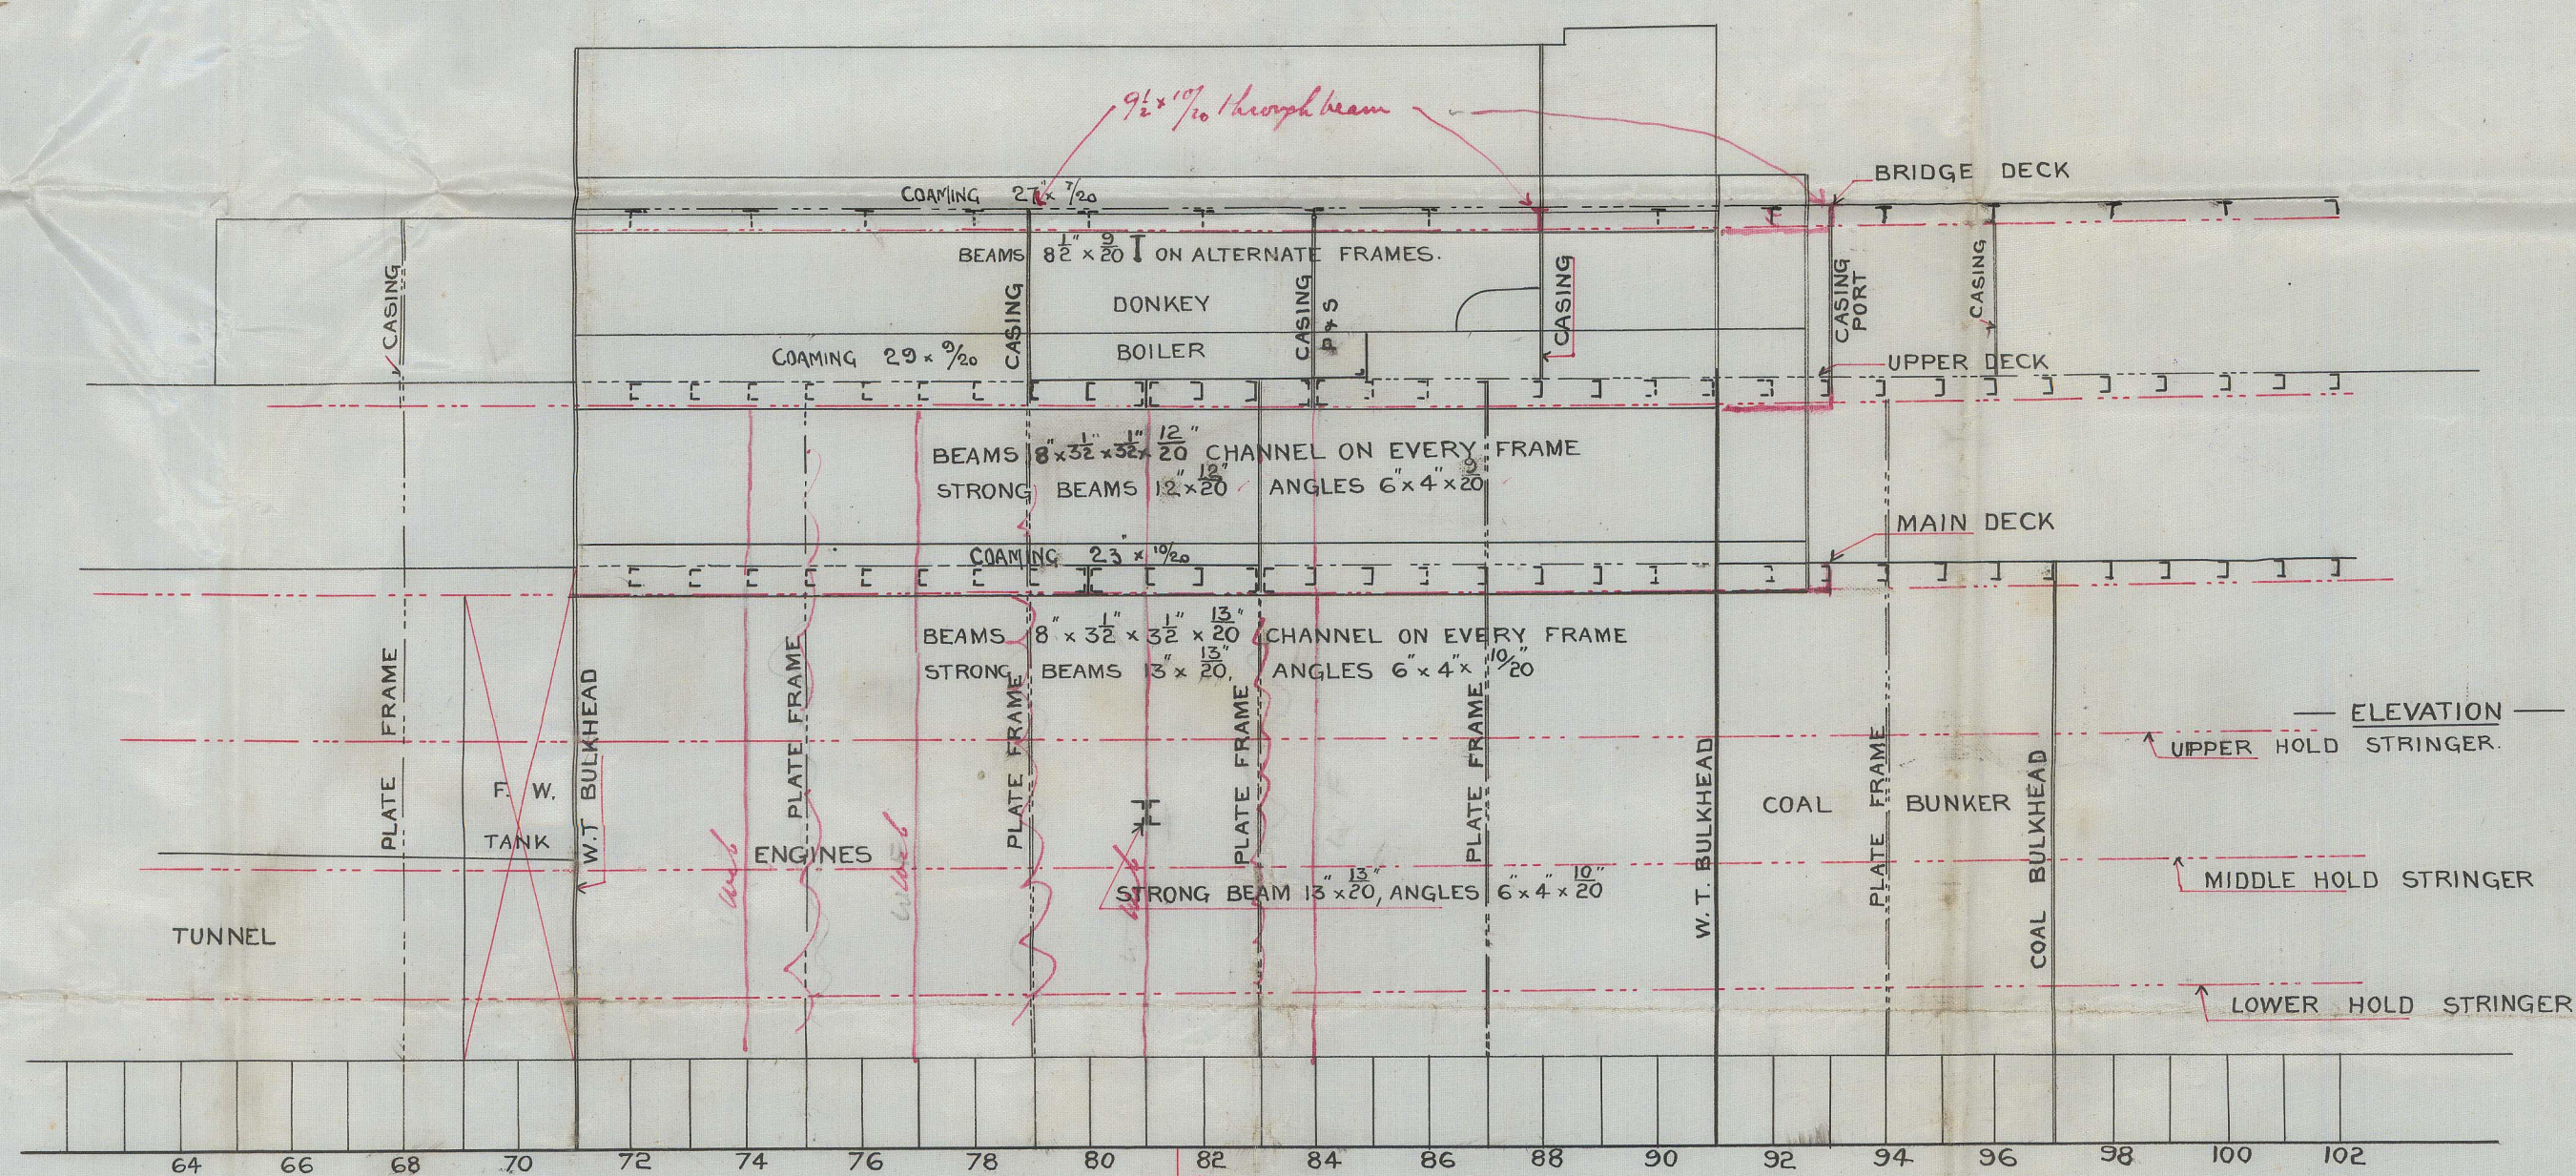

5. 9. 94
9. 10. 94
12. 10. 94

[illegible]

GLS249-0009

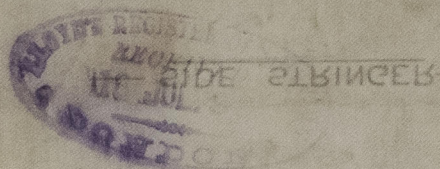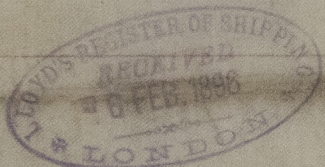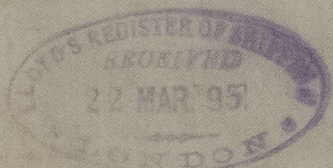 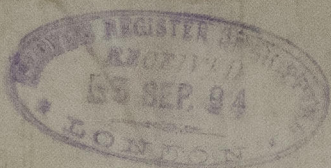

COAL BULKHEAD

J. J. "Phila" Glasgow Report No 13491. —
J. J. "Chrana" — do — " 14103. —
J. J. "Prinkta" — do — " 14611. —
J. J. "Polatania" — do — " 14456. —



© 2021

Lloyd's Register
Foundation