

Lloyd's Register of British and Foreign Shipping.

(Report on Vessel No. 13491 Port Glasgow)No. 4682SHIP FORGINGS ~~OR CASTINGS~~

I have to report that the undermentioned ~~Iron or Steel Forgings or Castings~~,
 manufactured by The Lumberton Forge Co.
 of Lumberton for the Vessel No. 504, being built
 by Messrs. Wm. Lunn & Bros. of Lumberton,
 have been inspected by me as set forth below, and found to be, so far as can be seen,
Sound

Mark on Forgings.

Lloyd's

No. 4682F.C.


Frank Cook.

Glasgow

30/11/94
STEM.

	STERN FRAME.	RUDDER FRAME.	STEM.
Material* ...	<u>Scrap Iron</u>		
How made ...	<u>Forged</u>		
Dimensions ...	<u>11 1/2" x 7 1/2"</u>		
Progress on Inspection	<u>Forged & smithed</u>		
Date when Inspected	<u>1.4.9.12.16.19.20/10/94.2.</u> <u>6.9.18.20.22.27.29/11/94</u>		

SKETCHES OF FRAMES SHOWING POSITION AND DESCRIPTION OF WELDS OF FORGINGS, OR PARTICULARS OF
 TESTS APPLIED TO CASTINGS.

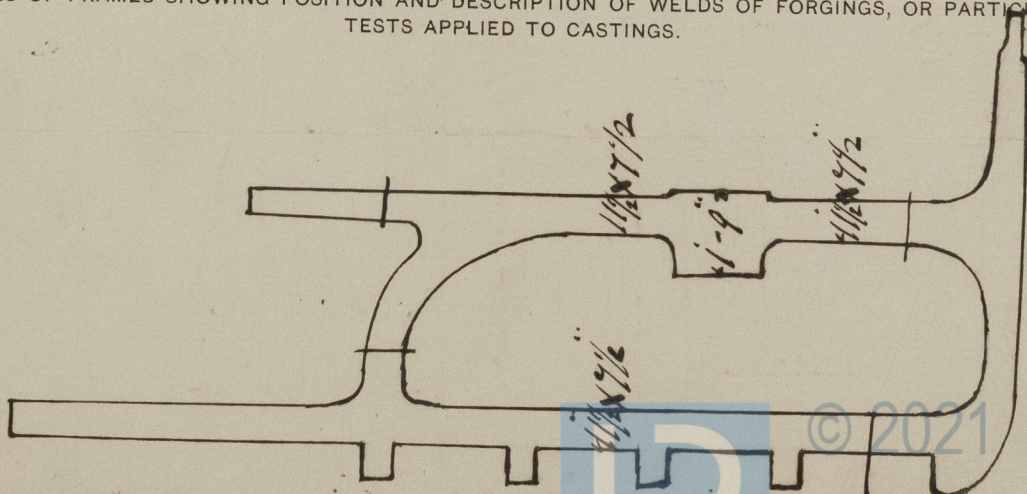

©2021

Lloyd's Register
Foundation