

## Lloyd's Register of British and Foreign Shipping.

(Report on Vessel No. 14051 PortGlasgow  
"Prins Hendrik"No. 4826

## SHIP FORGINGS OR CASTINGS

I have to report that the undermentioned Iron ~~or Steel~~ Forgings ~~or Castings~~,  
manufactured by The Kilmystown Forge Co.

of Kilmystown.for the Vessel No. 386, being builtby The Fairfield, S.B. & Eng. Co. of Glasgow.

have been inspected by me as set forth below, and found to be, so far as can be seen,

Sound


Mark on Forgings.

Lloyd's

No. 4826ECFrank Cook.Glasgow.

	STERN FRAME.	RUDDER FRAME.	STEM.
Material* ...		<u>Scrap Iron</u>	<u>Scrap Iron.</u>
How made ...		<u>Forged.</u>	<u>Forged</u>
Dimensions ...		<u>8 1/4" dia</u>	<u>7 1/2 x 1 3/4</u>
Progress on Inspection		<u>Forged &amp; smithed</u>	<u>Forged &amp; smithed</u>
Date when Inspected		<u>2/4/95. to 28/6/95.</u>	<u>14.26/2/95. 14/3/95</u>

SKETCHES OF FRAMES SHOWING POSITION AND DESCRIPTION OF WELDS OF FORGINGS, OR PARTICULARS OF  
TESTS APPLIED TO CASTINGS.

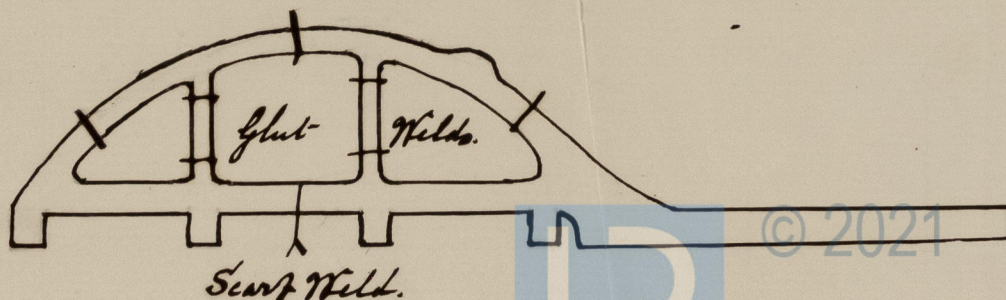

Fee (if any chargeable) £ : :

To be paid at

\* If of Iron, state whether scrap or puddled Iron.