
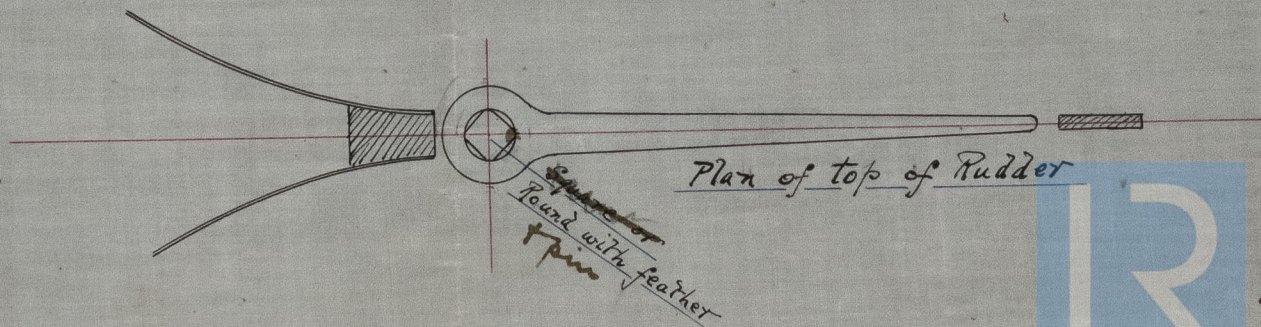


Plan of Rudders and Sternposts No. 297. P. S.

Scale 1 1/2 in = One Foot.

R. SEATH & CO.
ENGINEERS
DUBLIN

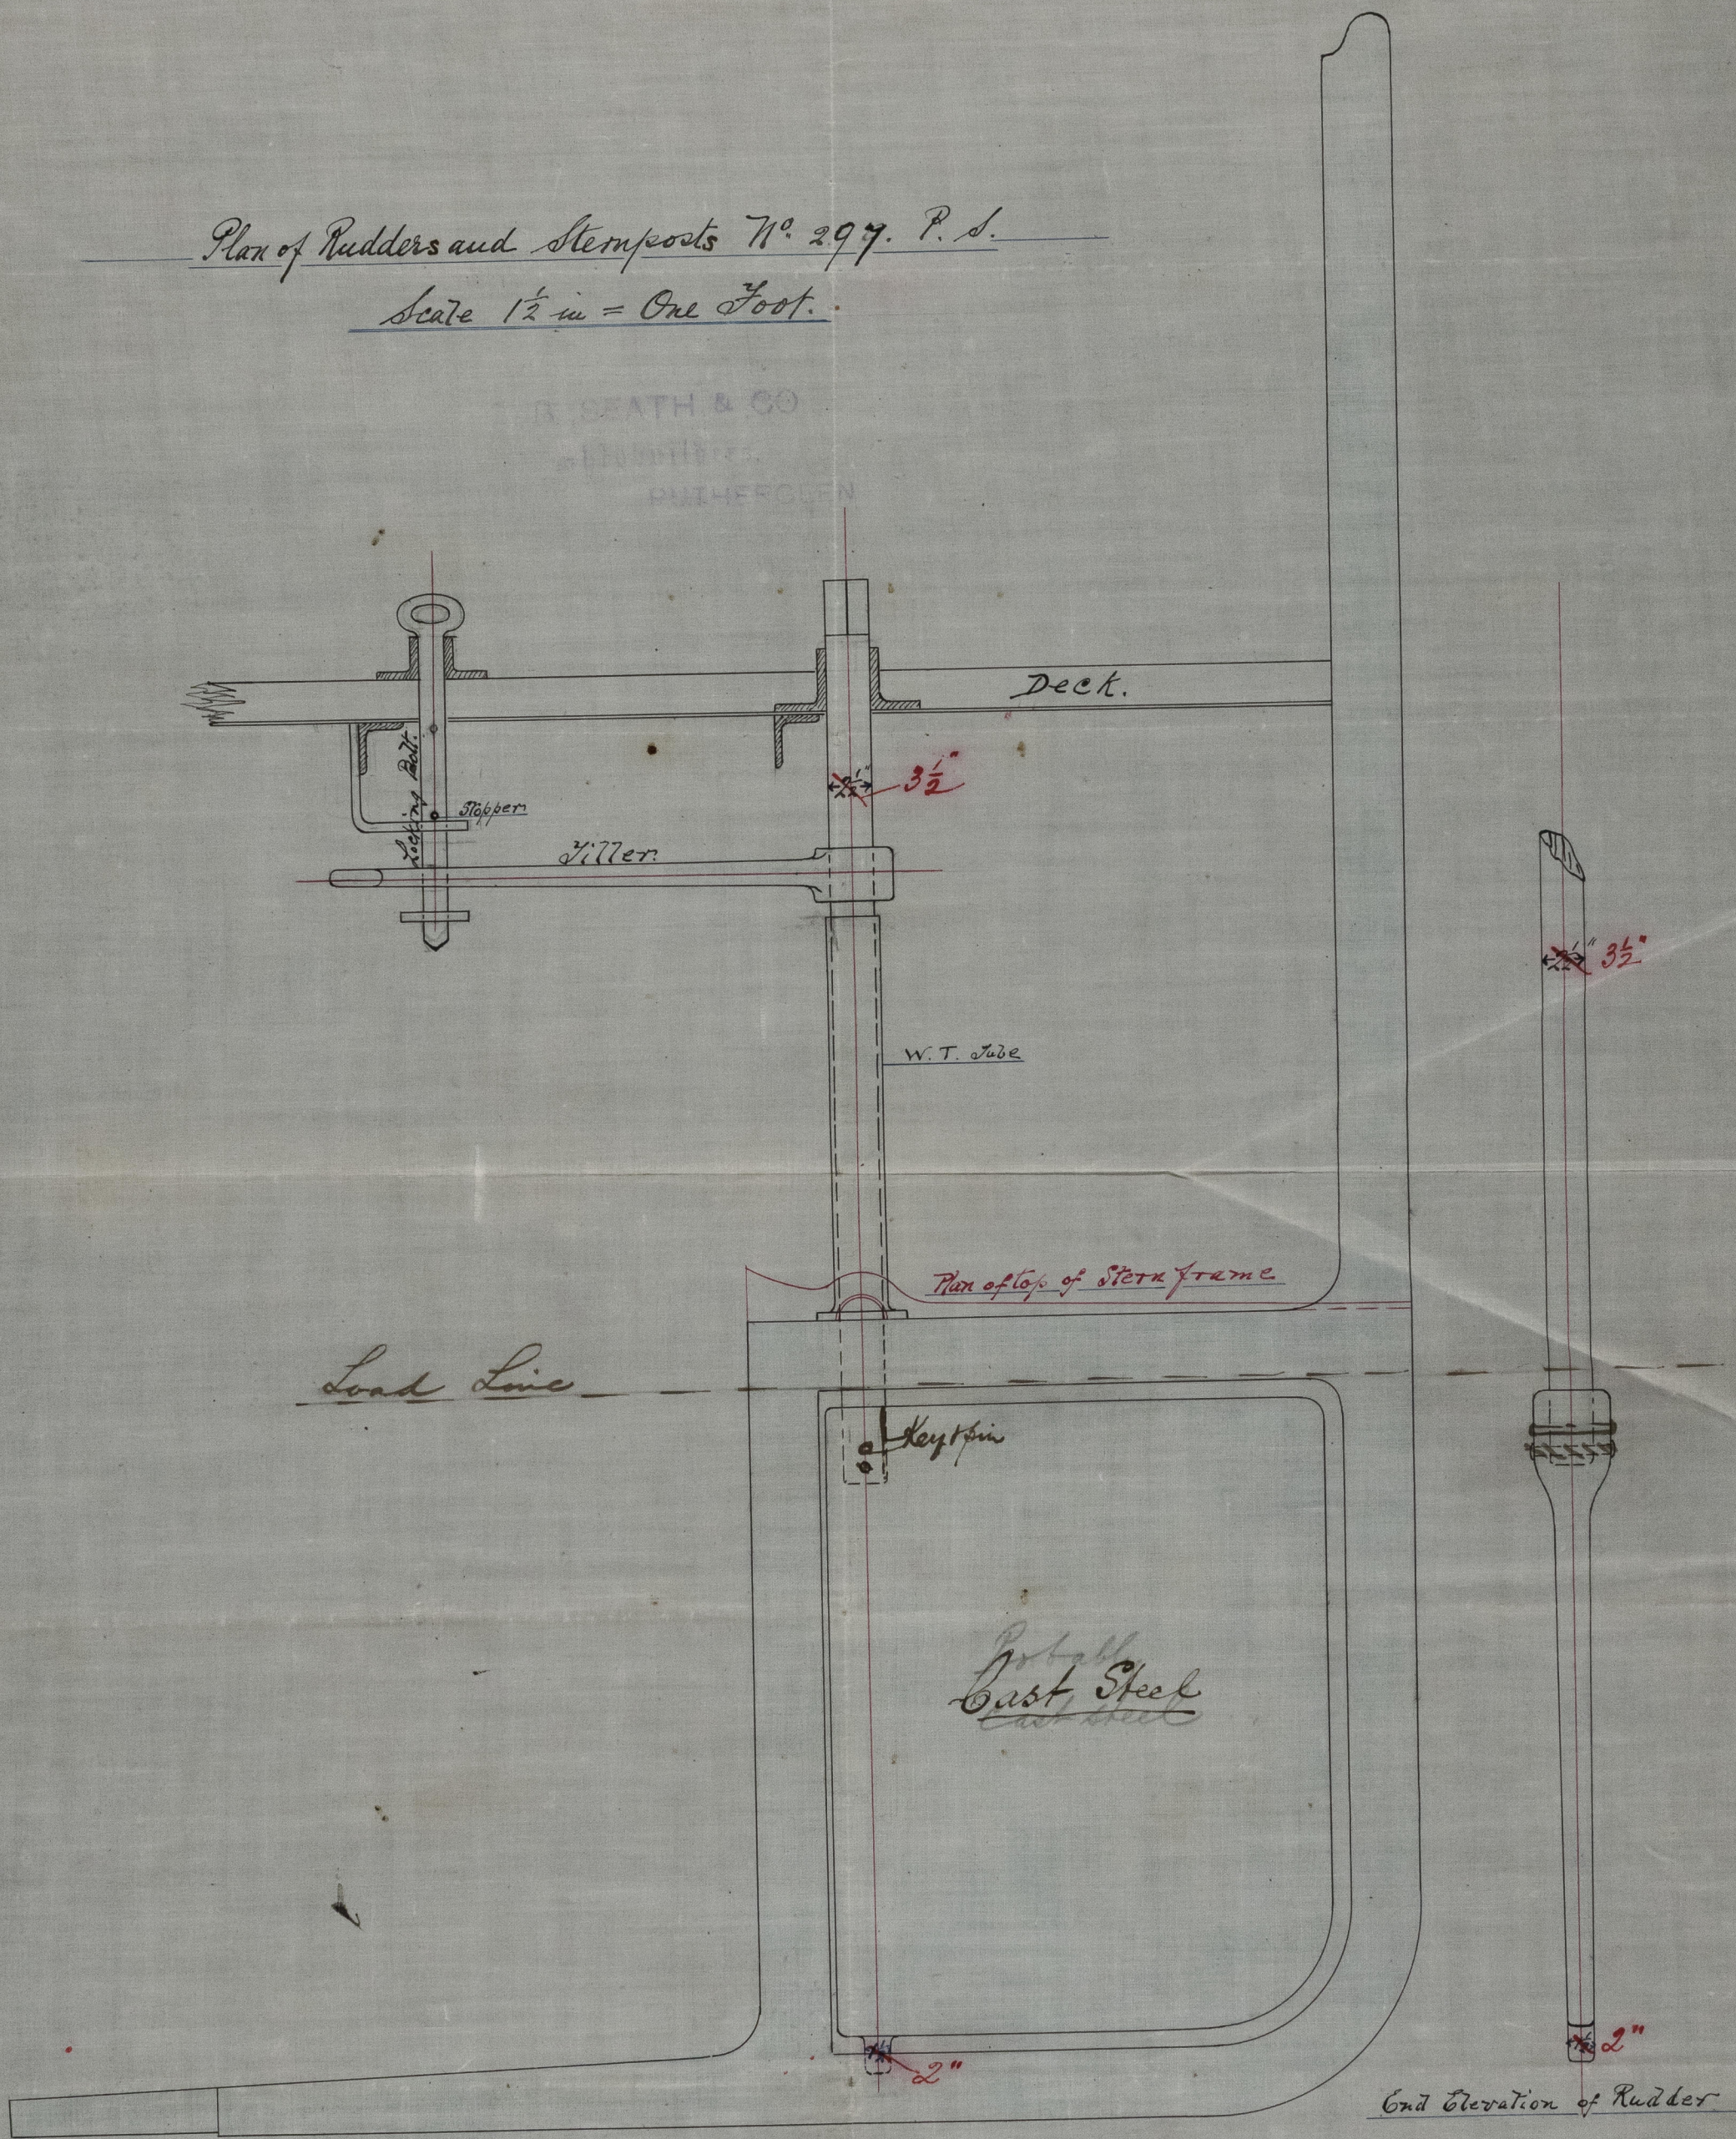

Plan of top of Rudder






© 2021
5/10/95
Lloyd's Register
Foundation

GLS252-0114

"Arvon" Glasgow Report No. 14228.

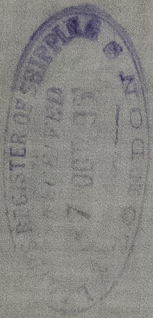

20 2/10/33
104

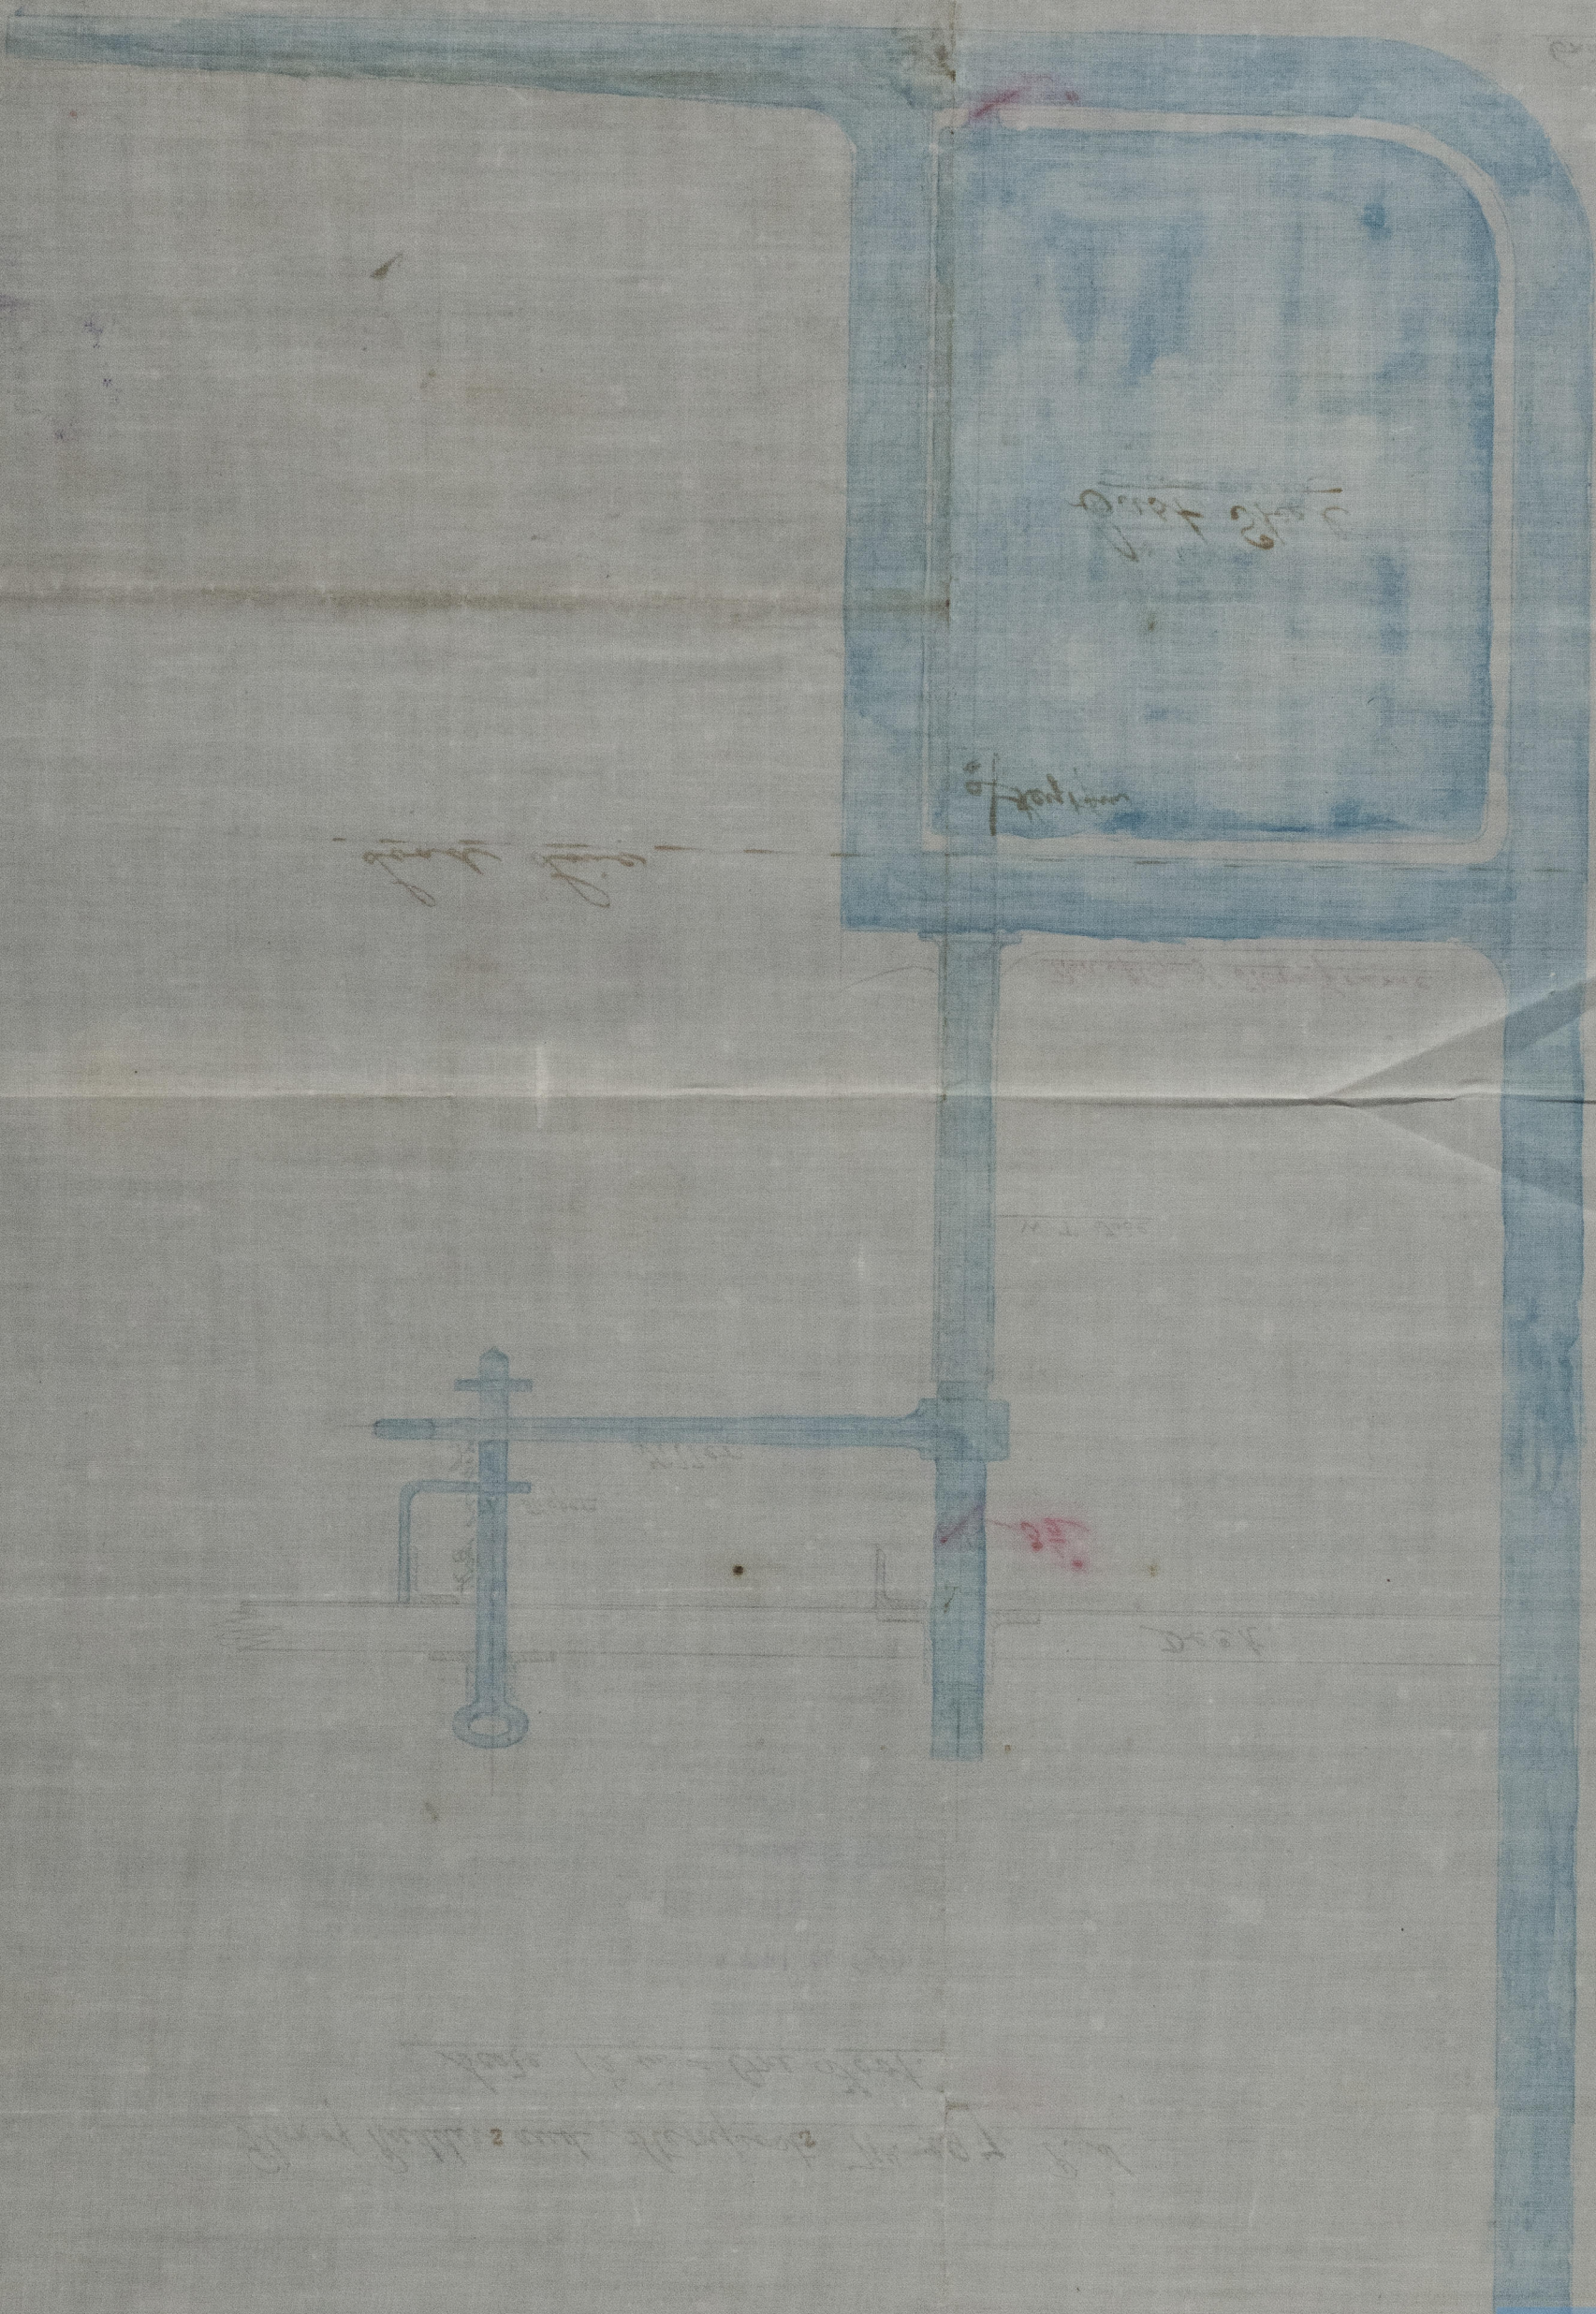

4110-25254



© 2021
Lloyd's Register
Foundation