



Ref 4.11.95



PUMPING ARRANGEMENT PLAN OF No 297 P.S.

SCALE 1/4" = ONE FOOT.


B SEATH & CO
Shipbuilders,
RUTHERGLEN

Sketch of proposed arrangement

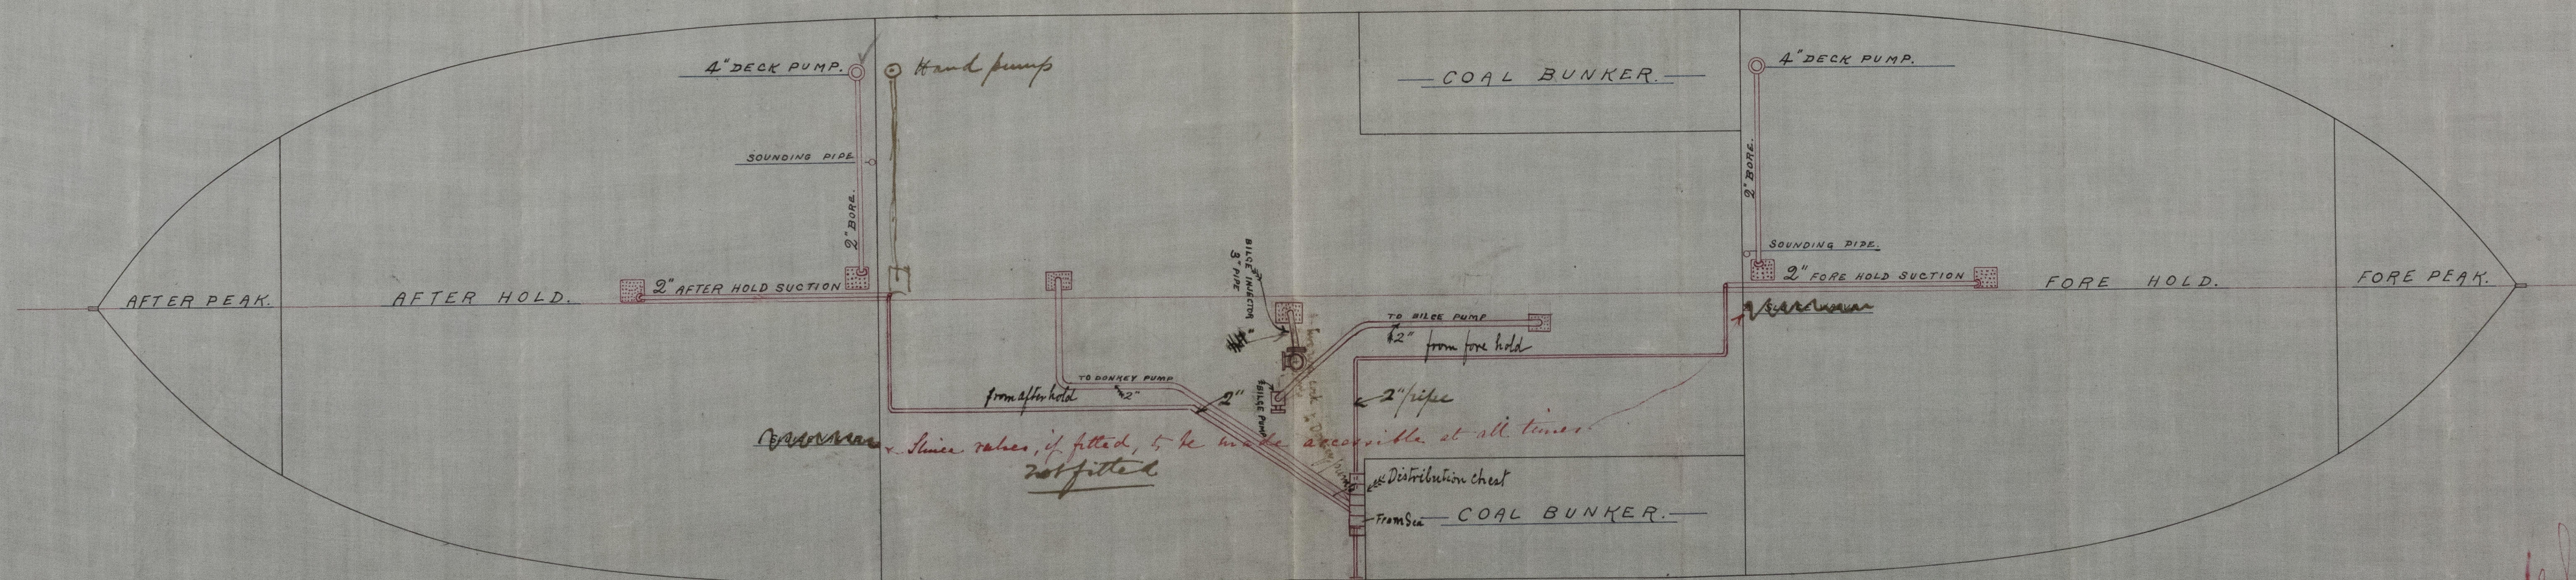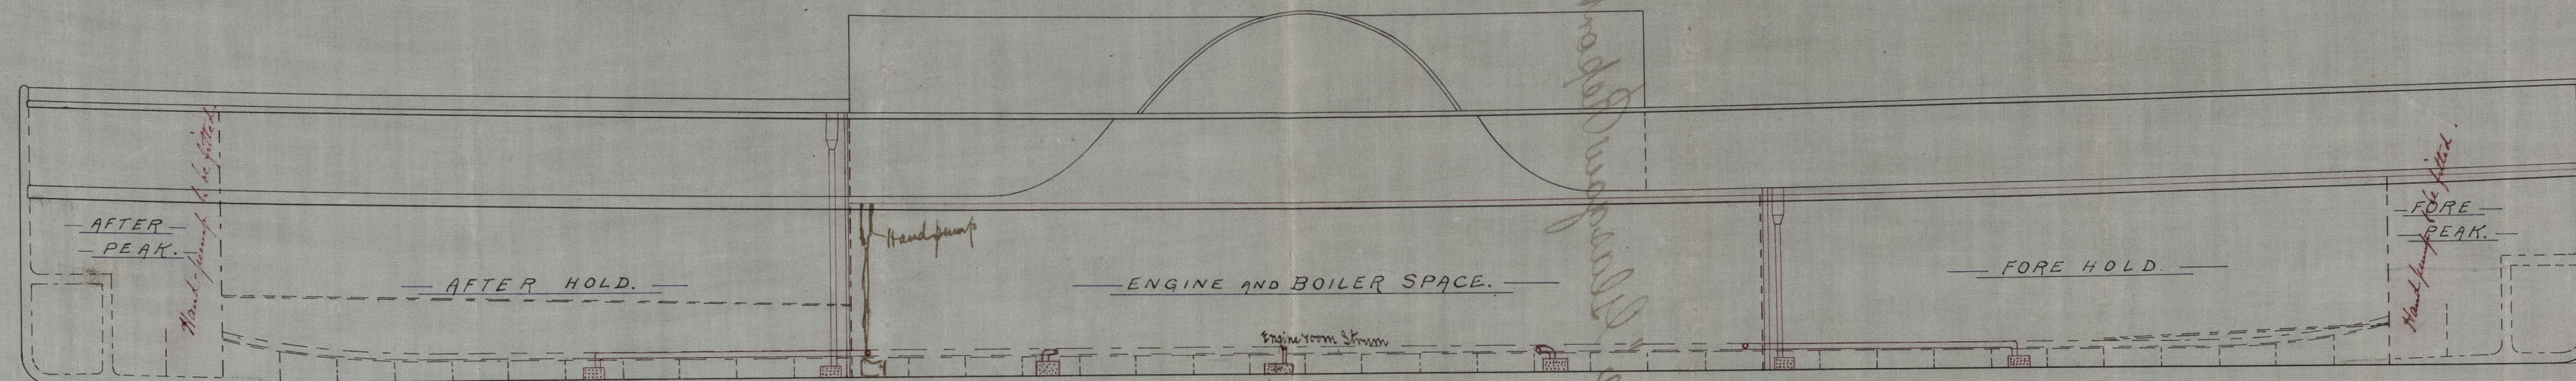

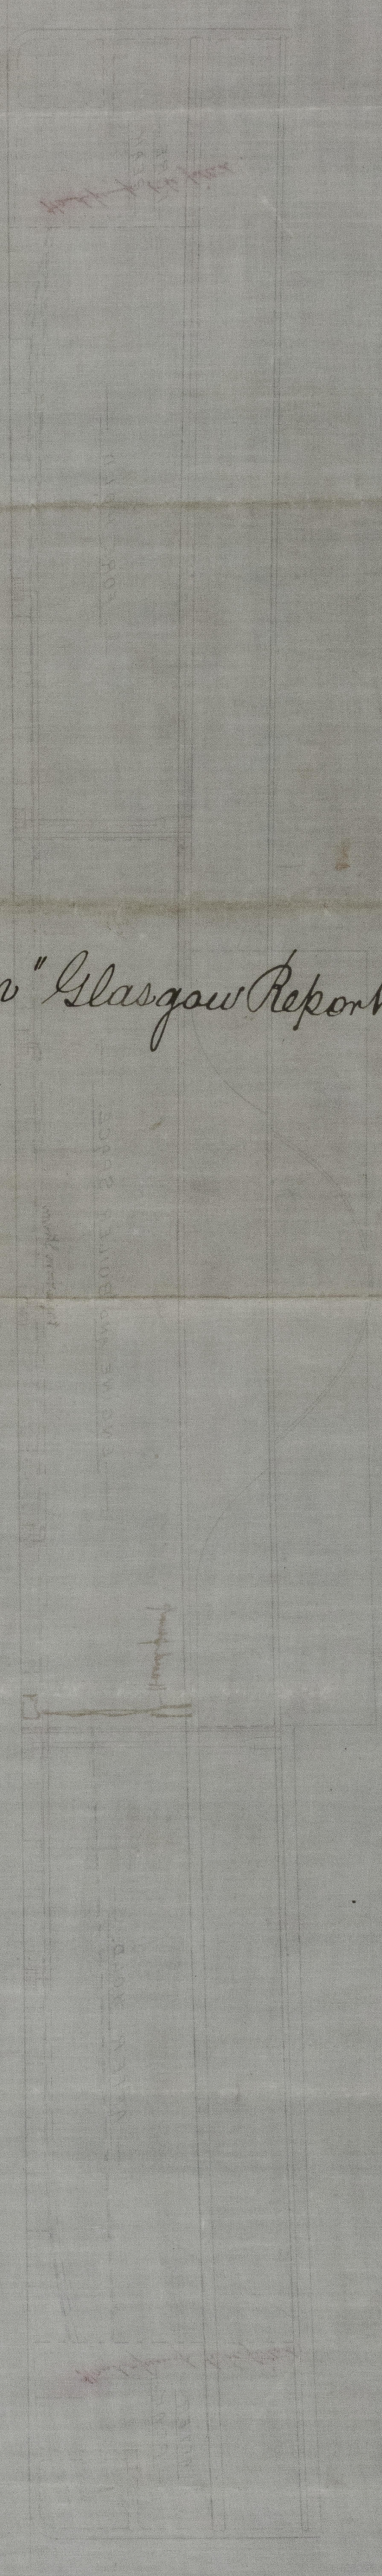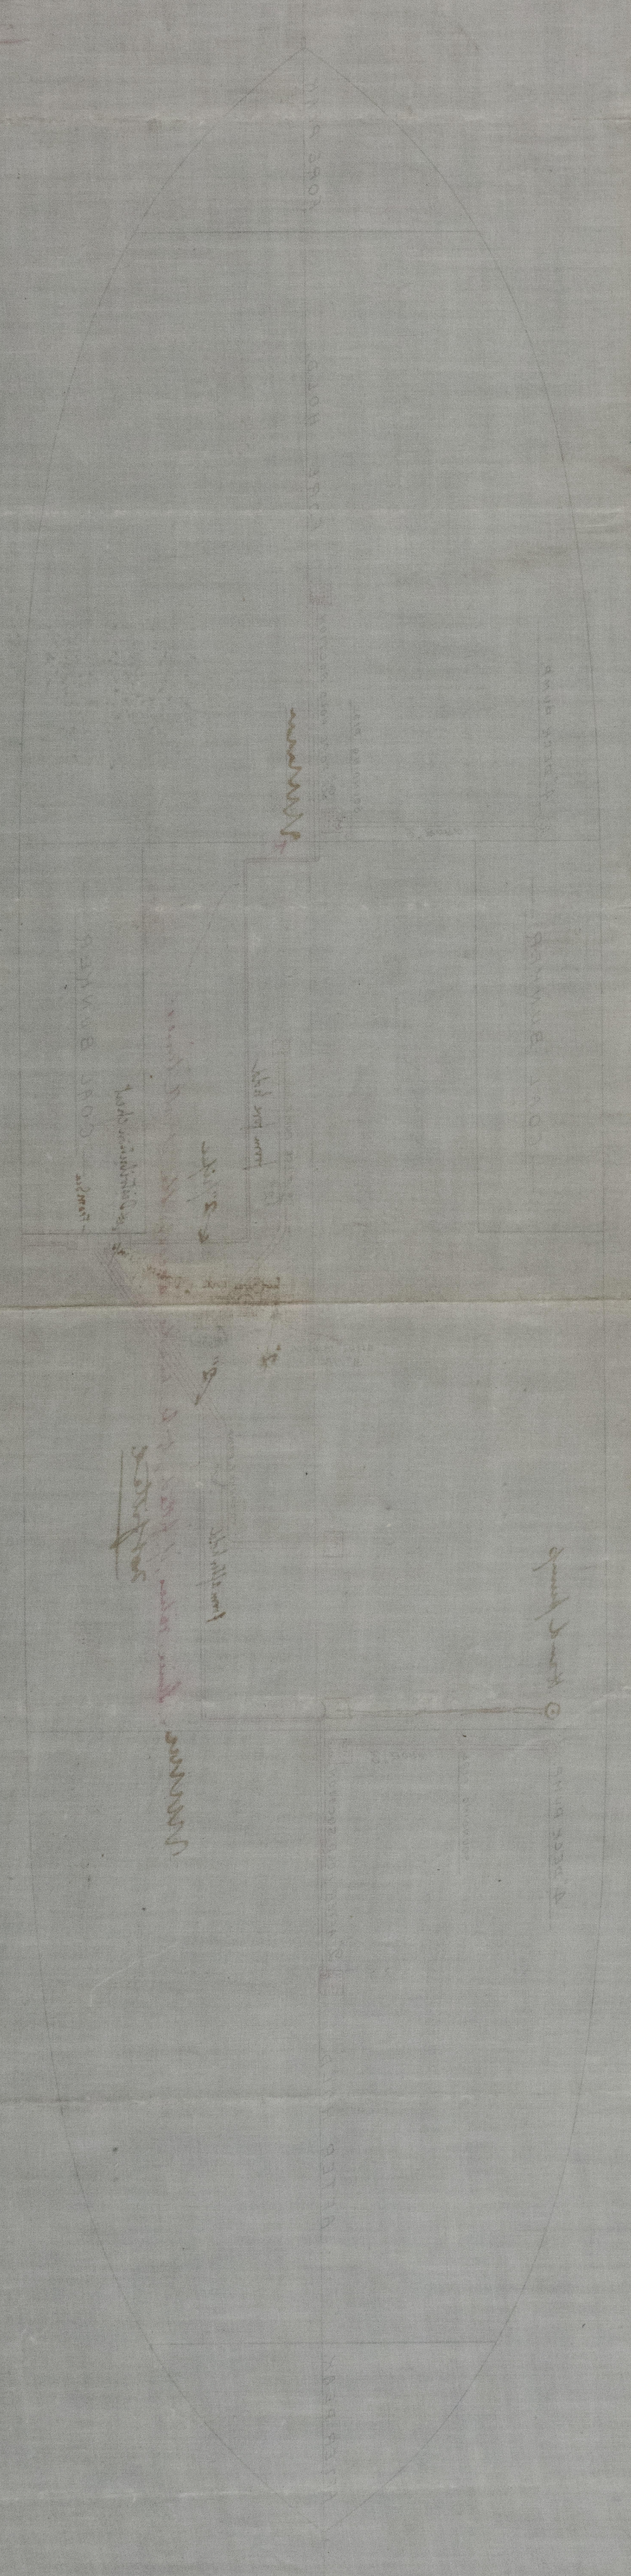

"Arvon" Glasgow Report No. 14228.

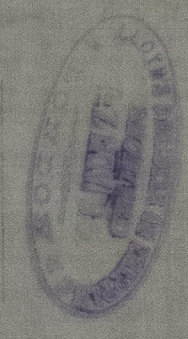

29 Dec 1900


1000

9110-55574

