



27. 8. 95

SECTION IN WAY OF QUARTER DECK

S. S. N° 116


SCALE 1/2" = ONE FOOT

TO CLASS 100A





RAISED QUARTER DECK 4 FT. HIGH
TOPGALLANT FORECASTLE 6 -



SECTION IN WAY OF MAIN DECK

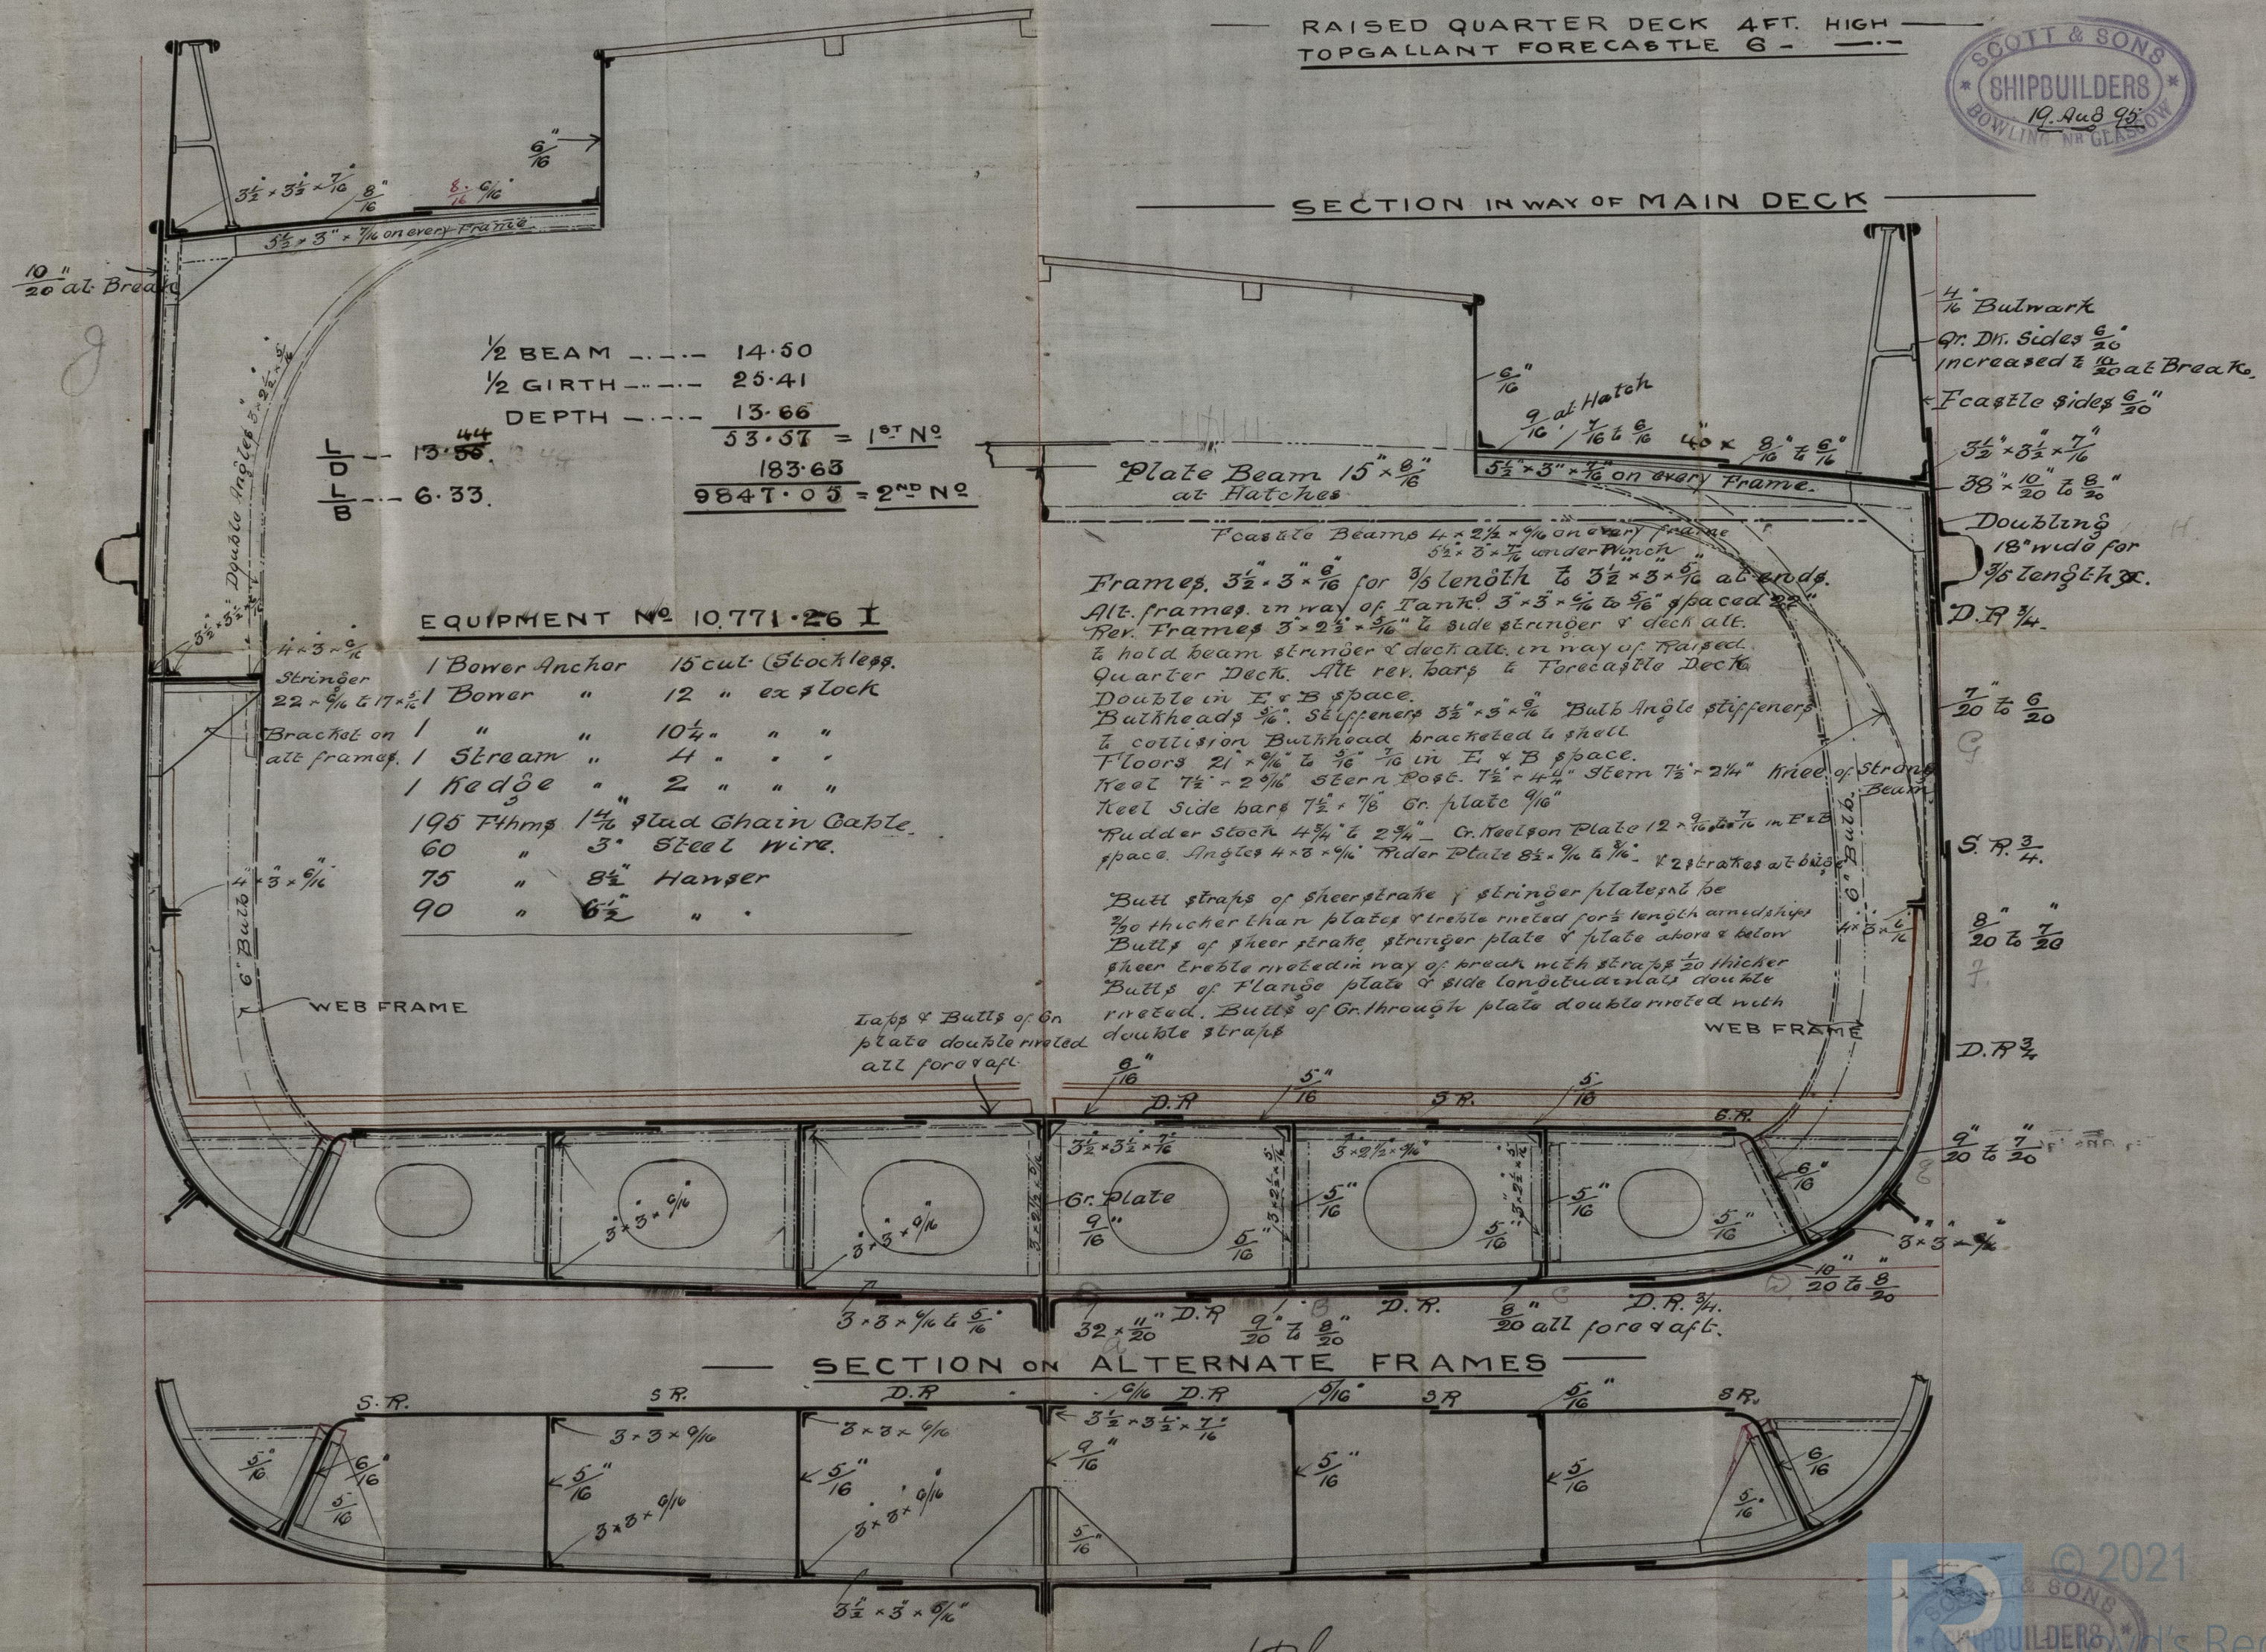

GLS 252-0129

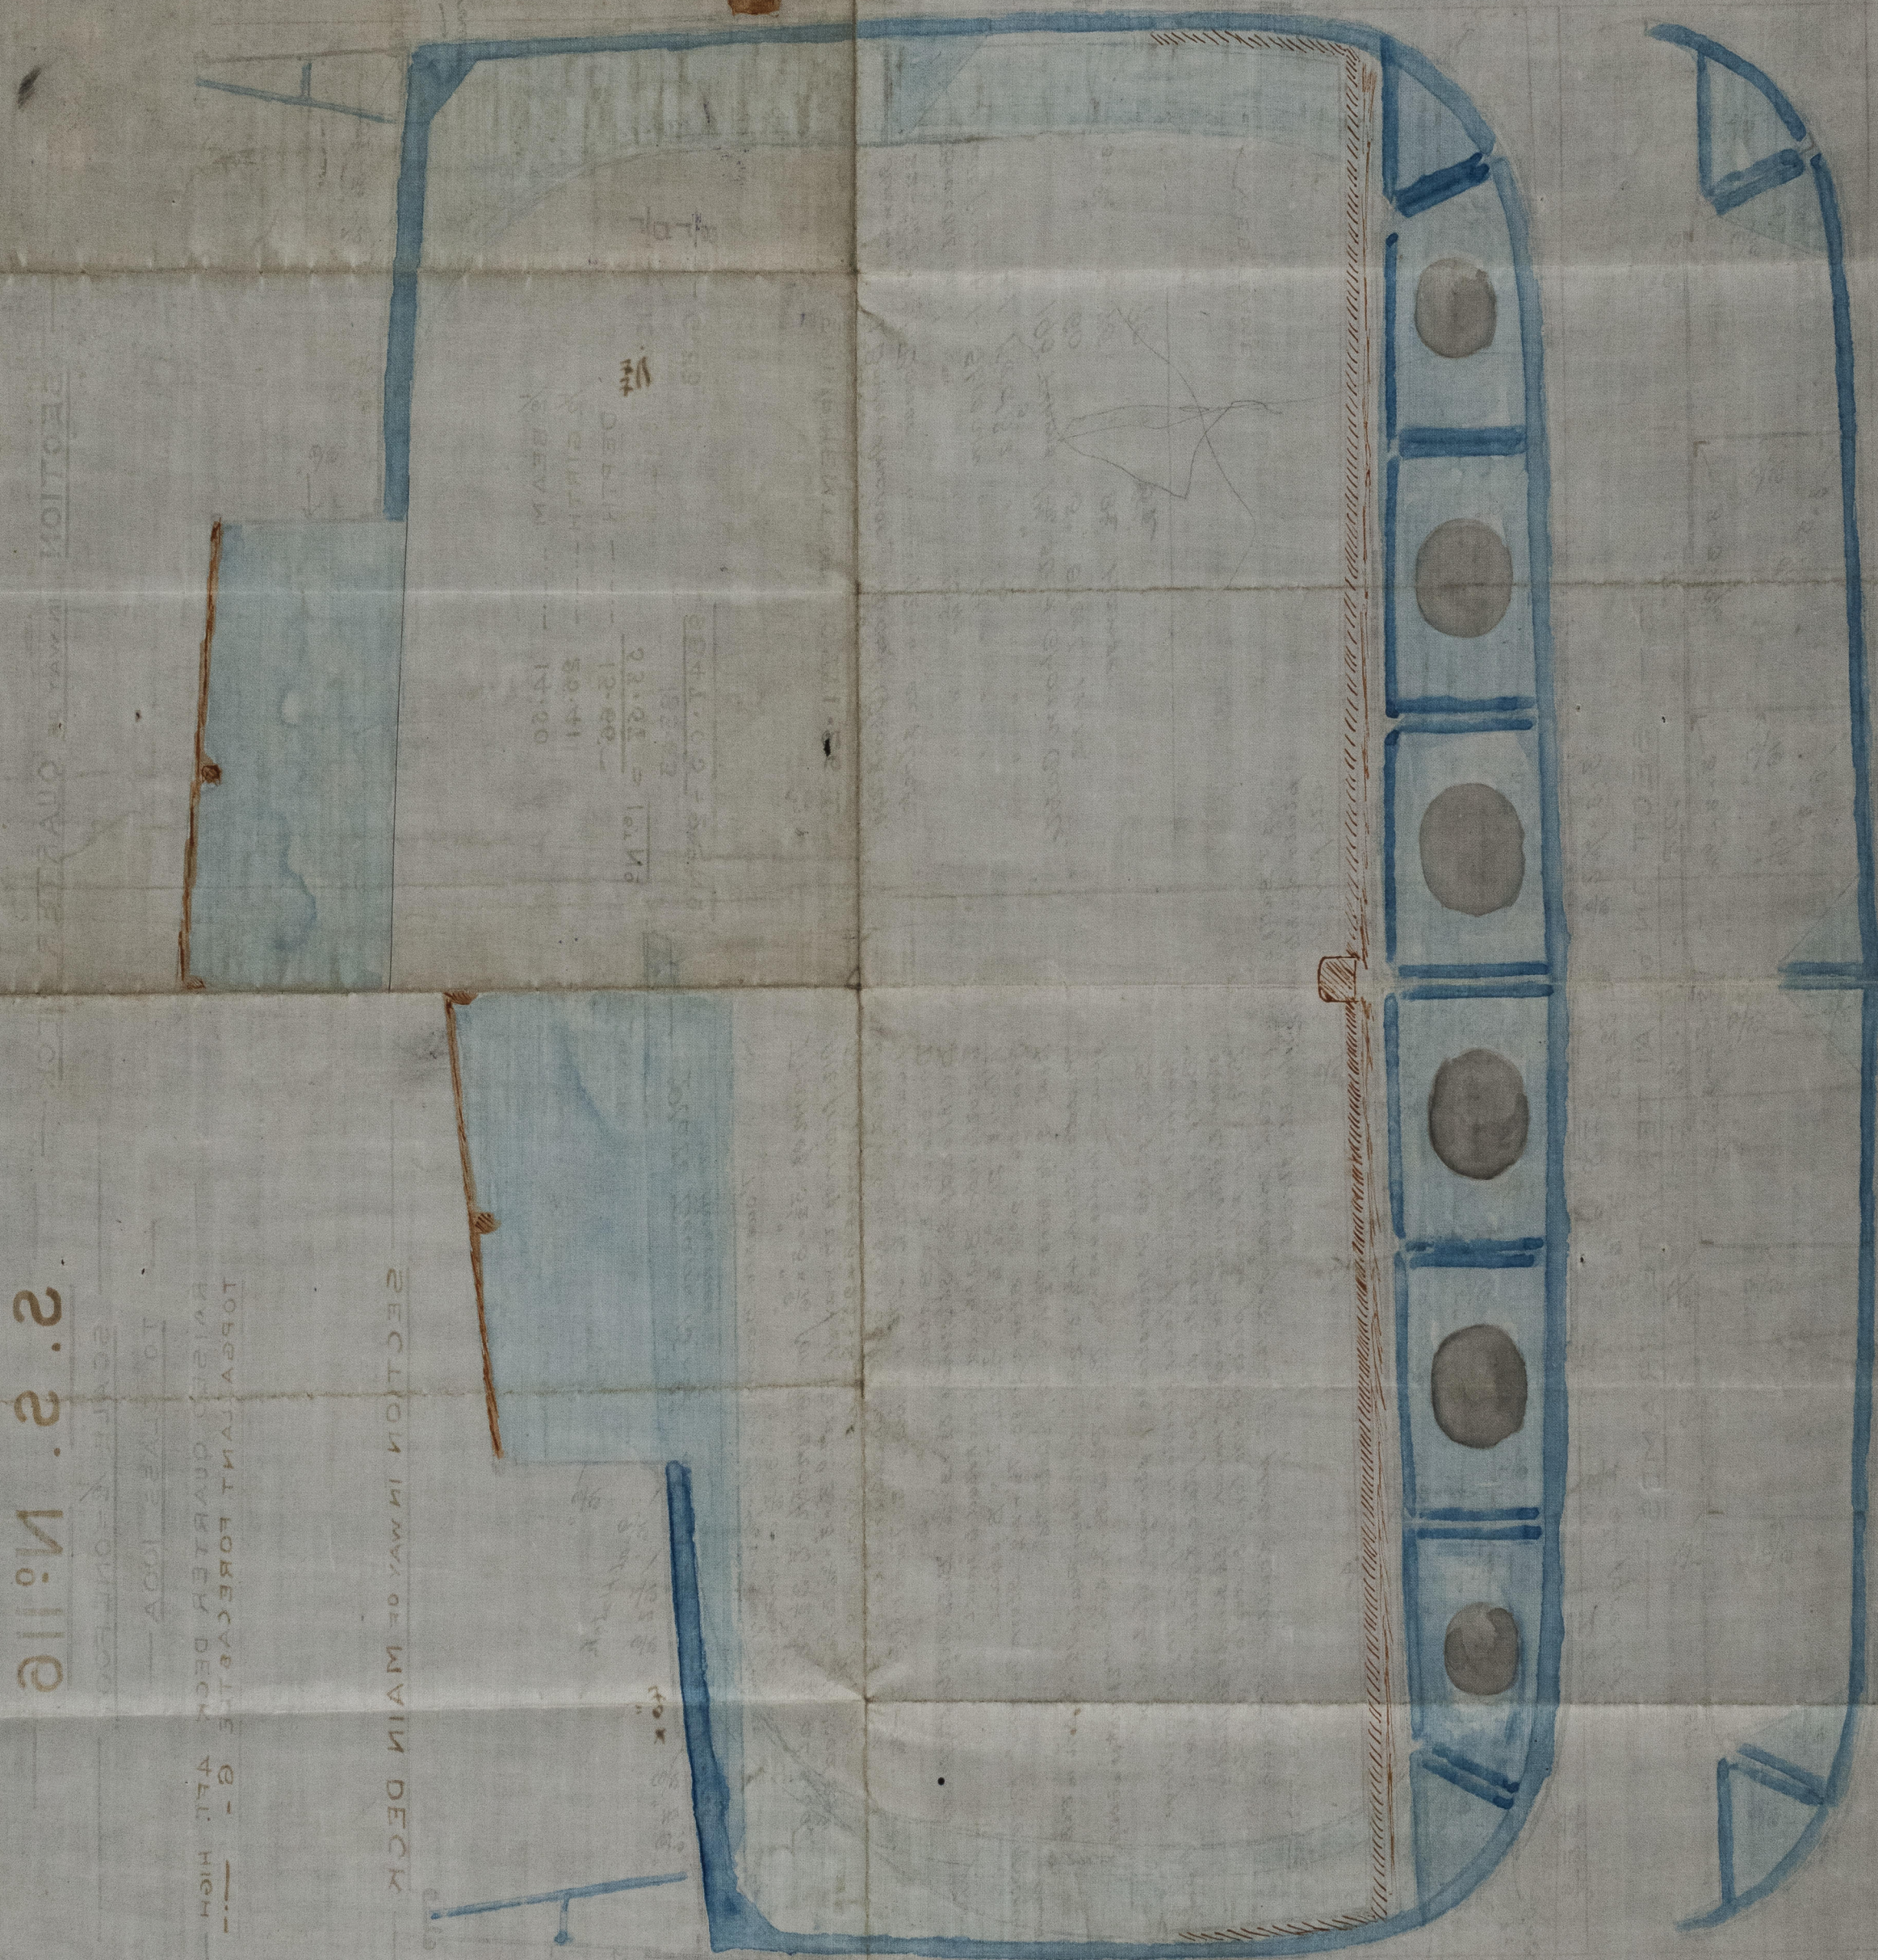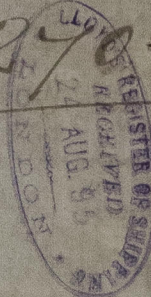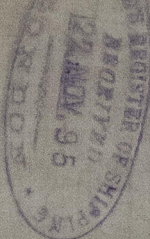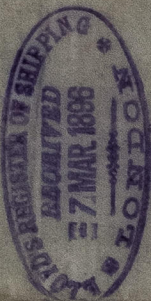

2
 2
 2
 2
 2

SECTION IN WAY OF MAIN DECK

