


8 & 9 "Kohite" Report 11 & 12 p.

# PUMPING PLAN

S. S. N<sup>o</sup> 116.

SCALE  $\frac{1}{4}$ " = ONE FOOT

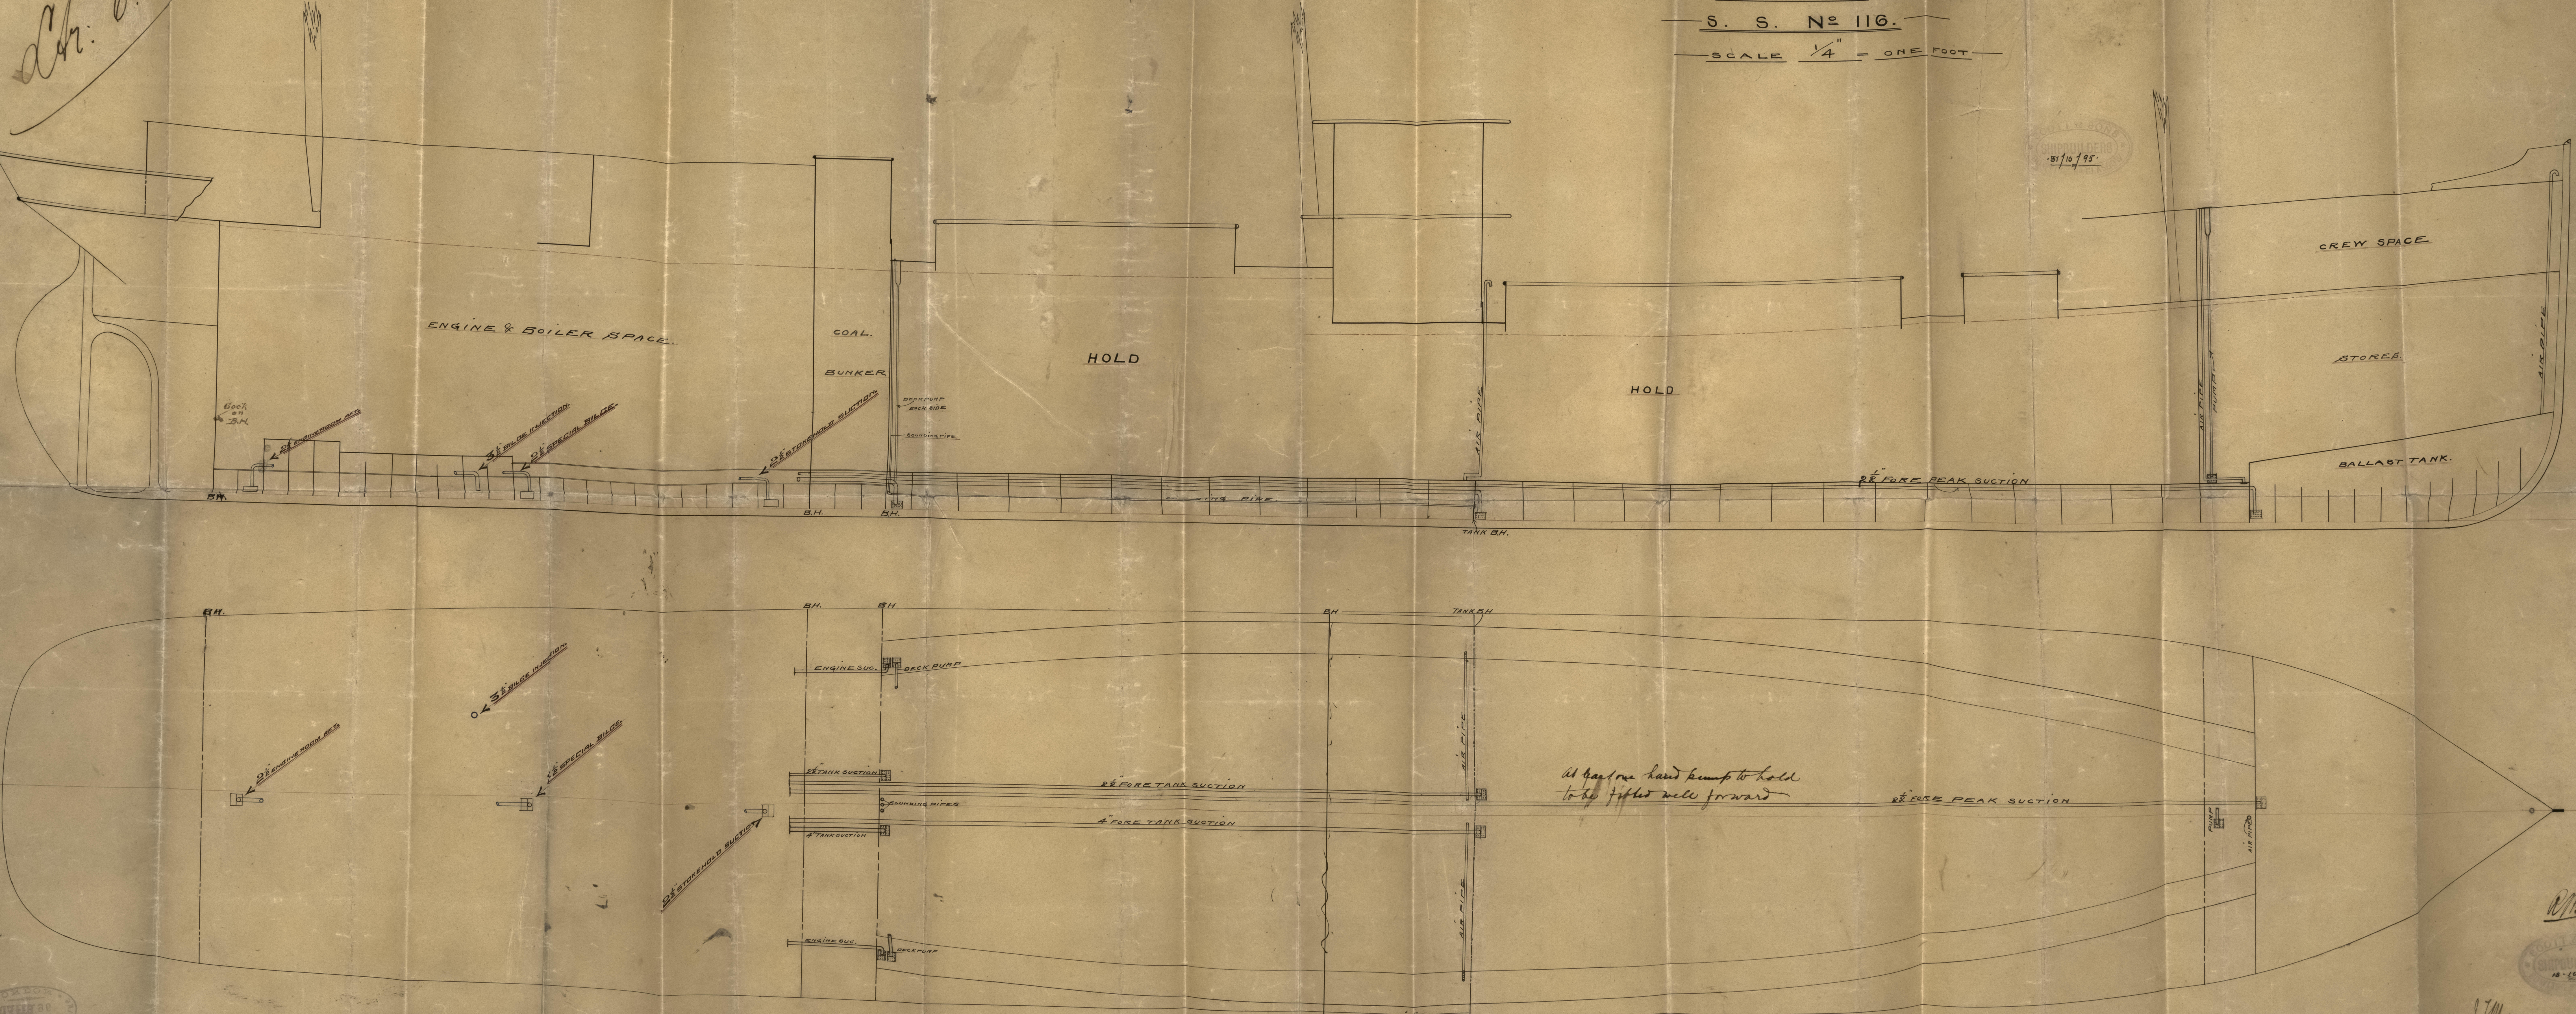



31 / 10 / 95

J. M. ...  
5/11/95



GLS252-0131



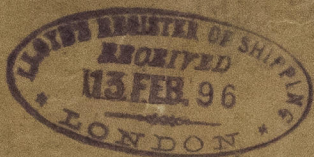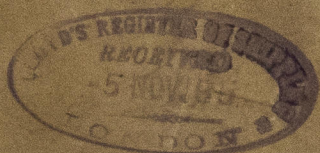

© 2021

Lloyd's Register  
Foundation