

Lloyd's Register of British and Foreign Shipping.

(Report on Vessel No. 14240 Port Glasgow)
"Nephrite"

No. 5046 SHIP FORGINGS OR CASTINGS.

The words FORGINGS or CASTINGS, IRON or STEEL, should be struck out as may be required.

I have to report that the undermentioned Iron or Steel Forgings or Castings, manufactured by The Harbour Forge Coy of Irvine for the Vessel No. 116, being built by Messrs Scott & Sons of Bowling have been inspected by me as set forth below, and found to be, so far as can be seen, Sound & efficient

Mark on Forgings.


Lloyd's
 No. 5046
W.H.

William Hamilton
Glasgow

16/10/95

| | STERN FRAME. | RUDDER FRAME. | STEM & Bulb bar |
|------------------------|-------------------------------|---------------|----------------------|
| Material* | <u>Scrap iron</u> | | <u>Scrap iron</u> |
| How made | <u>Forged</u> | | <u>Forged</u> |
| Dimensions | <u>7 1/2 + 4 1/4</u> | | <u>7 1/2 + 2 1/4</u> |
| Progress on Inspection | <u>Forging & smithing</u> | | <u>Forging</u> |
| Date when Inspected | <u>6/9/95 to 14/10/95</u> | | <u>19. 23/8/95</u> |

SKETCHES OF FRAMES SHOWING POSITION AND DESCRIPTION OF WELDS OF FORGINGS, OR PARTICULARS OF TESTS APPLIED TO CASTINGS.

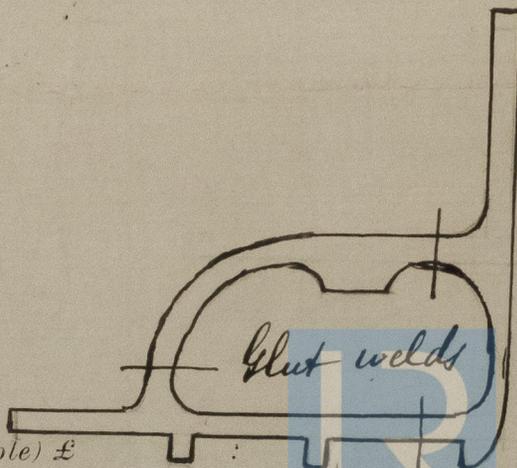

Fee (if any chargeable) £

To be paid at

* If of Iron, state whether scrap or puddled Iron.

