


T.S.S. N^{os} 394-5

4 396 ⁴ appo. 6/8/96
4 398 appo. 3/9/96
N^o 63

SCALE HALF SIZE

16 4 96
27 4 96
6 8 96 (396 ⁴%)
3 9 96 (398.)

$\frac{7}{8}$ " RIVETS

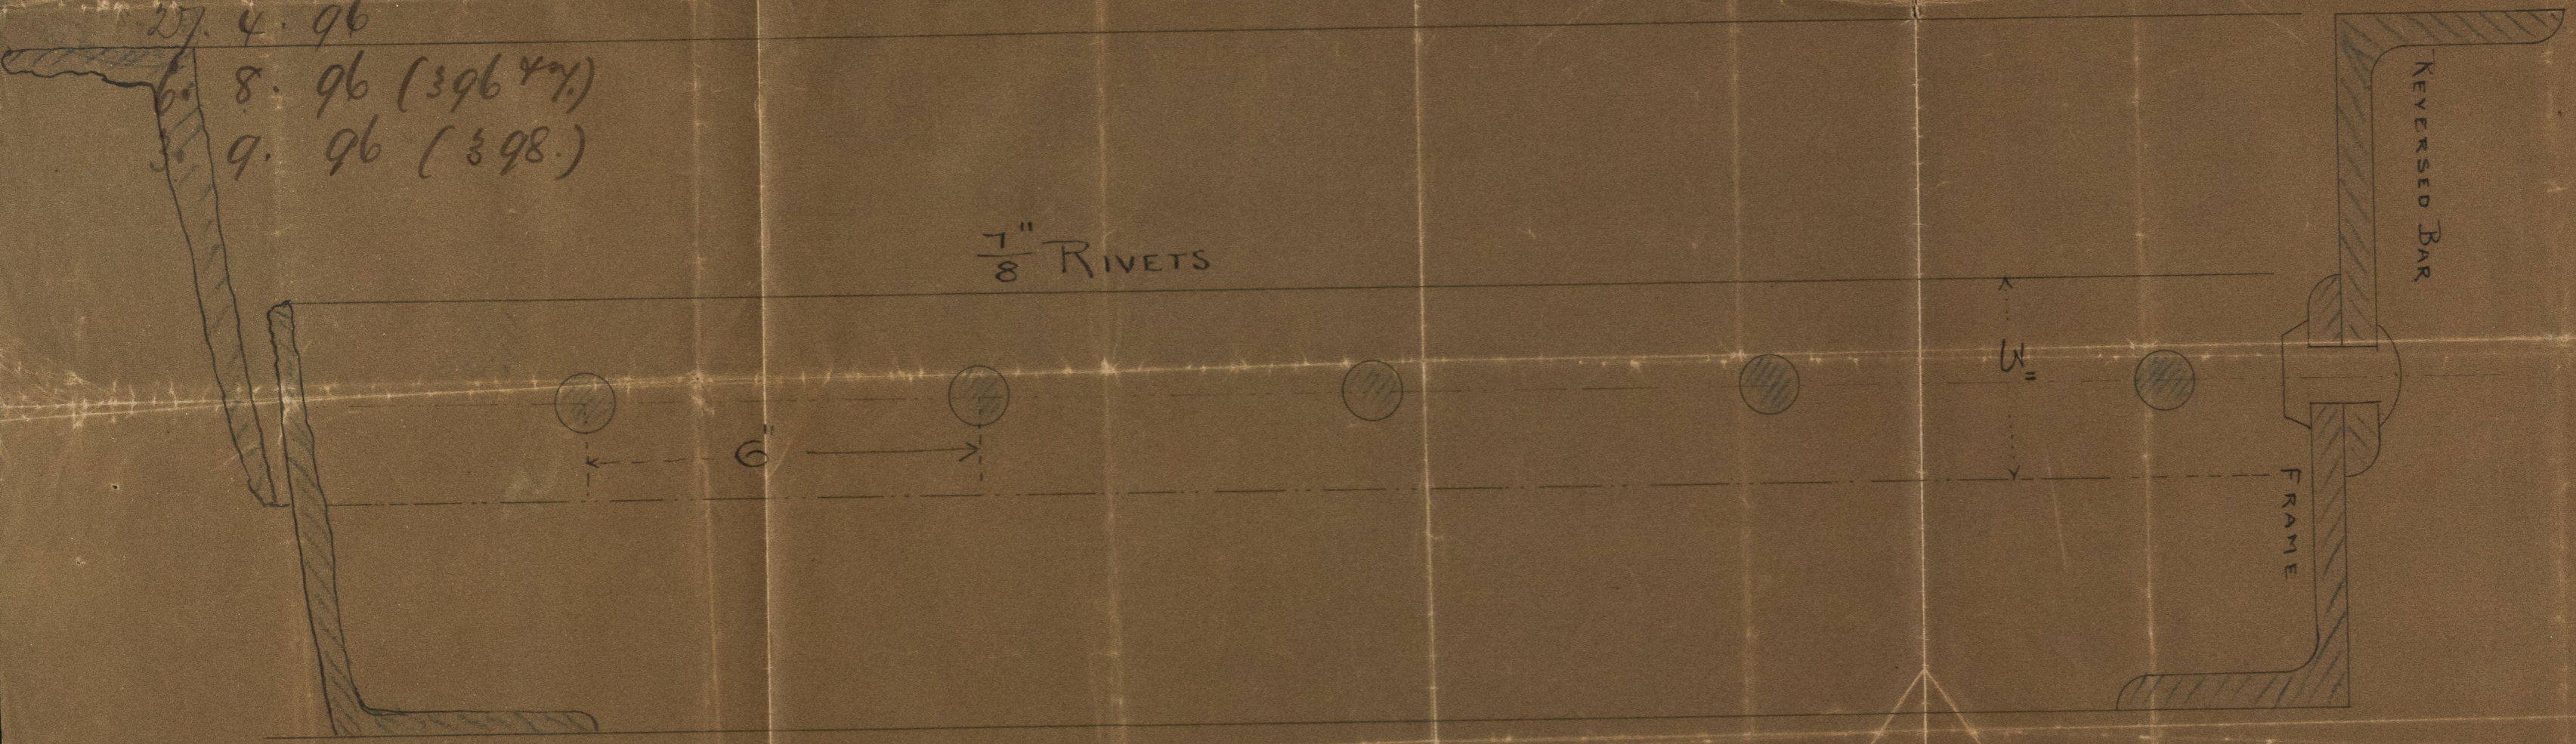

© 2021
Lloyd's Register
Foundation

S.S. Kanagawa Maru Glasgow Report No. 14840
 S.S. Hakata Maru do do
 S.S. Wakasa Maru do do
 S.S. Inaba Maru do do

394 5, 6, 7, 15019
 do " 15163
 do " 15122

RECEIVED
 APR. 96

RECEIVED
 24 APR. 96

RECEIVED
 - 2 SEP. 1896
 LONDON



© 2021

Lloyd's Register Foundation